

R.D.

8/23/79
a.m. if possible

PERMIT

P 30110

A Repair

SEWAGE DISPOSAL SYSTEM

MARYLAND STATE DEPARTMENT OF HEALTH

HOWARD COUNTY

04-321758

ELLICOTT CITY

DISTRICT 4th

INDEXED

DATE 8/22/79

Arnold Septic Tank Service

IS PERMITTED TO INSTALL ALTER X

ADDRESS Woodbine, Maryland 21797 PHONE 795-7873

SUBDIVISION ROAD 1461 Old Annapolis Road LOT

PROPERTY OWNER Mr. Joseph C. Lutz

ADDRESS 1461 Old Annapolis Road, Woodbine, Md. 21797 *off. St. Michaels R.*

SPECIFICATIONS

- SEPTIC TANK CAPACITY _____ GALLONS
- DRAIN FIELD _____ DEPTH _____ FEET, BOTTOM AREA _____ SQ. FT.
- DEEP TRENCH _____ DEPTH _____ FEET, BOTTOM AREA _____ SQ. FT.
- SEEPAGE PITS _____ ABSORBENT SIDE-WALL AREA _____ SQ. FT.
- INLET PIPE _____ FT. BELOW ORIGINAL GRADE, MAXIMUM DEPTH _____ FT. BELOW ORIGINAL GRADE
- EFFECTIVE DEPTH AT _____ FT. BELOW ORIGINAL GRADE.
- LOCATE DISPOSAL AREA _____ FT. FROM _____ LOT LINE AND _____ FT. FROM _____ LOT LINE AS SEEN WHEN FACING LOT FROM

DRY WELL - To be 15 x 15 square in excavation. Effective absorbent area between 5½ to 12½ ft. below ~~original~~ original grade. Locate in perc hole 1 & 2 - 24 ft. off right property line and at least 10 ft. off septic tank and ~~farther~~ farthest from house when facing lot from Old Annapolis Road. Inlet pipe off distribution box from line off septic tank. Use both dry wells.


PLANS APPROVED BY Charles B. Streaker DATE 8/20/79

- COVER NO WORK UNTIL INSPECTED AND APPROVED.
- NEITHER THE HOWARD COUNTY COUNCIL NOR THE HEALTH DEPARTMENT IS RESPONSIBLE FOR THE SUCCESSFUL OPERATION OF ANY SYSTEM.
- NOTE: IF TRENCH IS USED CALL FOR INSPECTION BEFORE PLACING GRAVEL IN TRENCH.
- NOTE: NO DRY WELL SHALL EXCEED 15 FOOT IN DIAMETER.
- NOTE: ALL PIPE FROM HOUSE TO DISPOSAL AREA MUST BE CAST IRON.
- PERMIT VOID AFTER THREE YEARS.
- NOTE: INSTALL STAND PIPE ON SEPTIC TANK AND DRY WELL. STAND PIPES MUST BE 6 INCHES IN DIAMETER. CAST IRON, CONCRETE OR TERRA COTTA ACCEPTED.

***INSTALLER IS RESPONSIBLE FOR OBTAINING FINAL APPROVAL ON THIS PERMIT.**

BLDG. PERMIT SIGNED
AND RETURNED *8/1/91*
Serial # 39134
addition

P 30110

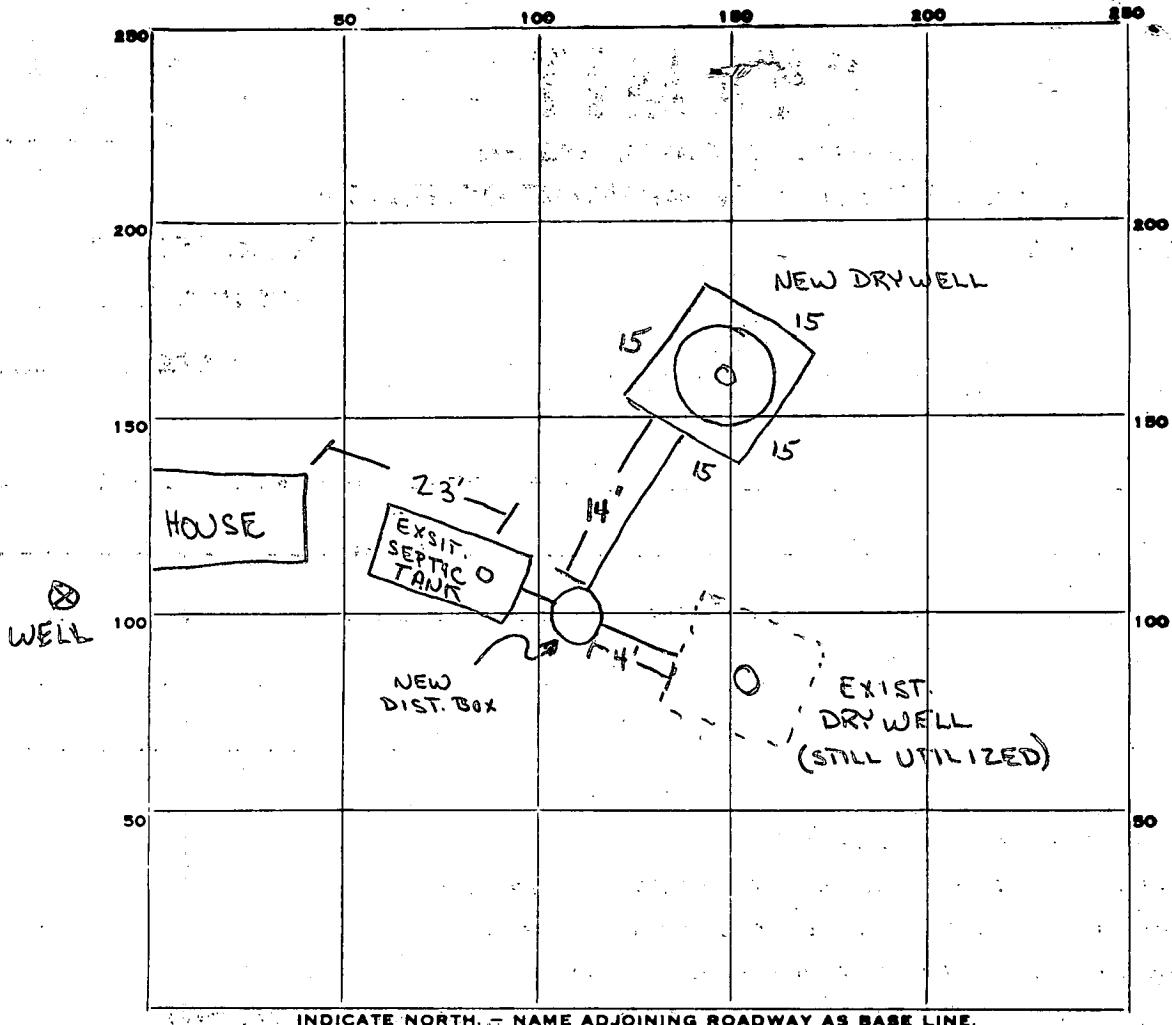

PERMIT CARD NONE

SEPTIC TANK, LEVEL _____ CLEANOUTS CAST IRON

DISTRIBUTION BOX, LEVEL

TILE FIELD, DEPTH _____ FT. TRENCH WIDTH _____ FT.

GRAVEL DEPTH _____ IN. TOTAL LENGTH _____ FT.

NUMBER OF TRENCHES _____ TOTAL BOTTOM AREA _____

SEEPAGE PITS, INSIDE DIAMETER 60 FT. DEPTH BELOW INLET 7 FT.

ABSORBENT AREA 420 SQ. FT.

60
7
420

REMARKS 8/23/79 - OK TO COVER ALL WORK R.D.

DATE SYSTEM APPROVED 8/23/79 INSPECTOR R. De Marco

APPLICATION

SEWAGE DISPOSAL TESTING

STATE OF MARYLAND - DEPARTMENT OF HEALTH AND MENTAL HYGIENE

HOWARD COUNTY HEALTH DEPARTMENT
ENVIRONMENTAL HEALTH SERVICES

P.O. BOX 476 ELLICOTT, MARYLAND 21043
TELEPHONE: 992-2330

{ Existing Septic Tank N/A }

A _____

P Repair Per

DISTRICT 4th

DATE 8/17/79

(1) Dry well to be 15' x 15' in excavation
Effective absorbent area between
5 1/2' - 12 1/2' below original grade. Location
Per hole (1+2) = 24' off right property line
and at least 10' off septic tank and farthest from house.
when facing lot from Old Annapolis Road.

Inlet pipe off
Dirt Box from line
off septic tank
Use both
dry wells.

TO: THE COUNTY HEALTH OFFICER
ELLICOTT CITY, MARYLAND

I HEREBY APPLY FOR THE NECESSARY TEST IN ORDER TO CONSTRUCT (OR RECONSTRUCT) A SEWAGE DISPOSAL SYSTEM.

PROPERTY OWNER Joseph C. Kotz

ADDRESS 1461 Old Annapolis Road, Woodlawn, Md. PHONE Bud Arnold - 795-7873

PROPERTY LOCATION:

SUBDIVISION _____ LOT NO. _____

ROAD AND DESCRIPTION 1461 Old Annapolis Road - Route 144 to St. Michael's Road - Turn left off St. Michael's onto Old Annapolis Road.

SIZE OF LOT ? TYPE BLDG. Existing 3 Bedroom House per Mrs Kotz.

THE SYSTEM INSTALLED UNDER THIS APPLICATION IS ACCEPTABLE ONLY UNTIL PUBLIC FACILITIES BECOME AVAILABLE.

I FULLY UNDERSTAND THE FEE CONNECTED WITH THE FILING OF THIS PERC TEST APPLICATION IS NON-REFUNDABLE UNDER ANY CIRCUMSTANCES.

SIGNATURE OF APPLICANT 1st Bud Arnold for Joseph C. Kotz

APPROVED BY C. B. Steakin FOR Dry Well DATE 8/20/79

REJECTED BY _____ FOR _____ DATE _____


HOLD PENDING FURTHER TESTS _____ DATE _____

REASONS FOR REJECTION OR HOLDING _____


THIS IS NOT A PERMIT

OLD ANNAPOLIS ROAD

BEG.
LIBER 309~376

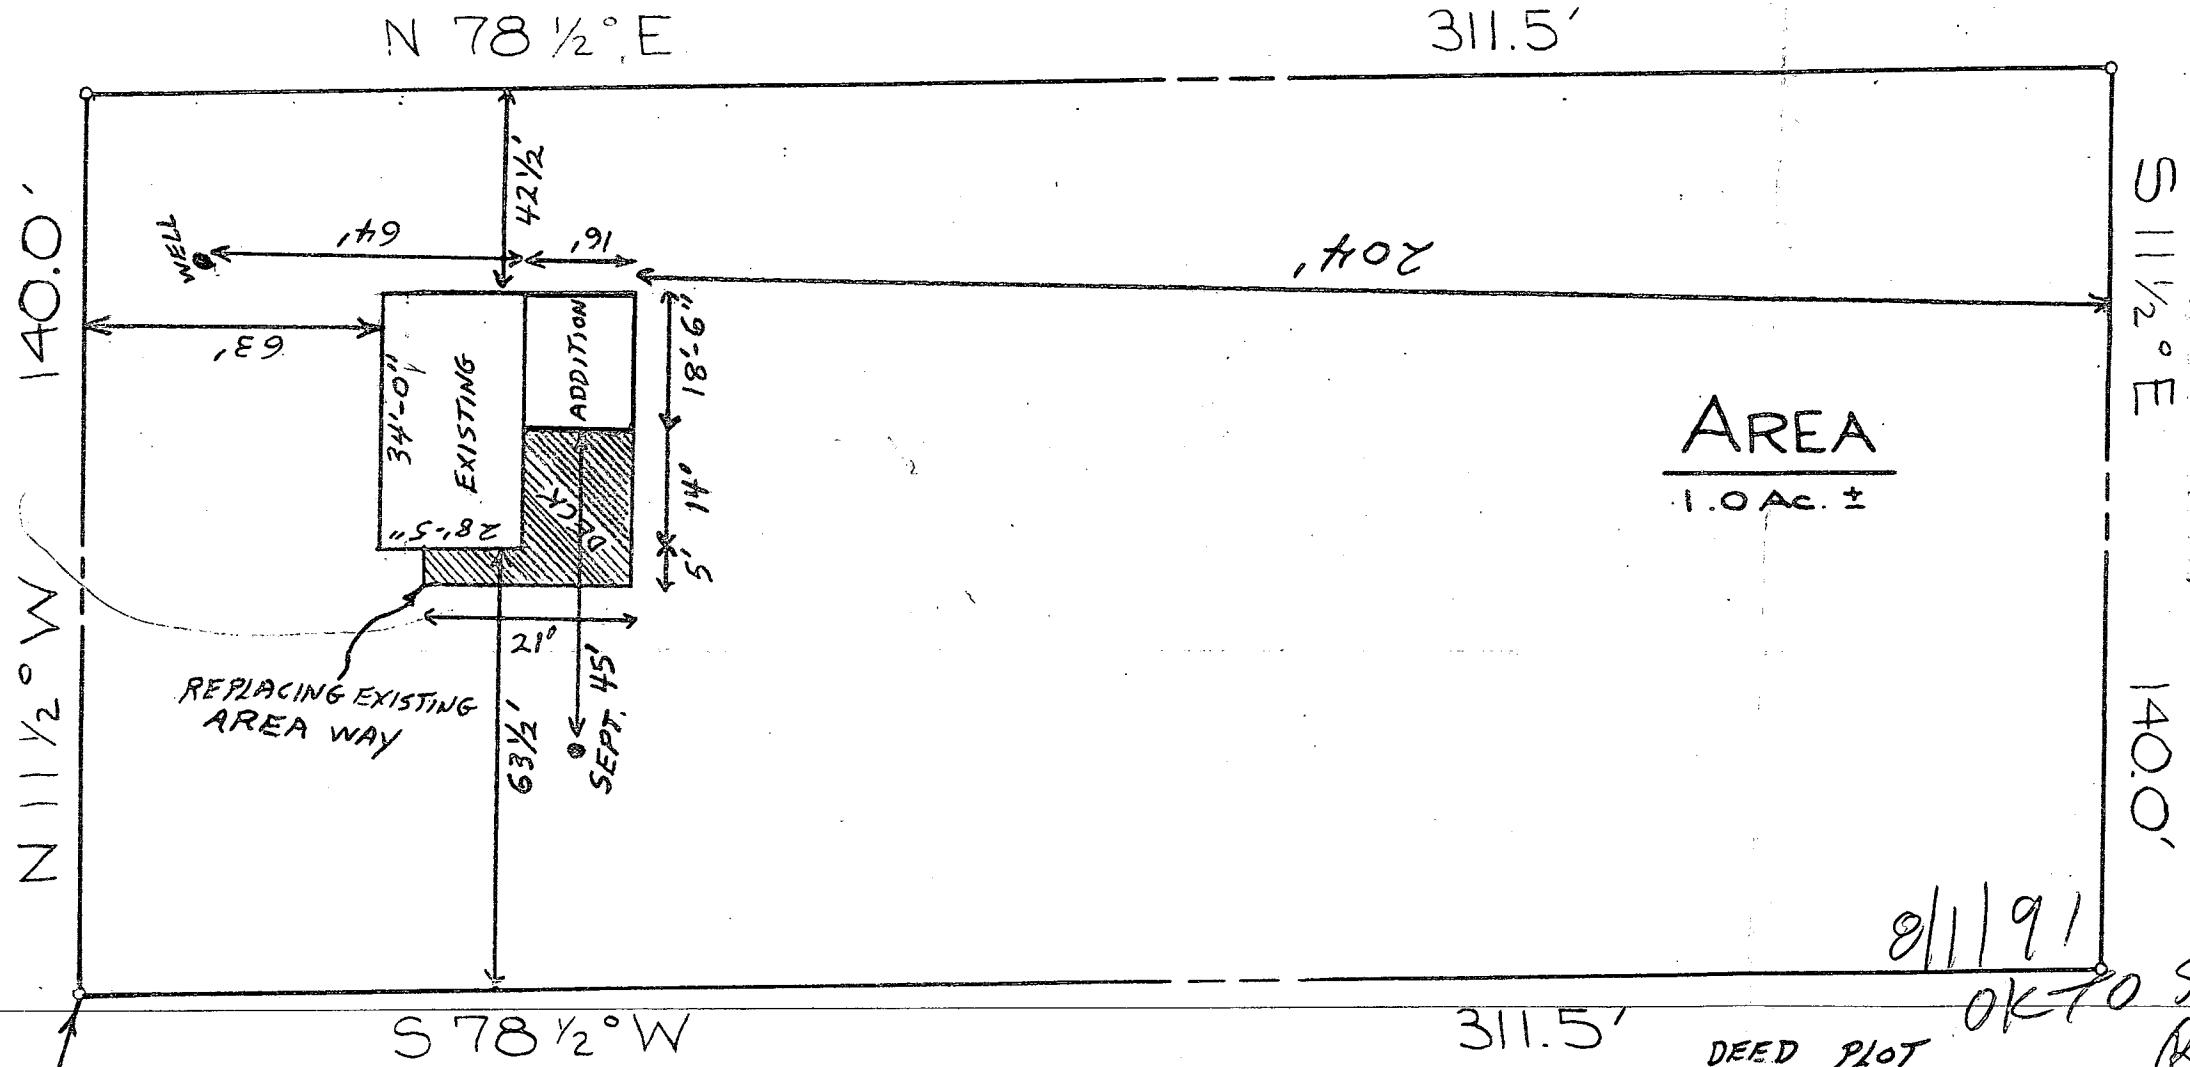

AREA
1.0 Ac. ±

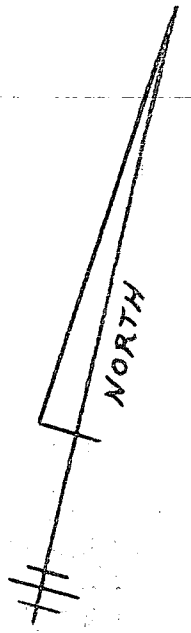

311.5' DEED PLOT OF LUTZ PROPERTY
 EAST SIDE OF OLD ANNAPOLIS RD
 4TH ELECTION DISTRICT; HOWARD CO., MD.

8/1/91
 OK TO SIGN
 BH