

9/18/79
late afternoon or
9/19/79 early a.m.

Approved
9/21/79 RH P 30181

PERMIT

SEWAGE DISPOSAL SYSTEM

A REPAIR

MARYLAND STATE DEPARTMENT OF HEALTH*

HOWARD COUNTY

ELLICOTT CITY

DISTRICT 2nd

02-213737
INDEXED

DATE 9/13/79

Joseph Neubauer IS PERMITTED TO INSTALL ALTER

ADDRESS Elkridge, Md. PHONE 744-4158

SUBDIVISION _____ ROAD 8105 Forest Hill Drive LOT _____

Rt. 40 to Chestnut Hill Drive to Forest Hill

PROPERTY OWNER Howard H. Grove

ADDRESS 8105 Forest Hill Drive, Ellicott City, Md.

SPECIFICATIONS 3 bedrooms

SEPTIC TANK CAPACITY 1000 GALLONS

DRAIN FIELD _____ DEPTH _____ FEET, BOTTOM AREA _____ SQ. FT.

DEEP TRENCH _____ DEPTH _____ FEET, BOTTOM AREA _____ SQ. FT.

SEEPAGE PITS _____ ABSORBENT SIDE-WALL AREA _____ SQ. FT.

INLET PIPE _____ FT. BELOW ORIGINAL GRADE. MAXIMUM DEPTH _____ FT. BELOW ORIGINAL GRADE

EFFECTIVE DEPTH AT _____ FT. BELOW ORIGINAL GRADE.

LOCATE DISPOSAL AREA _____ FT. FROM _____ LOT LINE AND _____ FT. FROM _____ LOT LINE AS SEEN WHEN

FACING LOT FROM

~~REPAIR - CALL FOR INSPECTION WHEN GROUND IS OPENED UP SO SANITARIAN CAN RECOMMEND~~

REPAIR. REPLACE TANK ONLY

Same type cleanout approved as previously existed for 6-8 yrs. Frommelt.

PLANS APPROVED BY Palmer F. Wine DATE 9/13/79

COVER NO WORK UNTIL INSPECTED AND APPROVED.

NEITHER THE HOWARD COUNTY COUNCIL NOR THE HEALTH DEPARTMENT IS RESPONSIBLE FOR THE SUCCESSFUL OPERATION OF ANY SYSTEM.

NOTE: IF TRENCH IS USED CALL FOR INSPECTION BEFORE PLACING GRAVEL IN TRENCH.

NOTE: NO DRY WELL SHALL EXCEED 15 FOOT IN DIAMETER.

NOTE: ALL PIPE FROM HOUSE TO DISPOSAL AREA MUST BE CAST IRON.


PERMIT VOID AFTER THREE YEARS.

NOTE: INSTALL STAND PIPE ON SEPTIC TANK AND DRY WELL. STAND PIPES MUST BE 6 INCHES IN DIAMETER. CAST IRON, CONCRETE OR TERRA COTTA ACCEPTED.

*INSTALLER IS RESPONSIBLE FOR OBTAINING FINAL APPROVAL ON THIS PERMIT.

P 30181

HATFIELD
 MEVING
 30191

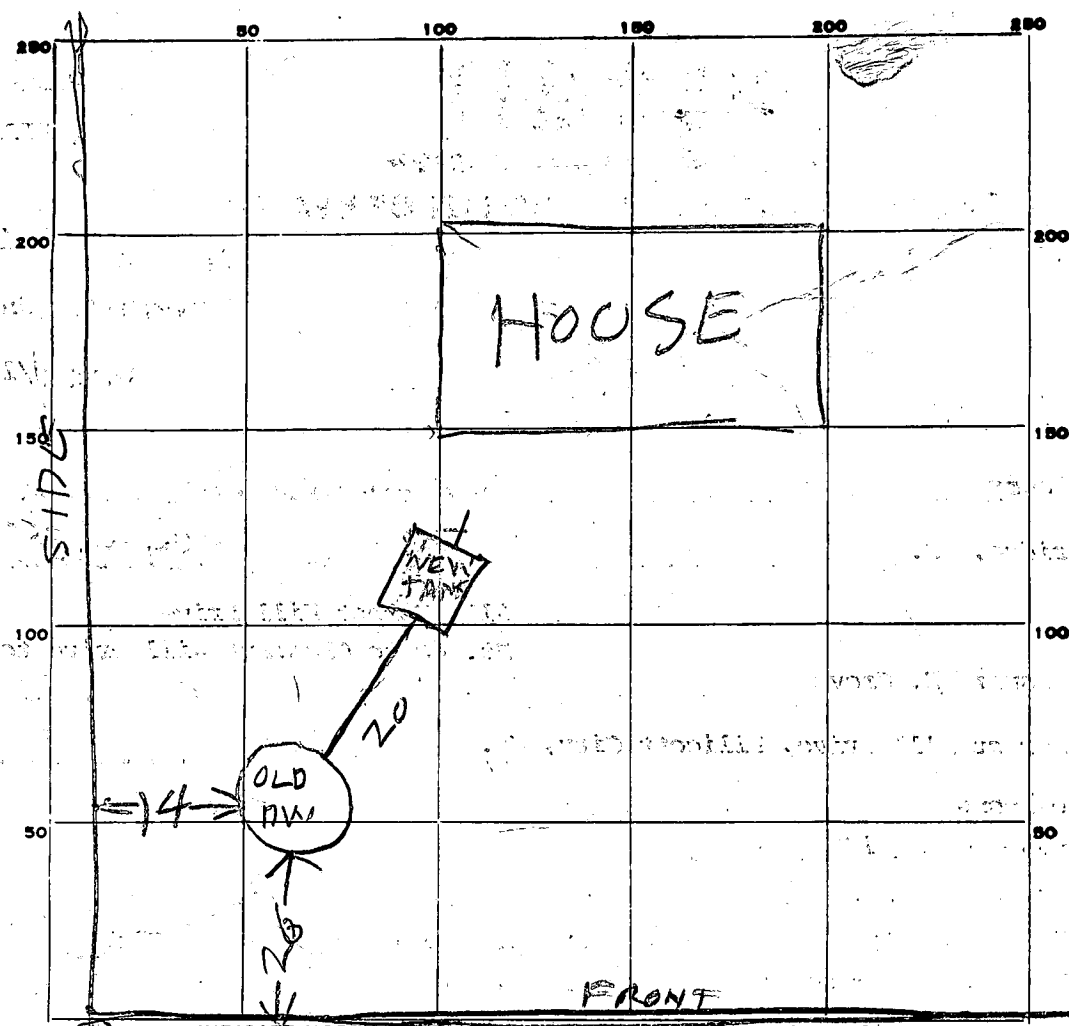

INDICATE NORTH - NAME ADJOINING ROADWAY AS BASE LINE.
 FOREST HILL DR

PERMIT CARD _____

SEPTIC TANK, LEVEL OK 1000 CLEANOUTS MANHOLE NEEDED
 DISTRIBUTION BOX, LEVEL 7 FT BELOW GRADE

TILE FIELD, DEPTH _____ FT. TRENCH WIDTH _____ FT.

GRAVEL DEPTH _____ IN. TOTAL LENGTH _____ FT.

NUMBER OF TRENCHES _____ TOTAL BOTTOM AREA _____

SEEPAGE PITS, INSIDE DIAMETER _____ FT. DEPTH BELOW INLET _____ FT.

ABSORBENT AREA _____ SQ. FT.

REMARKS 9/19/79 NEW CONCRETE TANK INSTALLED TO REPLACE
OLD RUSTED STEEL TANK. CITY WATER HERE. INSTALL
MANHOLE ON TANK & CLEANOUT ON DW & CALL. OK TO
COVER SEWER LINE RH 9/20/79 CLEANOUTS PUT ON
TANK & DRY WELL BUT NOT MANHOLE TFF SAID
MANHOLE NOT NEEDED IN THIS CASE ON 9/21/79

DATE SYSTEM APPROVED 9/21/79 INSPECTOR Raymond Hodges