

2/11/80
~~between 9:30 and 10:00 A.M.~~
cancelled
2/13/80
2/19/80

APPROVED
2/19/80
P 30184
R14

PERMIT

SEWAGE DISPOSAL SYSTEM

MARYLAND STATE DEPARTMENT OF HEALTH*

HOWARD COUNTY

9:30 A.M.

03-279308

A REPAIR

ELLICOTT CITY

DISTRICT 3rd

DATE 9/17/79

INDEXED

Mr. Donald Alexander

IS PERMITTED TO INSTALL ALTER X

ADDRESS _____ PHONE _____

SUBDIVISION Evergreen Valley Estates ROAD 3101 Evergreen Way LOT 27, Sec.4

PROPERTY OWNER Mr. Donald Alexander

ADDRESS same as above

SPECIFICATIONS 4 bedrooms

SEPTIC TANK CAPACITY 1250 GALLONS

DRAIN FIELD _____ DEPTH _____ FEET, BOTTOM AREA _____ SQ. FT.

DEEP TRENCH _____ DEPTH _____ FEET, BOTTOM AREA _____ SQ. FT.

SEEPAGE PITS _____ ABSORBENT SIDE-WALL AREA _____ SQ. FT.

INLET PIPE _____ FT. BELOW ORIGINAL GRADE, MAXIMUM DEPTH _____ FT. BELOW ORIGINAL GRADE

EFFECTIVE DEPTH AT _____ FT. BELOW ORIGINAL GRADE.

LOCATE DISPOSAL AREA _____ FT. FROM _____ LOT LINE AND _____ FT. FROM _____ LOT LINE AS SEEN WHEN FACING LOT FROM

REPAIR-CALL FOR INSPECTION WHEN GROUND IS OPENED UP SO SANITARIAN CAN RECOMMEND

REPAIR. DEEP DITCH 2 FT WIDE 10 FT DEEP 5 FT STONE

96 FT LONG, RUN DITCH BETWEEN PERC HOLES

& TIE INTO OLD DRAIN FIELD RH

PLANS APPROVED BY Palmer F. Wine DATE 9/17/79

COVER NO WORK UNTIL INSPECTED AND APPROVED.

NEITHER THE HOWARD COUNTY COUNCIL NOR THE HEALTH DEPARTMENT IS RESPONSIBLE FOR THE SUCCESSFUL OPERATION OF ANY SYSTEM.

NOTE: IF TRENCH IS USED CALL FOR INSPECTION BEFORE PLACING GRAVEL IN TRENCH.

NOTE: NO DRY WELL SHALL EXCEED 15 FOOT IN DIAMETER.


NOTE: ALL PIPE FROM HOUSE TO DISPOSAL AREA MUST BE CAST IRON.

PERMIT VOID AFTER THREE YEARS.

NOTE: INSTALL STAND PIPE ON SEPTIC TANK AND DRY WELL. STAND PIPES MUST BE 6 INCHES IN DIAMETER. CAST IRON, CONCRETE OR TERRA COTTA ACCEPTED.

*INSTALLER IS RESPONSIBLE FOR OBTAINING FINAL APPROVAL ON THIS PERMIT.

P30184

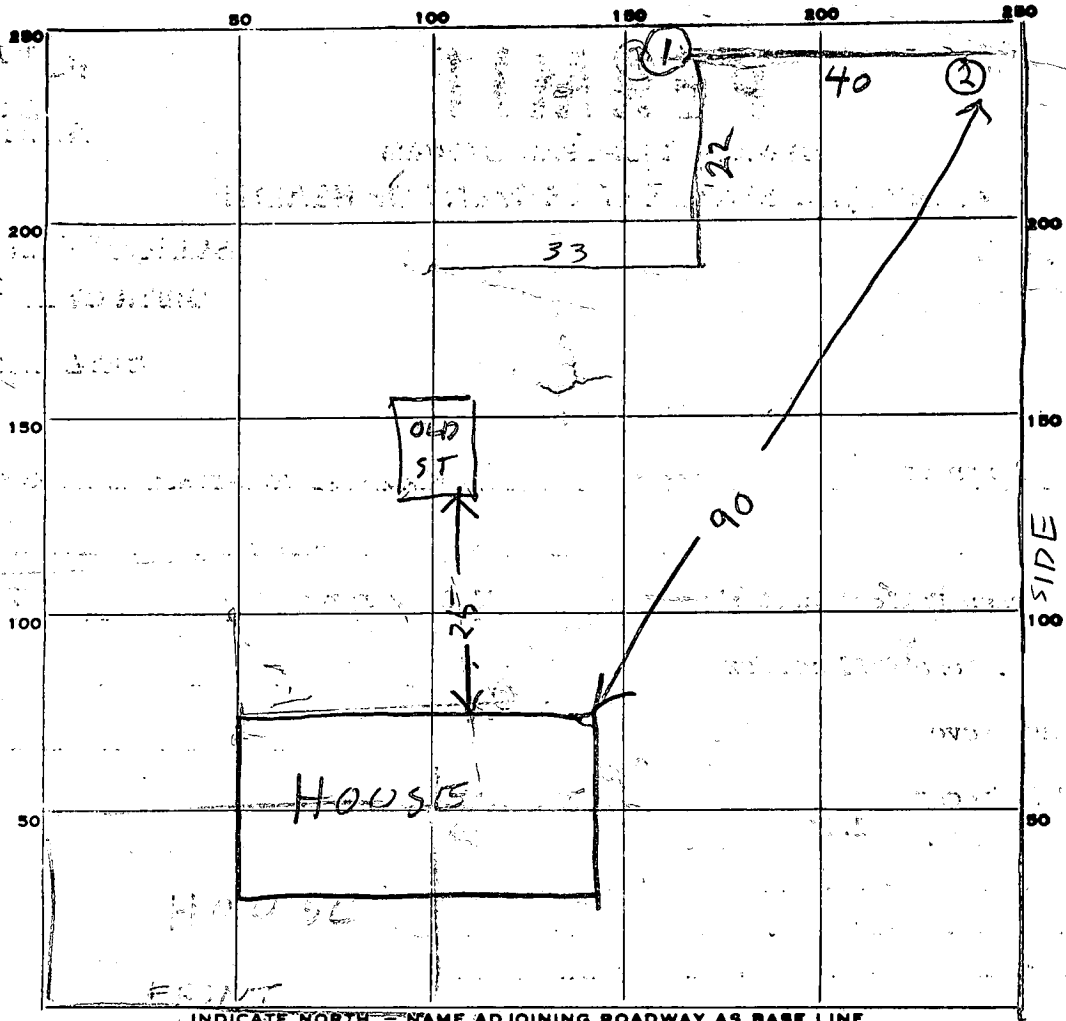

INDICATE NORTH - NAME ADJOINING ROADWAY AS BASE LINE.

PERMIT CARD _____

SEPTIC TANK, LEVEL N/A CLEANOUTS N/A

DISTRIBUTION BOX, LEVEL _____

TILE FIELD, DEPTH 10-12 FT. TRENCH WIDTH 2 FT.

GRAVEL DEPTH 6 5 FT. IN. TOTAL LENGTH 95 FT.

NUMBER OF TRENCHES 1 TOTAL BOTTOM AREA 57 @

SEEPAGE PITS, INSIDE DIAMETER _____ FT. DEPTH BELOW INLET _____ FT.

ABSORBENT AREA _____ SQ. FT.

REMARKS 2/19/80 AM TEST HOLE (1) & (2) DUG SOIL POROUS & DRY

2/19/80 - OWNER MEASURED DEPTH OF DITCH ADD A LITTLE

STONE OVER PIPE & ALSO PAPER OVER STONE RH

2/19/80 - MORE STONE ADDED. INSTALL PAPER & COVER RH

DATE SYSTEM APPROVED 2/19/80 INSPECTOR Raymond Hodge