

Approved 10/30/79

J. [Signature]

10/29/79  
10/30/79

# PERMIT

P 30299

SEWAGE DISPOSAL SYSTEM

A Repair

MARYLAND STATE DEPARTMENT OF HEALTH

HOWARD COUNTY

03-287963

ELLICOTT CITY

DISTRICT 3rd

INDEXED

DATE 10/29/79

Jack Fyock IS PERMITTED TO INSTALL ALTER X

ADDRESS 13775 Triadelphia Road, Glenelg, Md. 21037 PHONE 988-9270

SUBDIVISION Woodmark ROAD 12229 Fawn Haven Court LOT

PROPERTY OWNER Francis C. Ichniowski

ADDRESS 12229 Fawn Haven Court, Ellicott City, Md. 21043

SPECIFICATIONS

SEPTIC TANK CAPACITY \_\_\_\_\_ GALLONS

DRAIN FIELD \_\_\_\_\_ DEPTH \_\_\_\_\_ FEET, BOTTOM AREA \_\_\_\_\_ SQ. FT.

DEEP TRENCH \_\_\_\_\_ DEPTH \_\_\_\_\_ FEET, BOTTOM AREA \_\_\_\_\_ SQ. FT.

SEEPAGE PITS \_\_\_\_\_ ABSORBENT SIDE-WALL AREA \_\_\_\_\_ SQ. FT.

INLET PIPE \_\_\_\_\_ FT. BELOW ORIGINAL GRADE. MAXIMUM DEPTH \_\_\_\_\_ FT. BELOW ORIGINAL GRADE

EFFECTIVE DEPTH AT \_\_\_\_\_ FT. BELOW ORIGINAL GRADE.

LOCATE DISPOSAL AREA \_\_\_\_\_ FT. FROM \_\_\_\_\_ LOT LINE AND \_\_\_\_\_ FT. FROM \_\_\_\_\_ LOT LINE AS SEEN WHEN FACING LOT FROM

REPAIR - Call for an appointment when ground is opened up and Sanitarian will recommend the repair system.

10/29/79 - Trench 10ft deep - 2ft wide - 75' long with 6' of stone  
Dump D

PLANS APPROVED BY Palmer F. Wine DATE 10/29/79

COVER NO WORK UNTIL INSPECTED AND APPROVED.

NEITHER THE HOWARD COUNTY COUNCIL NOR THE HEALTH DEPARTMENT IS RESPONSIBLE FOR THE SUCCESSFUL OPERATION OF ANY SYSTEM.


- NOTE: IF TRENCH IS USED CALL FOR INSPECTION BEFORE PLACING GRAVEL IN TRENCH.
- NOTE: NO DRY WELL SHALL EXCEED 15 FOOT IN DIAMETER.
- NOTE: ALL PIPE FROM HOUSE TO DISPOSAL AREA MUST BE CAST IRON.

PERMIT VOID AFTER THREE YEARS.

NOTE: INSTALL STAND PIPE ON SEPTIC TANK AND DRY WELL. STAND PIPES MUST BE 6 INCHES IN DIAMETER. CAST IRON, CONCRETE OR TERRA COTTA ACCEPTED.

\*INSTALLER IS RESPONSIBLE FOR OBTAINING FINAL APPROVAL ON THIS PERMIT.

P 30299 B

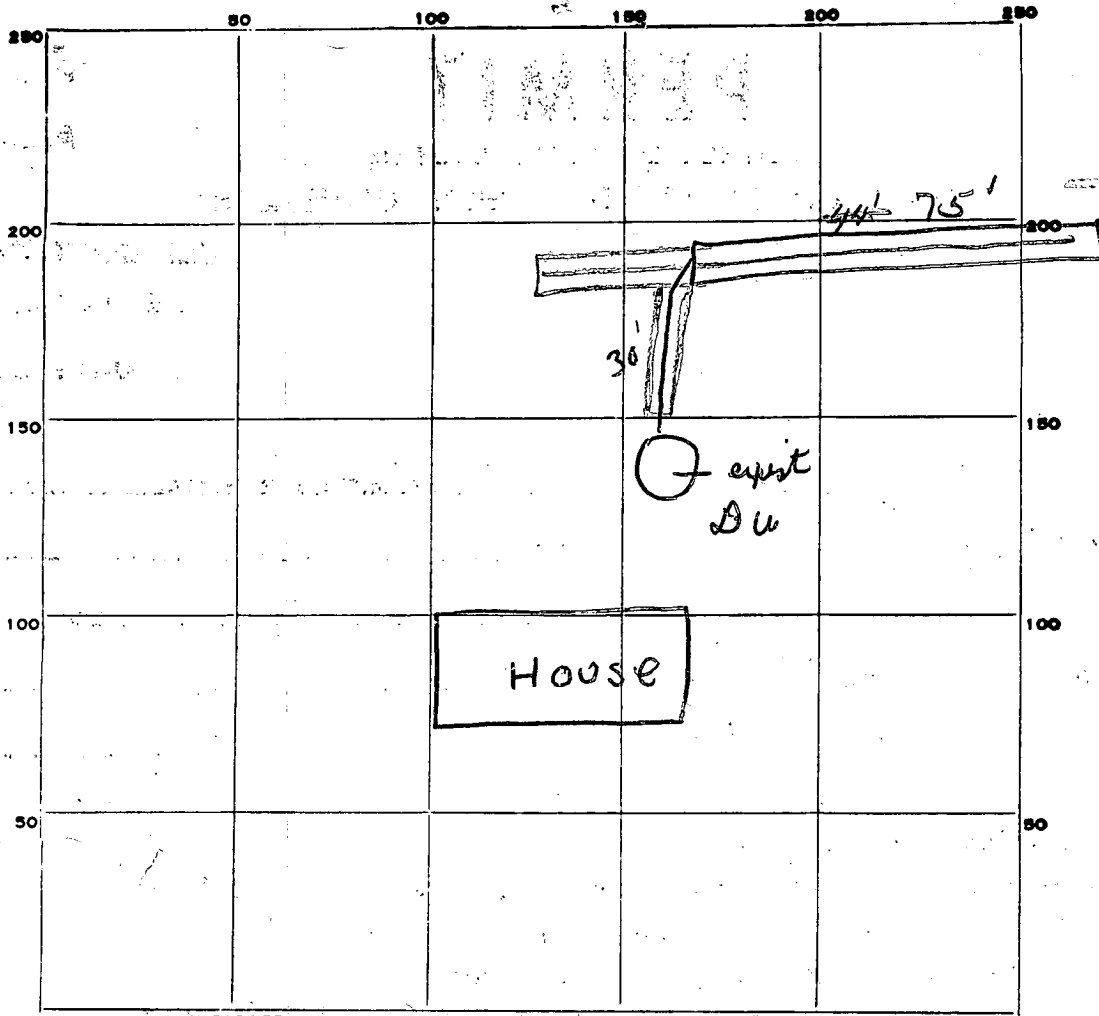

INDICATE NORTH. - NAME ADJOINING ROADWAY AS BASE LINE.  
*Fawnhaven Court*

PERMIT CARD OK

SEPTIC TANK, LEVEL NA

CLEANOUTS NA

DISTRIBUTION BOX, LEVEL \_\_\_\_\_

TILE FIELD, DEPTH 10 FT. TRENCH WIDTH 2 FT.

GRAVEL DEPTH 6 IN. TOTAL LENGTH 75 FT.

NUMBER OF TRENCHES 1 TOTAL BOTTOM AREA 450

SEEPAGE PITS, INSIDE DIAMETER \_\_\_\_\_ FT. DEPTH BELOW INLET \_\_\_\_\_ FT.

ABSORBENT AREA 450 SQ. FT.

REMARKS 10/29/79 - extend trench to 75' length. OK to put gravel in trench

10/30/79 - OK to cover all work

DATE SYSTEM APPROVED 10/30/79

INSPECTOR J. Hayes

30209

HOWARD COUNTY HEALTH DEPARTMENT  
Bureau of Environmental Health  
3525-H Ellicott Mills Drive  
Ellicott City, MD 21043  
461-9933

50-1033016

APPLICATION FOR PITLESS ADAPTER, WELL PUMP AND PRESSURE TANK INSTALLATION

New Installation X  
Replacement \_\_\_\_\_

Receipt # 43309  
Date 12/30/88

Name of Installer R. W. HAFFER

Telephone \_\_\_\_\_

License Number 7920  
Certified Well Pump Installer \_\_\_\_\_

Well Driller \_\_\_\_\_ Registered Plumber X

Name of Property Owner Michael D. James  
Subdivision Ricker Property Lot # 2  
Site Address 13894 Forsythe Road

Telephone (301) 776-5749  
Well Tag # 88-01-49

Pump

- 1. Type
  - a. Deep well jet \_\_\_\_\_
  - b. Shallow well jet \_\_\_\_\_
  - c. Submersible X
- 2. Make MVERS
- 3. Model # J-78
- 4. Capacity 7 GPM
- 5. Pump exceeds well capacity Yes \_\_\_\_\_ No X
- 6. If Yes, is low pressure cutoff switch installed? Yes \_\_\_\_\_ No \_\_\_\_\_
- 7. What methods are used to protect the pump and electrical wiring from vibrations? Torque arrestors \_\_\_\_\_ Cable guards X Other \_\_\_\_\_

Motor

- 1. Horsepower 3/4
- 2. RPM 3450
- 3. Voltage \_\_\_\_\_
  - a. 110 \_\_\_\_\_
  - b. 220 X

Pitless Adapter

- 1. Make MARTINSON
- 2. Model # BP-10X
- 3. Depth 48"

Tank

- 1. Capacity 42 equivalent
- 2. Pressure relief valve? yes

Piping

- 1. Type poly
- 2. Size 1"
- 3. NSF and/or BOCA Code approved yes
- 4. Depth of supply line 48"

Well data

- 1. Depth 225 ft.
- 2. Yield 7 1/2 GPM
- 3. Static water level 49 ft.
- 4. Will water supply be disinfected by installer? NO

I understand that it is my responsibility to notify the Howard County Health Department when the installation is ready for inspection (otherwise this permit is null and void).

All information given above is true to the best of my knowledge.

Signature of Applicant: R. W. Haffer

Date: 12/15/88

Note: A sticker indicating approval/status of the installation will be placed on the well casing at the time of the inspection.