

not ready  
1/11/80  
for please

OFFICE FILE  
1/11/80 FINAL  
P 30440 D.W.M. & C.B.S.  
A REPAIR

# PERMIT

SEWAGE DISPOSAL SYSTEM

MARYLAND STATE DEPARTMENT OF HEALTH\*

1/11/80 HOWARD COUNTY

06-168541

ELLICOTT CITY

DISTRICT 2nd

DATE 12/28/79

INDEXED

Mrs. E. Heinzerling

IS PERMITTED TO INSTALL \_\_\_\_\_ ALTER

ADDRESS 6288 Montgomery Road, Elkridge, Md. 21227 PHONE 796-1621

SUBDIVISION \_\_\_\_\_ ROAD 6288 Montgomery Road LOT \_\_\_\_\_

PROPERTY OWNER Heinzerling

ADDRESS same as above

SPECIFICATIONS 2 bedrooms

SEPTIC TANK CAPACITY 1000 GALLONS

DRAIN FIELD \_\_\_\_\_ DEPTH \_\_\_\_\_ FEET, BOTTOM AREA \_\_\_\_\_ SQ. FT.

DEEP TRENCH \_\_\_\_\_ DEPTH \_\_\_\_\_ FEET, BOTTOM AREA \_\_\_\_\_ SQ. FT.

SEEPAGE PITS \_\_\_\_\_ ABSORBENT SIDE-WALL AREA \_\_\_\_\_ SQ. FT.

INLET PIPE \_\_\_\_\_ FT. BELOW ORIGINAL GRADE. MAXIMUM DEPTH \_\_\_\_\_ FT. BELOW ORIGINAL GRADE

EFFECTIVE DEPTH AT \_\_\_\_\_ FT. BELOW ORIGINAL GRADE.

LOCATE DISPOSAL AREA \_\_\_\_\_ FT. FROM \_\_\_\_\_ LOT LINE AND \_\_\_\_\_ FT. FROM \_\_\_\_\_ LOT LINE AS SEEN WHEN

FACING LOT FROM

REPLACEMENT OF SEPTIC TANK ONLY.

PLANS APPROVED BY Palmer F. Wine DATE 12/28/79

COVER NO WORK UNTIL INSPECTED AND APPROVED.

NEITHER THE HOWARD COUNTY COUNCIL NOR THE HEALTH DEPARTMENT IS RESPONSIBLE FOR THE SUCCESSFUL OPERATION OF ANY SYSTEM.

NOTE: IF TRENCH IS USED CALL FOR INSPECTION BEFORE PLACING GRAVEL IN TRENCH.

NOTE: NO DRY WELL SHALL EXCEED 15 FOOT IN DIAMETER.


NOTE: ALL PIPE FROM HOUSE TO DISPOSAL AREA MUST BE CAST IRON.

PERMIT VOID AFTER THREE YEARS.

NOTE: INSTALL STAND PIPE ON SEPTIC TANK AND DRY WELL. STAND PIPES MUST BE 6 INCHES IN DIAMETER. CAST IRON, CONCRETE OR TERRAZO ACCEPTED.

\*INSTALLER IS RESPONSIBLE FOR OBTAINING FINAL APPROVAL ON THIS PERMIT.

P 30440

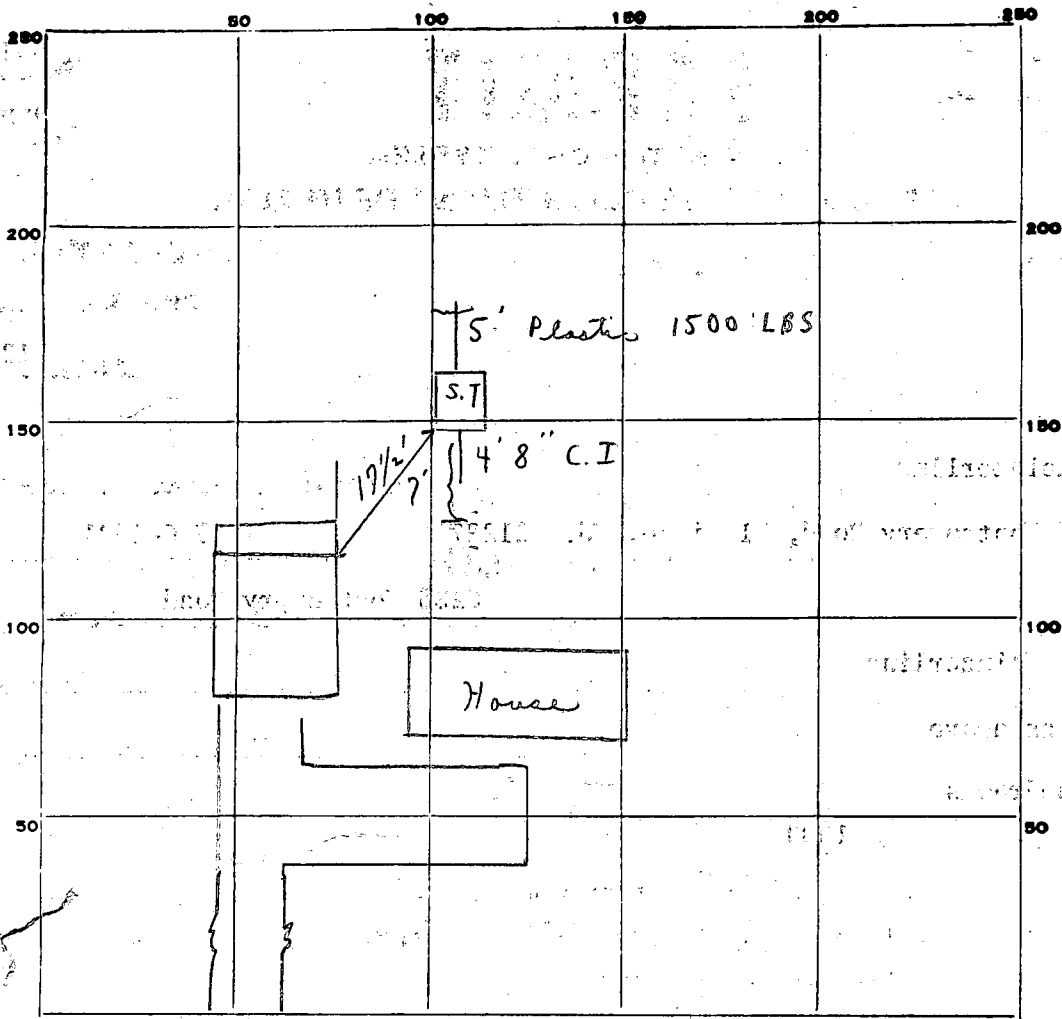

INDICATE NORTH. - NAME ADJOINING ROADWAY AS BASE LINE.

MONTGOMERY ROAD

PERMIT CARD

SEPTIC TANK, LEVEL  CLEANOUTS  S.T.

DISTRIBUTION BOX, LEVEL \_\_\_\_\_

TILE FIELD, DEPTH \_\_\_\_\_ FT. TRENCH WIDTH \_\_\_\_\_ FT.

GRAVEL DEPTH \_\_\_\_\_ IN. TOTAL LENGTH \_\_\_\_\_ FT.

NUMBER OF TRENCHES \_\_\_\_\_ TOTAL BOTTOM AREA \_\_\_\_\_

SEEPAGE PITS, INSIDE DIAMETER \_\_\_\_\_ FT. DEPTH BELOW INLET \_\_\_\_\_ FT.

ABSORBENT AREA \_\_\_\_\_ SQ. FT.

REMARKS 12:30 1/9/80 CHECKED - SYSTEM NOT READY - TANK ON TRUCK.  
 TO CALL WHEN READY; PARTIAL 1/11/80 TANK IN-CAST. IRON C.B.S.  
 FROM HOUSE TO TANK; HOLD 5' PLASTIC FROM TANK TO OLD  
 SYSTEM - STOP WORK STG NED - HOLD FOR SUPERVISOR; OFFICE  
 OK PER MR MONAGHAN. FILE  
 C.B.S.

DATE SYSTEM APPROVED 1/11/80 <sup>above</sup> INSPECTOR C. B. Steaker