

APPLICATION

A 18428

P _____

SEWAGE DISPOSAL TESTING

MARYLAND STATE DEPARTMENT OF HEALTH

HOWARD COUNTY

ELLCOTT CITY

DISTRICT 4

DATE 11/1/71

TO: THE COUNTY HEALTH OFFICER
ELLCOTT CITY, MARYLAND

I, HEREBY, APPLY FOR THE NECESSARY TESTS IN ORDER TO CONSTRUCT (OR RECONSTRUCT) A SEWAGE DISPOSAL SYSTEM.

PROPERTY OWNER Mordecia Hosen

ADDRESS Duvall Road, Woodbine, Maryland

Any questions call:
PHONE Hardin F. Ross, III
730-7700 Ext. 387

PROPERTY LOCATION:

SUBDIVISION _____

LOT NO. _____

ROAD AND DESCRIPTION Duvall Road - approx. 1 mile in on Dvll Rd. off Ed. Warfield Rd.
(Use Daisy Road)

A green jeep will be parked beside
road

OCCUPANT _____

PHONE _____

PERSON TO CONSTRUCT SYSTEM _____

ADDRESS _____

PHONE _____

SIZE OF LOT 20.006 acres

TYPE BLDG. _____

NUMBER OF BEDROOMS

3
(Single Fmly. Dwllg.)

IF NOT SINGLE RESIDENCE DESCRIBE _____

SIGNATURE OF APPLICANT [Signature]

APPROVED BY [Signature]

FOR [Signature]

(KIND OF SYSTEM)

DATE 11-7-71

REJECTED BY _____

FOR _____

(KIND OF SYSTEM)

DATE _____

HOLD PENDING FURTHER TESTS _____


DATE _____

REASONS FOR REJECTION OR HOLDING _____

THIS IS NOT A PERMIT

65
1945

APPLICATOR

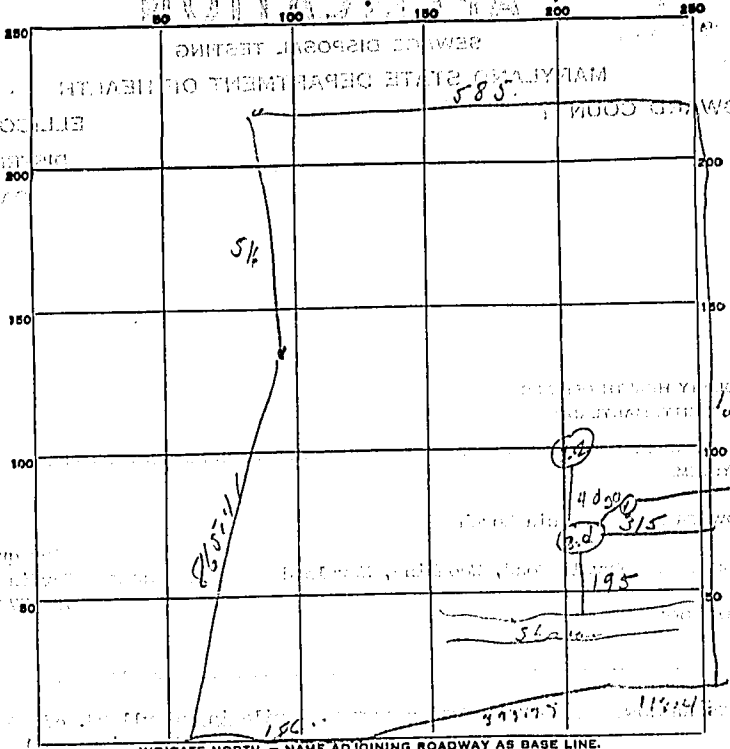

INDICATE NORTH - NAME ADJOINING ROADWAY AS BASE LINE.

Sumall 020

DATE	TEST NO.	DEPTH	PRE-WET		TEST - 1" DROP		TIME
			START	STOP	START	STOP	
11/17	1	4 ft	11 20		11 23		
	2	12 ft	11 21		11 25		dry
	3	16 ft	11 21		11 25		dry
	4		11 21		11 25		dry

11
15
13
13

52

11
4
21
2
67

52
9
468

SOIL AUGER FINDING Sand shale

TESTED BY Dr

REMARKS