

3/27/80 File approved C.B.S.

01-183915

3/27/80 after 1:00 p.m. please

PERMIT

P 3/26/80

A REPAIR

SEWAGE DISPOSAL SYSTEM

MARYLAND STATE DEPARTMENT OF HEALTH*

HOWARD COUNTY

ELLICOTT CITY

INDEXED

DISTRICT END.

DATE 3/26/80

Jenkins Bros.

IS PERMITTED TO INSTALL ALTER

ADDRESS 10439 Frederick Road, Ellicott City, Md. PHONE 465-6646

SUBDIVISION _____ ROAD 6384 Montgomery Road LOT _____

PROPERTY OWNER Williams

ADDRESS 6384 Montgomery Road

SPECIFICATIONS

SEPTIC TANK CAPACITY _____ GALLONS

DRAIN FIELD _____ DEPTH _____ FEET, BOTTOM AREA _____ SQ. FT.

DEEP TRENCH _____ DEPTH _____ FEET, BOTTOM AREA _____ SQ. FT.

SEEPAGE PITS _____ ABSORBENT SIDE-WALL AREA _____ SQ. FT.

INLET PIPE _____ FT. BELOW ORIGINAL GRADE. MAXIMUM DEPTH _____ FT. BELOW ORIGINAL GRADE

EFFECTIVE DEPTH AT _____ FT. BELOW ORIGINAL GRADE.

LOCATE DISPOSAL AREA _____ FT. FROM _____ LOT LINE AND _____ FT. FROM _____ LOT LINE AS SEEN WHEN

FACING LOT FROM

REPAIR - CALL FOR INSPECTION WHEN GROUND IS OPENED UP SO SANITARIAN CAN RECOMMEND

REPAIR 3/26/80 See attached perc sheet.
C.B.S.

PLANS APPROVED BY Palmer F. Wine DATE 3/26/80

COVER NO WORK UNTIL INSPECTED AND APPROVED.

NEITHER THE HOWARD COUNTY COUNCIL NOR THE HEALTH DEPARTMENT IS RESPONSIBLE FOR THE SUCCESSFUL OPERATION OF ANY SYSTEM.

NOTE: IF TRENCH IS USED CALL FOR INSPECTION BEFORE PLACING GRAVEL IN TRENCH.

NOTE: NO DRY WELL SHALL EXCEED 15 FOOT IN DIAMETER.

NOTE: ALL PIPE FROM HOUSE TO DISPOSAL AREA MUST BE CAST IRON.


PERMIT VOID AFTER THREE YEARS.

NOTE: INSTALL STAND PIPE ON SEPTIC TANK AND DRY WELL. STAND PIPES MUST BE 8 INCHES IN DIAMETER. CAST IRON, CONCRETE OR TERRA COTTA ACCEPTED.

BLDG. PERMIT SIGNED AND RETURNED 5/8/87
Serial # 11591

P 30603

*INSTALLER IS RESPONSIBLE FOR OBTAINING FINAL APPROVAL ON THIS PERMIT.

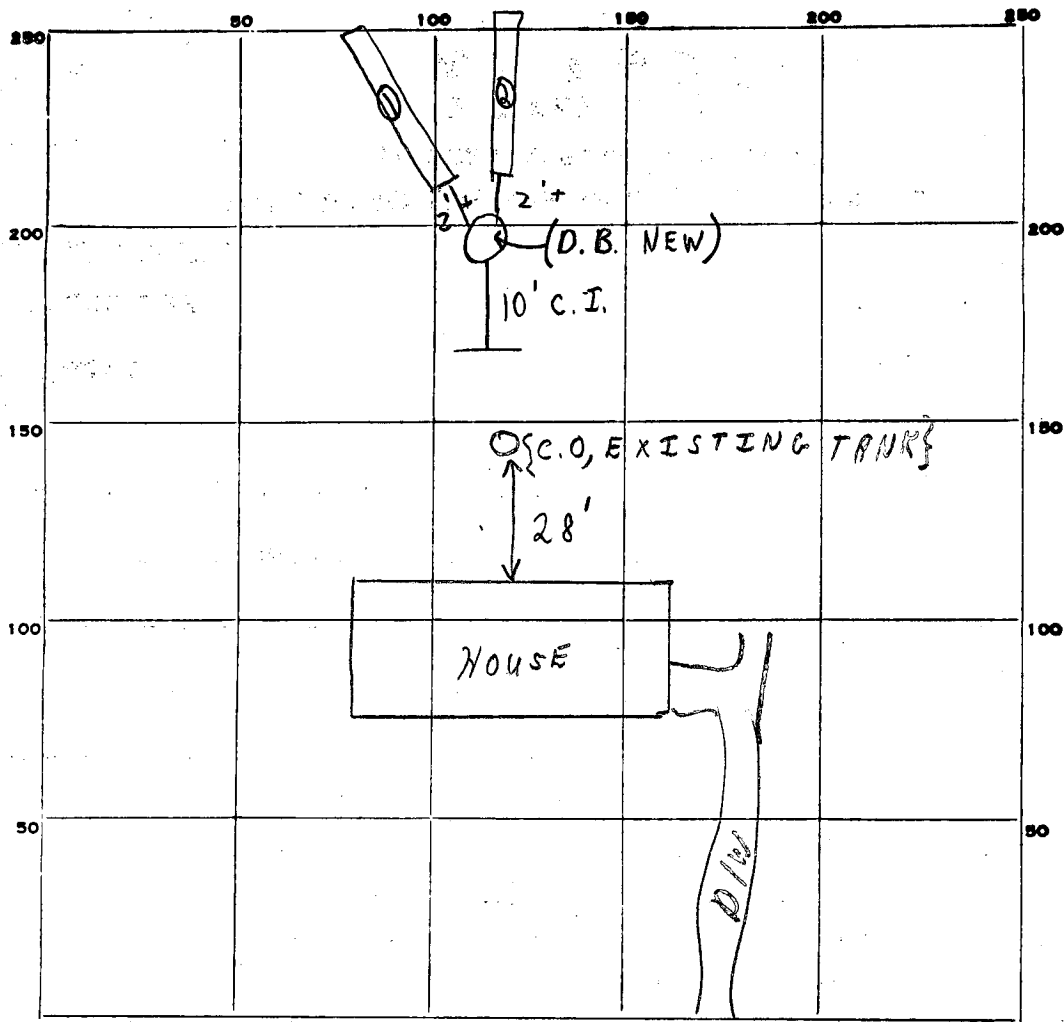

INDICATE NORTH. - NAME ADJOINING ROADWAY AS BASE LINE.

MONTGOMERY RD.

PERMIT CARD

SEPTIC TANK, LEVEL _____

CLEANOUTS _____

DISTRIBUTION BOX, LEVEL

TILE FIELD, DEPTH 4'-4 1/2' ± FT. TRENCH WIDTH 3 FT.

GRAVEL DEPTH 1 IN. TOTAL LENGTH 0 6 2 2 1 2 3 + FT.

NUMBER OF TRENCHES 2 TOTAL BOTTOM AREA 370' +

SEEPAGE PITS, INSIDE DIAMETER _____ FT. DEPTH BELOW INLET _____ FT.

ABSORBENT AREA _____ SQ. FT.

REMARKS 3/27/80 SYSTEM CHECKED-REPAIRS COMPLETE; SHALLOW TRENCHES
(1 inspection only per office) C.B.V.


DATE SYSTEM APPROVED 3/27/80

INSPECTOR C. B. V. Stecker

Mr. Williams
Repin

SOIL PROFILE

SEE
BELOW
↓

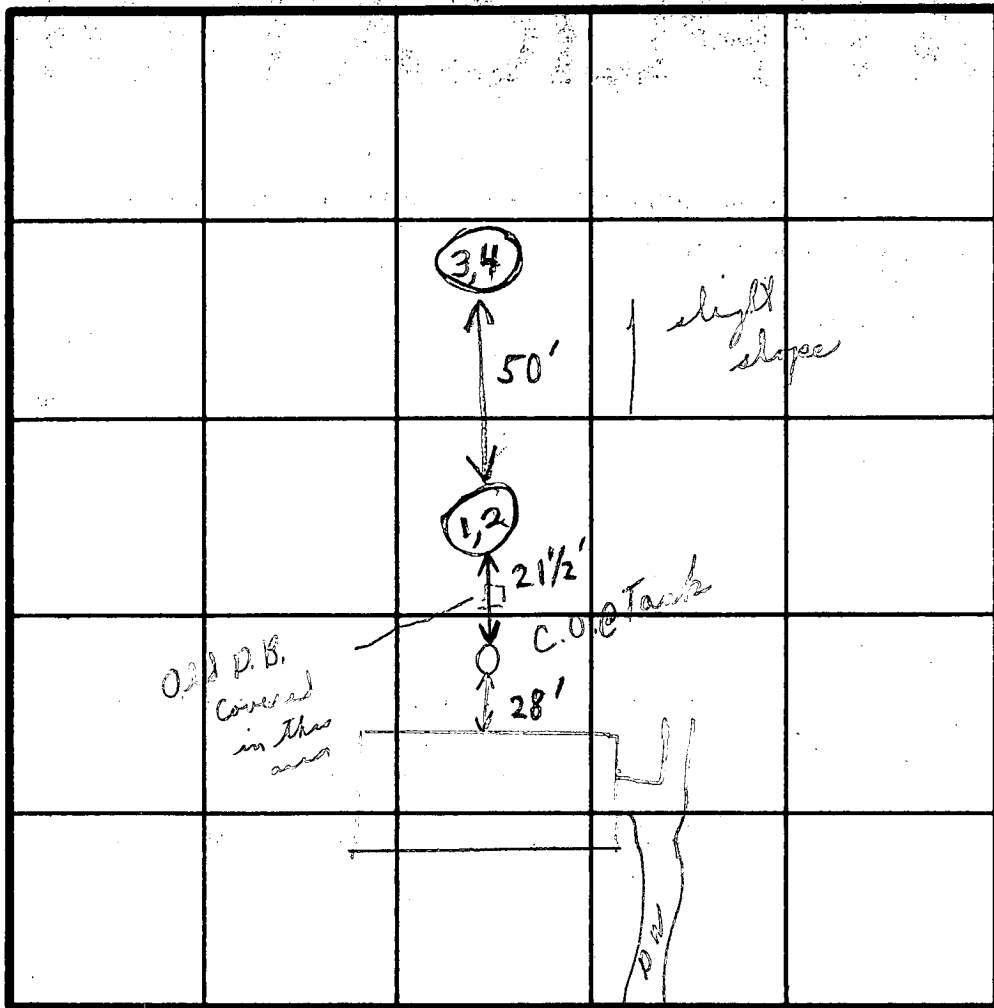

INDICATE NORTH - NAME ADJOINING ROADWAY AS BASE LINE.

MONTGOMERY RD.

Soil Profile

Below 1'-2 1/2'
Sandy loam
to white clay
1'-3 1/2' clay
3 1/2' - 7'

DATE	TEST NO.	DEPTH	PRE-WET		TEST - 1" DROP		TIME
			START	STOP	START	STOP	
3/26/70	1	1-2 1/2'	:	:	gravel:		
	2	2 1/2'-7'	:	:	Sandy, stone covering in fact (very)		
	3	3'-3 1/2'	:	:	Sandy, gravel, 3'-7'		
	4	7'	:	:	:		

REMARKS Tests not run { sandy } Public Water per Mr. Williams
 TYPE OF SOIL soil covering }
 TESTED BY C. B. J. ALSO PRESENT Mr. Wilkins, Mr. Perkins, Allen

PLAT RHM 5/39

Montgomery Rd

