


Touch

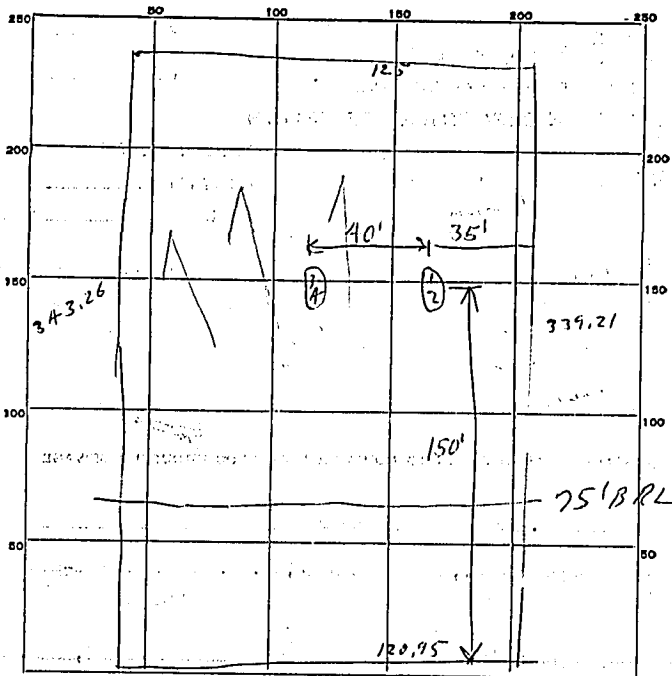

INDICATE NORTH - NAME ADJOINING ROADWAY AS BASE LINE.
Beaufort Drive

12 min Aug
150 ft

40
25

125
4
580
125
5
625

GLK

DATE	TEST NO.	DEPTH	PRE-WET		TEST - 1" DROP		TIME
			START	STOP	START	STOP	
4/4/65	1	9ft	1100	1002	1102	1108	6 min
	2	4ft	1101	1110	1110	1130	20 min
	3	4ft	1105	1110	1110	1118	8 min
	4	4ft	1106	1113	1113	1127	14 min
4/2/79	(3)4	13 1/2	VISUAL	↔ M	CRIOUS	SANDY LOI	M
			good soil	at 3'			
			No presence of clay	layer			

GLK

Dowd
Presca
8521
Beaufort
20759

SOIL-AUGER FINDING OPEN FIELD -

TESTED BY R.O.F. 4/4/65

REMARKS VISUAL - NOIS GLK

Lot 2E, Plat 2