

APPLICATION

PERCOLATION TESTING

A 41434

P _____

HOWARD COUNTY HEALTH DEPARTMENT
BUREAU OF ENVIRONMENTAL HEALTH
P.O. BOX 476 ELLICOTT CITY, MARYLAND 21043
TELEPHONE: 461-9933

DISTRICT 3

DATE 4/7/88
~~10 March, 1988~~

TO: THE COUNTY HEALTH OFFICER
ELLICOTT CITY, MARYLAND

I, HEREBY, APPLY FOR THE NECESSARY TEST IN ORDER TO CONSTRUCT (OR RECONSTRUCT) A SEWAGE DISPOSAL SYSTEM.

PROPERTY OWNER Jean R. Dickey, Individually; Jean R. Dickey, Trustee Jean R. Dickey Inter-Vivos TRUST

ADDRESS 13850 Forsythe Rd., Sykesville, Md 21784 PHONE (301) 442-2226

PROSPECTIVE BUYER _____

ADDRESS _____ PHONE _____

PROPERTY LOCATION:

SUBDIVISION King's Gift LOT NO. 30

ROAD AND DESCRIPTION North on Route 144, East of Thompson Drive

TAX MAP 16 PARCEL # 347

SIZE OF LOT 5.391 Ac± TYPE BLDG. Single Family Dwelling
(SINGLE FAMILY DWELLING OR COMMERCIAL)

THE SYSTEM INSTALLED UNDER THIS APPLICATION IS ACCEPTABLE ONLY UNTIL PUBLIC FACILITIES BECOME AVAILABLE. I FULLY UNDERSTAND THE FEE CONNECTED WITH THE FILING OF THIS PERC TEST APPLICATION IS NON-REFUNDABLE UNDER ANY CIRCUMSTANCES. I ALSO AGREE TO COMPLY WITH ALL M.O.S.H.A. REQUIREMENTS IN TESTING THIS LOT.

Richard F. Lane (Applicant)
(SIGNATURE OF APPLICANT)

APPROVED BY _____ FOR _____ DATE _____





REJECTED BY _____ FOR _____ DATE _____

HOLD PENDING FURTHER TESTS _____ DATE _____

REASONS FOR REJECTION OR HOLDING 6/22/88 Perc OK Hold for Plat R/H

THIS IS NOT A PERMIT

KINGS GIFT
LOT 30

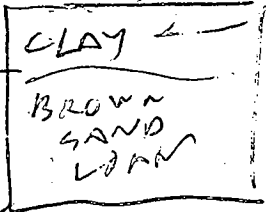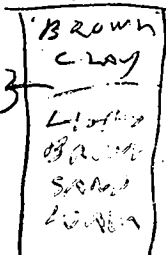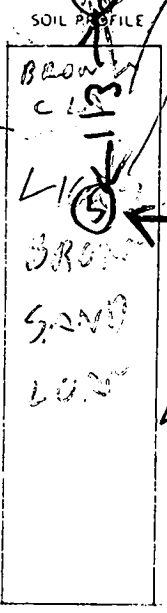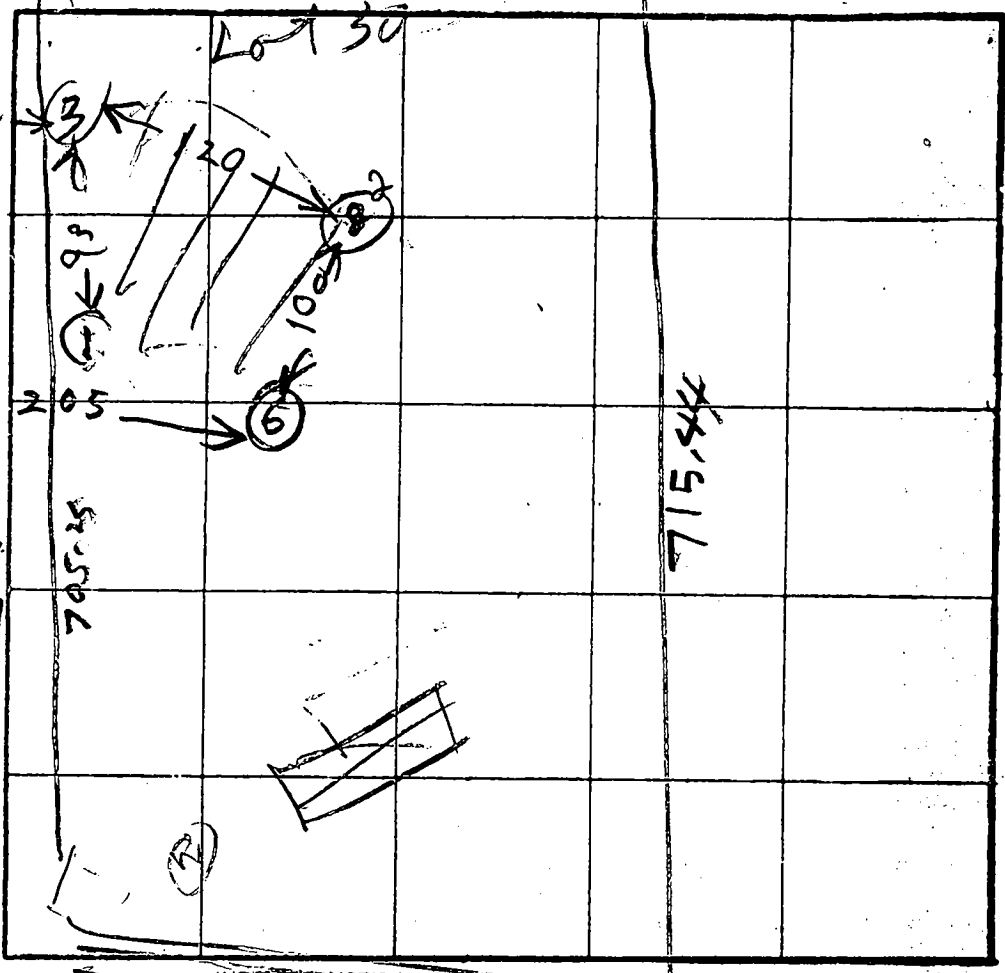


INDICATE NORTH - NAME ADJOINING ROADWAY AS BASE LINE


X Perc. F. 4min 180 WBL
TWT 3 Bottom 4.5

DATE	TEST NO	DEPTH	PRE-WET		TEST - 1" DROP		TIME
			START	STOP	START	STOP	
6/22/86	1S	8	116	118	118	127	9
	1H	8	116	117	117	120	3
	1V	12	OK				
	2S	7.5	124	126	126	128	2
	2V	12	OK				
	3S	5	131	135	135	138	3
	3V	11.5	OK				
	4S	5	138	139	139	142	3
	4V	11.5	OK				
	5V	11	OK				
	6V	12	OK				

ONLINE
LOT 298 448
ONLINE
LOT 298 448

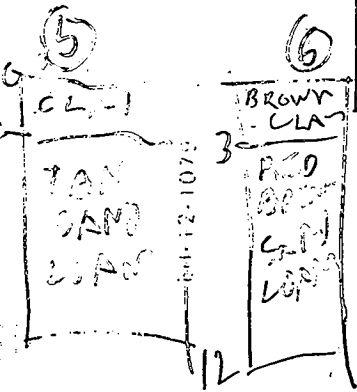

REMARKS: HOLES DUG DIFFERENT FROM SURVEYOR PLOT 7 ON KEINE
TYPE OF SOIL: HOLES USED
TESTED BY: R. HODGES
ALSO PRESENT: OKETTISAWYER

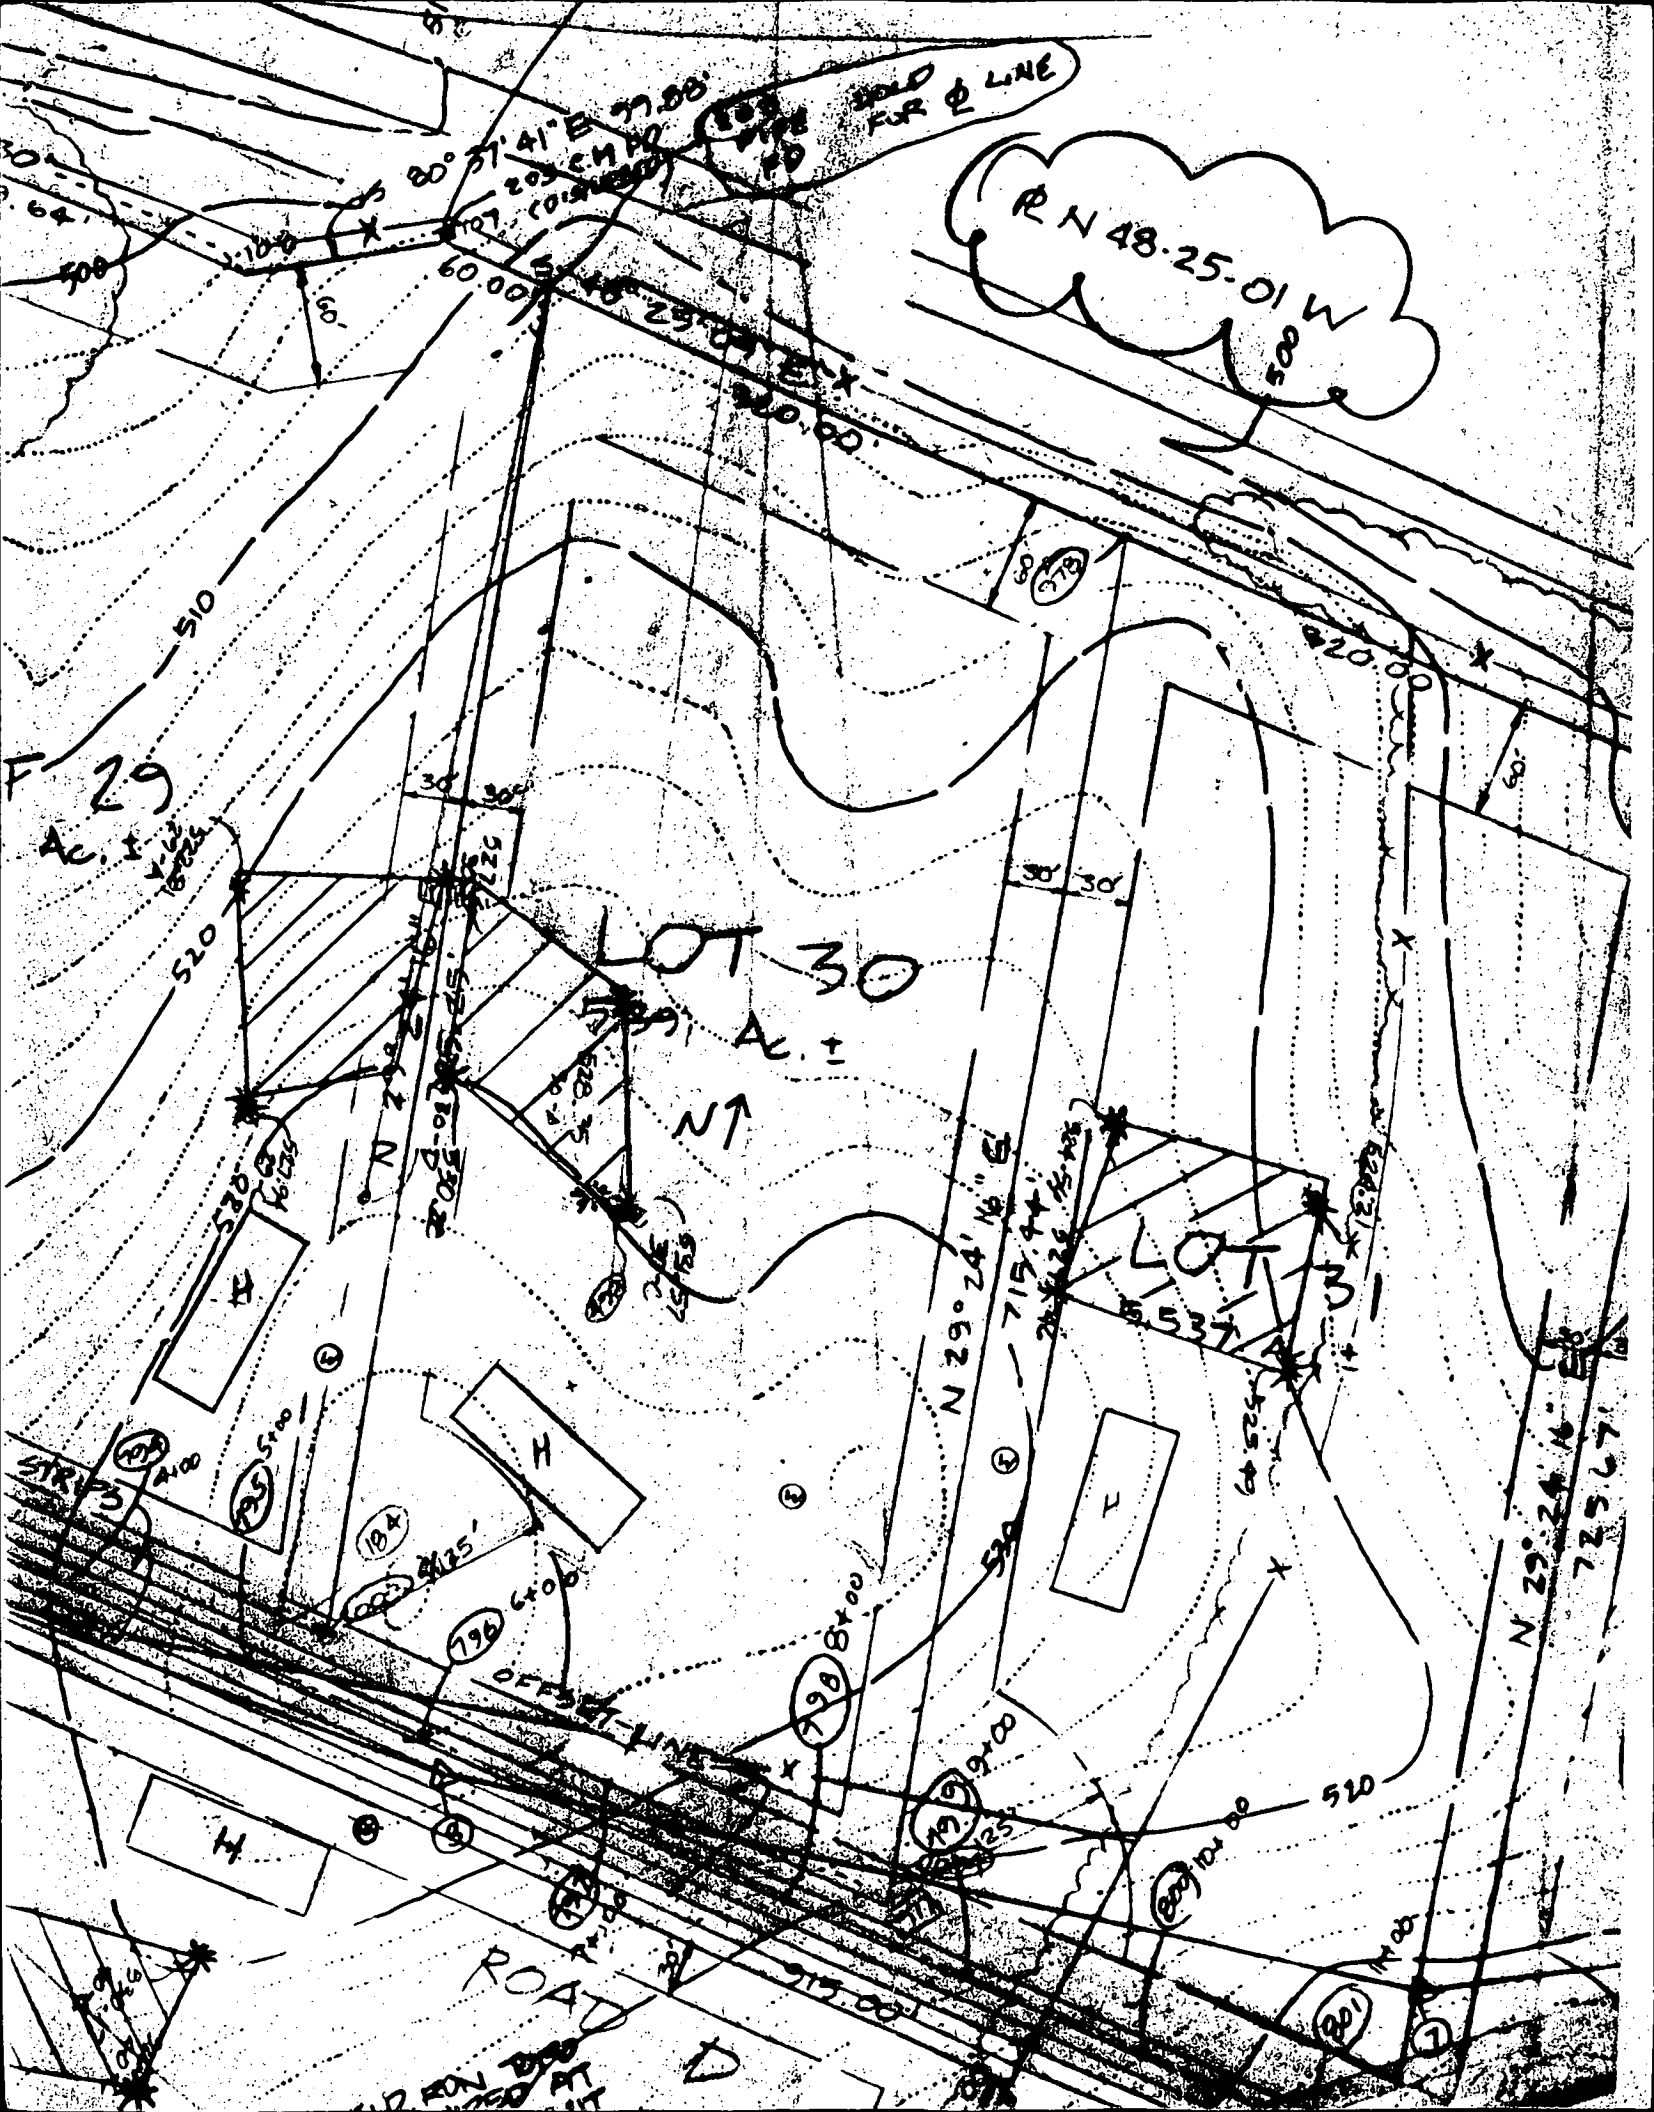

X VERIFY
DATA
Rc

