

5/5/80
around lunch time
please

5-7-80
S

PERMIT

P 30662

A Repair

SEWAGE DISPOSAL SYSTEM

MARYLAND STATE DEPARTMENT OF HEALTH

HOWARD COUNTY

02-204449

ELLICOTT CITY

DISTRICT 2nd

INDEXED

DATE 5/5/80

Jack Fyock IS PERMITTED TO INSTALL ALTER X

ADDRESS 13775 Triadelphia Road, Glenelg, Md. 21737 PHONE 988-9270

SUBDIVISION Mt. Hebron ROAD 2132 Mt. Hebron Drive LOT

PROPERTY OWNER Mr. and Mrs. Bhargava

ADDRESS 2132 Mt. Hebron Drive, Ellicott City, Md. Phone: 465-1124

SPECIFICATIONS

SEPTIC TANK CAPACITY _____ GALLONS
DRAIN FIELD _____ DEPTH _____ FEET, BOTTOM AREA _____ SQ. FT.
DEEP TRENCH _____ DEPTH _____ FEET, BOTTOM AREA _____ SQ. FT.
SEEPAGE PITS _____ ABSORBENT SIDE-WALL AREA _____ SQ. FT.
INLET PIPE _____ FT. BELOW ORIGINAL GRADE. MAXIMUM DEPTH _____ FT. BELOW ORIGINAL GRADE
EFFECTIVE DEPTH AT _____ FT. BELOW ORIGINAL GRADE.
LOCATE DISPOSAL AREA _____ FT. FROM _____ LOT LINE AND _____ FT. FROM _____ LOT LINE AS SEEN WHEN
FACING LOT FROM


REPAIR - Call for an inspection when ground is opened up and Sanitarian will
recommend the repair system.

PLANS APPROVED BY Palmer F. Wine DATE 5/5/80

- COVER NO WORK UNTIL INSPECTED AND APPROVED.
- NEITHER THE HOWARD COUNTY COUNCIL NOR THE HEALTH DEPARTMENT IS RESPONSIBLE FOR THE SUCCESSFUL OPERATION OF ANY SYSTEM.
- NOTE: IF TRENCH IS USED CALL FOR INSPECTION BEFORE PLACING GRAVEL IN TRENCH.
- NOTE: NO DRY WELL SHALL EXCEED 15 FOOT IN DIAMETER.
- NOTE: ALL PIPE FROM HOUSE TO DISPOSAL AREA MUST BE CAST IRON.
- PERMIT VOID AFTER THREE YEARS.
- NOTE: INSTALL STAND PIPE ON SEPTIC TANK AND DRY WELL. STAND PIPES MUST BE 6 INCHES IN DIAMETER. CAST IRON, CONCRETE OR TERRA COTTA ACCEPTED.

*INSTALLER IS RESPONSIBLE FOR OBTAINING FINAL APPROVAL ON THIS PERMIT.

R P-30662

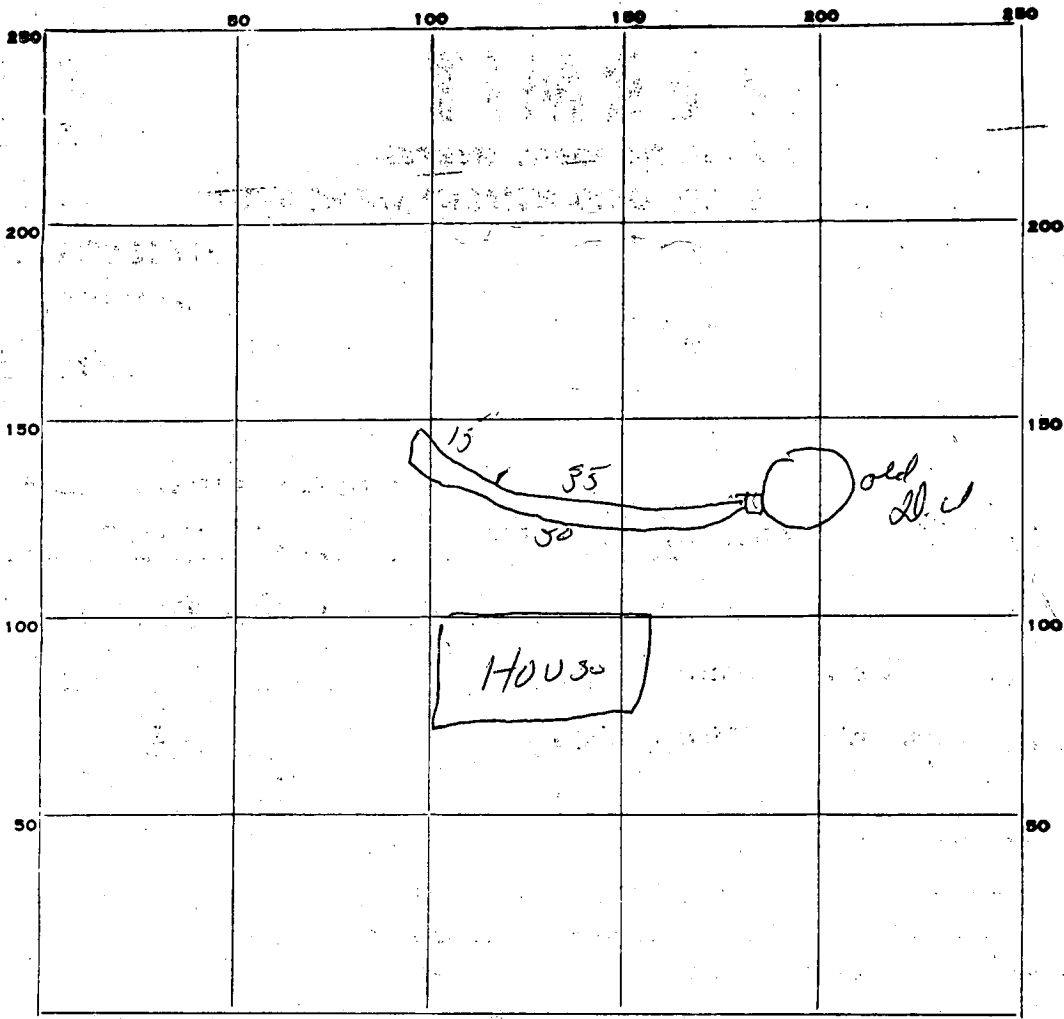

INDICATE NORTH. - NAME ADJOINING ROADWAY AS BASE LINE.

35
8
280
15
75

PERMIT CARD LD

SEPTIC TANK, LEVEL N 17

CLEANOUTS N 17

DISTRIBUTION BOX, LEVEL _____

TILE FIELD, DEPTH 9 to 12 FT. TRENCH WIDTH 2 FT.

GRAVEL DEPTH 5 to 8 ft IN. TOTAL LENGTH 50 FT.

NUMBER OF TRENCHES 1 TOTAL BOTTOM AREA 100

SEEPAGE PITS, INSIDE DIAMETER _____ FT. DEPTH BELOW INLET _____ FT.

ABSORBENT AREA $\left. \begin{matrix} 280 \text{ ft} \\ 75 \text{ ft} \end{matrix} \right\} 355 \text{ ft one side of trench.}$ SQ. FT.

REMARKS rock at 9 ft. at far end - Trench to be 50' long 80 gravel - near SW
5/5/80 - OK to put gravel in trench 50 gravel - far end

DATE SYSTEM APPROVED 5-7-80

INSPECTOR M. Manag Lem

Measured trench in

2 place - 3 ft deep

Blengam

5/5/80