

5/6/80  
after lunch please

app. 5-6-80  
WWM

# PERMIT

P 30664

SEWAGE DISPOSAL SYSTEM

A Repair

MARYLAND STATE DEPARTMENT OF HEALTH

HOWARD COUNTY

05-422825

ELLICOTT CITY

INDEXED

DISTRICT 5th

DATE 5/5/80

Jack Fyock

IS PERMITTED TO INSTALL \_\_\_\_\_ ALTER X

ADDRESS 13775 Triadelphia Road, Glenelg, Md. 21737 PHONE 988-9270

SUBDIVISION Cedar Acres ROAD 10884 Harmel Drive LOT \_\_\_\_\_

PROPERTY OWNER Mr. Lawrence Adkins Dennis C. PESCE

ADDRESS 10884 Harmel Drive, Clarksville, Md. 21029 Home: 531-6344 Work: 796-6254

SPECIFICATIONS

SEPTIC TANK CAPACITY \_\_\_\_\_ GALLONS

DRAIN FIELD \_\_\_\_\_ DEPTH \_\_\_\_\_ FEET, BOTTOM AREA \_\_\_\_\_ SQ. FT.

DEEP TRENCH \_\_\_\_\_ DEPTH \_\_\_\_\_ FEET, BOTTOM AREA \_\_\_\_\_ SQ. FT.

SEEPAGE PITS \_\_\_\_\_ ABSORBENT SIDE-WALL AREA \_\_\_\_\_ SQ. FT.

INLET PIPE \_\_\_\_\_ FT. BELOW ORIGINAL GRADE, MAXIMUM DEPTH \_\_\_\_\_ FT. BELOW ORIGINAL GRADE

EFFECTIVE DEPTH AT \_\_\_\_\_ FT. BELOW ORIGINAL GRADE.

LOCATE DISPOSAL AREA \_\_\_\_\_ FT. FROM \_\_\_\_\_ LOT LINE AND \_\_\_\_\_ FT. FROM \_\_\_\_\_ LOT LINE AS SEEN WHEN FACING LOT FROM

**REPAIR - Call for an appointment when ground is opened up and Sanitarian will recommend the repair system.**

PLANS APPROVED BY Palmer F. Wine DATE 5/5/80

COVER NO WORK UNTIL INSPECTED AND APPROVED.

NEITHER THE HOWARD COUNTY COUNCIL NOR THE HEALTH DEPARTMENT IS RESPONSIBLE FOR THE SUCCESSFUL OPERATION OF ANY SYSTEM.

- NOTE: IF TRENCH IS USED CALL FOR INSPECTION BEFORE PLACING GRAVEL IN TRENCH.
- NOTE: NO DRY WELL SHALL EXCEED 15 FOOT IN DIAMETER.
- NOTE: ALL PIPE FROM HOUSE TO DISPOSAL AREA MUST BE CAST IRON.


BLDG. PERMIT SIGNED  
AND RETURNED 5/19/80  
Serial # 64837

PERMIT VOID AFTER THREE YEARS.

NOTE: INSTALL STAND PIPE ON SEPTIC TANK AND DRY WELL. STAND PIPES MUST BE 6 INCHES IN DIAMETER. CAST IRON, CONCRETE OR TERRA COTTA ACCEPTED.

**\*INSTALLER IS RESPONSIBLE FOR OBTAINING FINAL APPROVAL ON THIS PERMIT.**

A-P-30664

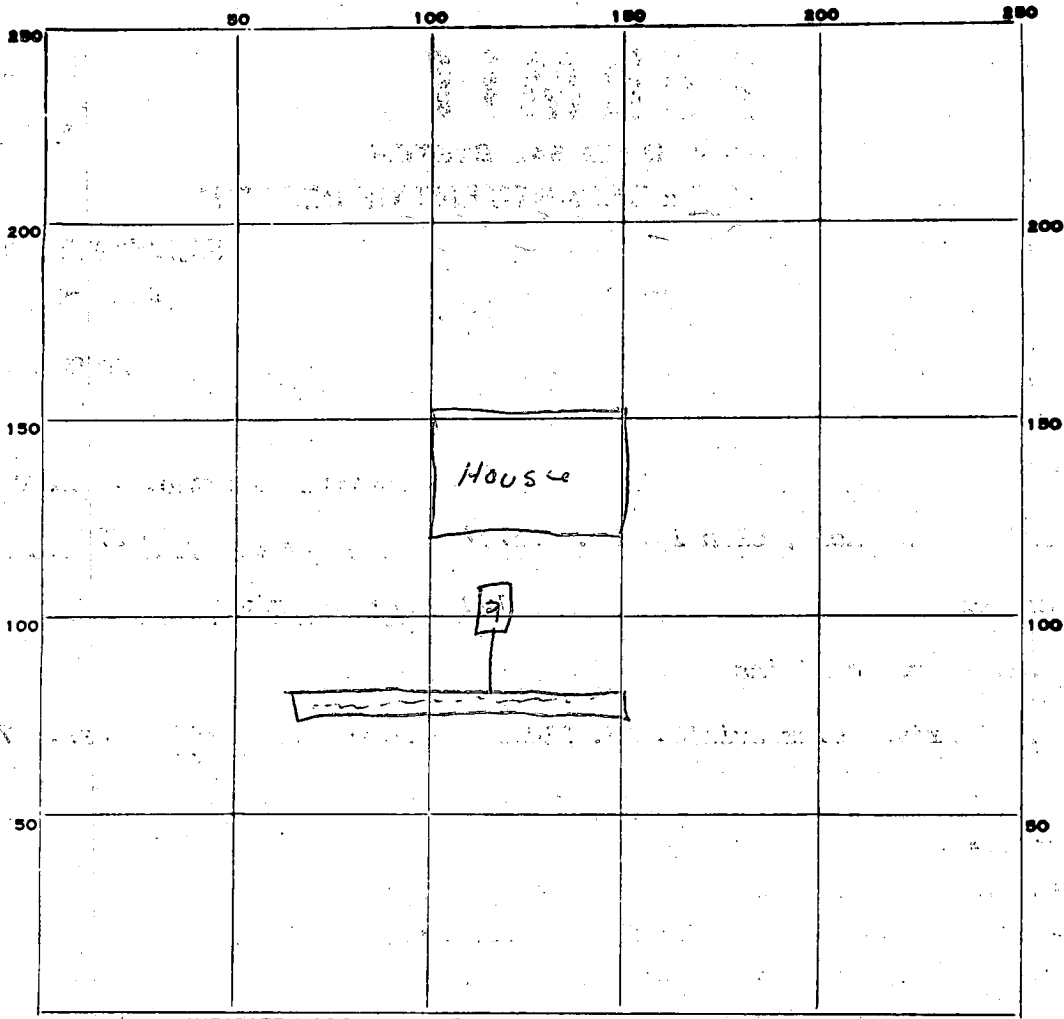

INDICATE NORTH. - NAME ADJOINING ROADWAY AS BASE LINE.

PERMIT CARD OK

SEPTIC TANK, LEVEL n/a CLEANOUTS n/a

DISTRIBUTION BOX, LEVEL n/a

TILE FIELD, DEPTH 10 FT. TRENCH WIDTH 2 FT.

GRAVEL DEPTH 84 IN. TOTAL LENGTH 65 FT.

NUMBER OF TRENCHES \_\_\_\_\_ TOTAL BOTTOM AREA 130 ft<sup>2</sup>

SEEPAGE PITS, INSIDE DIAMETER \_\_\_\_\_ FT. DEPTH BELOW INLET \_\_\_\_\_ FT.

ABSORBENT AREA 4135 SQ. FT. one side of trench

REMARKS 5-6-80 trench 10 ft deep per owner / R. Dickmond Alloway

DATE SYSTEM APPROVED 5-6-80

INSPECTOR DW. Managhar



APPLICATION

HOWARD COUNTY

# PERMIT APPLICATION

DEPARTMENT OF INSPECTIONS, LICENSES & PERMIT  
3430 COURT HOUSE DRIVE, ELLICOTT CITY, MARYLAND 21043

SERIAL NUMBER

64337

PIC

B00100083

1125 PK  
30664  
18482

BUILDING ADDRESS (HOUSE NO., STREET, TOWN OR AREA)

10884 HARMEL DR  
COLUMBIA, MD 21044-3721

GRADING/SEDIMENT CONTROL  YES  NO

SDP #

DESCRIPTION OF WORK AUTHORIZED

24' x 38' Detached Garage  
MORTON Building Design

LOT NO.	PARCEL NO.	SEC.	AREA	BLOCK NO.	LIBER	FOLIO
SUB DIVISION		ZONE	ZONE MAP	ELEC. DIST.	CENSUS TR.	

OWNER NAME AND ADDRESS PHONE NO.  
 DENNIS C. PESCE (301) 596-0111  
 10884 HARMEL DRIVE  
 COLUMBIA MD 21044-3721

SIZE OF BLDG.	FRONT	DEPTH	HEIGHT
24' x 38'			

OCCUPANT'S NAME AND ADDRESS PHONE NO.  
 SAME

TYPE OF BLDG.	AREA	VOLUME	ROOF
B. ROOMS			
ROOMS			
BATHS			
FIREPLACES			

ARCHITECT OR ENGINEER'S NAME AND ADDRESS PHONE NO.  
 MORTON BUILDINGS, INC (717)  
 3368 YORK RD.  
 GETTYSBURG PA 17325-8258 624-3331

FOOTINGS	FOUNDATION	S. WALLS

CONTRACTOR'S NAME AND ADDRESS PHONE NO.

UTILITIES					
WATER/WELL	SEWER	SEPTIC	GAS	ELECTRICITY	TYPE OF HEAT AC
				<input checked="" type="checkbox"/>	

I have carefully examined and read this application and know the same is true and correct, and that in doing this work, all provisions of Howard County Ordinances and the State Laws of Maryland will be complied with, whether specified or not; and I will notify the Department of Inspections, and Permits twenty-four hours in advance when I am ready for the inspections called for elsewhere in the application; and that no work will be covered up until such inspections have been complied with.

EXISTING USE PROPOSED USE  
 Single Family Home SAME with Garage

EST. CONSTRUCTION COST LICENSE NUMBER PERMIT FEE  
 \$13,000 11784

SIGNATURE DATE  
 OWNER 5-2-96  
 TITLE DATE

W/S CODE

### FOR OFFICE USE ONLY

DISTANCE IN FEET FROM R/W LINE TO FRONT BUILDING LINE \_\_\_\_\_  
 SIDE YARD (DISTANCE IN FEET FROM SIDE BLDG. LINE TO SIDE PROPERTY LINE) \_\_\_\_\_  
 TO SIDE BUILDING LINE \_\_\_\_\_  
 DISTANCE IN FEET, REAR YD. REQUIRING SET \_\_\_\_\_  
 BACK (CORNER LOT ONLY) \_\_\_\_\_ SDP # \_\_\_\_\_

FUNCTION	DATE	SIGNATURE APPROVAL
ZONING/PLANNING	X	
SHA		
SEDIMENT/GRADING		
BUILDING OFFICIAL	X	
WATER & SEWER		
HEALTH DEPT.	X 5/8/96	A. McMillan
FIRE PROTECTION		
STORM WATER MGMT	X	

Check payable to: DIRECTOR OF FINANCE OF HOWARD COUNTY

**CAUTION**  
 To begin construction before a permit placard has been issued and displayed on the job is a violation of the law.  
 Use and occupancy permit must be applied for two weeks before it will be issued.

IMPORTANT: PLEASE SHOW ZIP CODES AND AREA CODES WHEREVER REQUIRED.

APPROVED

DATE

LP-69-591

CR 307668  
CR 1274

Distribution of Copies:  
 White - Building Official  
 Green - Planning & Zoning

Yellow - Engineering  
 Pink - Health Dept.  
 Gold - S.H.A.