

7-16-80 30788

PERMIT

P 30788

SEWAGE DISPOSAL SYSTEM

A Repair

MARYLAND STATE DEPARTMENT OF HEALTH

HOWARD COUNTY

INDEXED

ELLICOTT CITY

DISTRICT 2nd.

DATE 7/16/80

Tom Hartman IS PERMITTED TO INSTALL ALTER X

ADDRESS 5840 Montgomery Road, ElkrIDGE, Maryland 21227 PHONE 796-3014

SUBDIVISION _____ ROAD 3083 Boone's Lane LOT _____

PROPERTY OWNER Robert J. Martin

ADDRESS 3083 Boone's Lane, Ellicott City, Maryland

ADDRESS _____

SPECIFICATIONS

SEPTIC TANK CAPACITY _____ GALLONS

DRAIN FIELD _____ DEPTH _____ FEET. BOTTOM AREA _____ SQ. FT.

DEEP TRENCH _____ DEPTH _____ FEET. BOTTOM AREA _____ SQ. FT.

SEEPAGE PITS _____ ABSORBENT SIDE-WALL AREA _____ SQ. FT.

INLET PIPE _____ FT. BELOW ORIGINAL GRADE. MAXIMUM DEPTH _____ FT. BELOW ORIGINAL GRADE

EFFECTIVE DEPTH AT _____ FT. BELOW ORIGINAL GRADE.

LOCATE DISPOSAL AREA _____ FT. FROM _____ LOT LINE AND _____ FT. FROM _____ LOT LINE AS SEEN WHEN FACING LOT FROM

REPAIR Install 3 trenches - 50 feet ~~wide~~ bylong - 4 feet wide. Trench to follow constant elevation. Minimum of 1 foot of gravel under pipe. Call for inspection.

PLANS APPROVED BY Fred Frommelt DATE 7/16/80

COVER NO WORK UNTIL INSPECTED AND APPROVED.

NEITHER THE HOWARD COUNTY COUNCIL NOR THE HEALTH DEPARTMENT IS RESPONSIBLE FOR THE SUCCESSFUL OPERATION OF ANY SYSTEM.

NOTE: IF TRENCH IS USED CALL FOR INSPECTION BEFORE PLACING GRAVEL IN TRENCH.

NOTE: NO DRY WELL SHALL EXCEED 15 FOOT IN DIAMETER.

NOTE: ALL PIPE FROM HOUSE TO DISPOSAL AREA MUST BE CAST IRON.

PERMIT VOID AFTER THREE YEARS.


NOTE: INSTALL STAND PIPE ON SEPTIC TANK AND DRY WELL. STAND PIPES MUST BE 6 INCHES IN DIAMETER. CAST IRON, CONCRETE OR TERRAZO ACCEPTED.

REPAIR PERMIT
DATE 7/17/80
for pool # 60015

30788
A 3278

***INSTALLER IS RESPONSIBLE FOR OBTAINING FINAL APPROVAL ON THIS PERMIT**

Boones (Road) Lr.

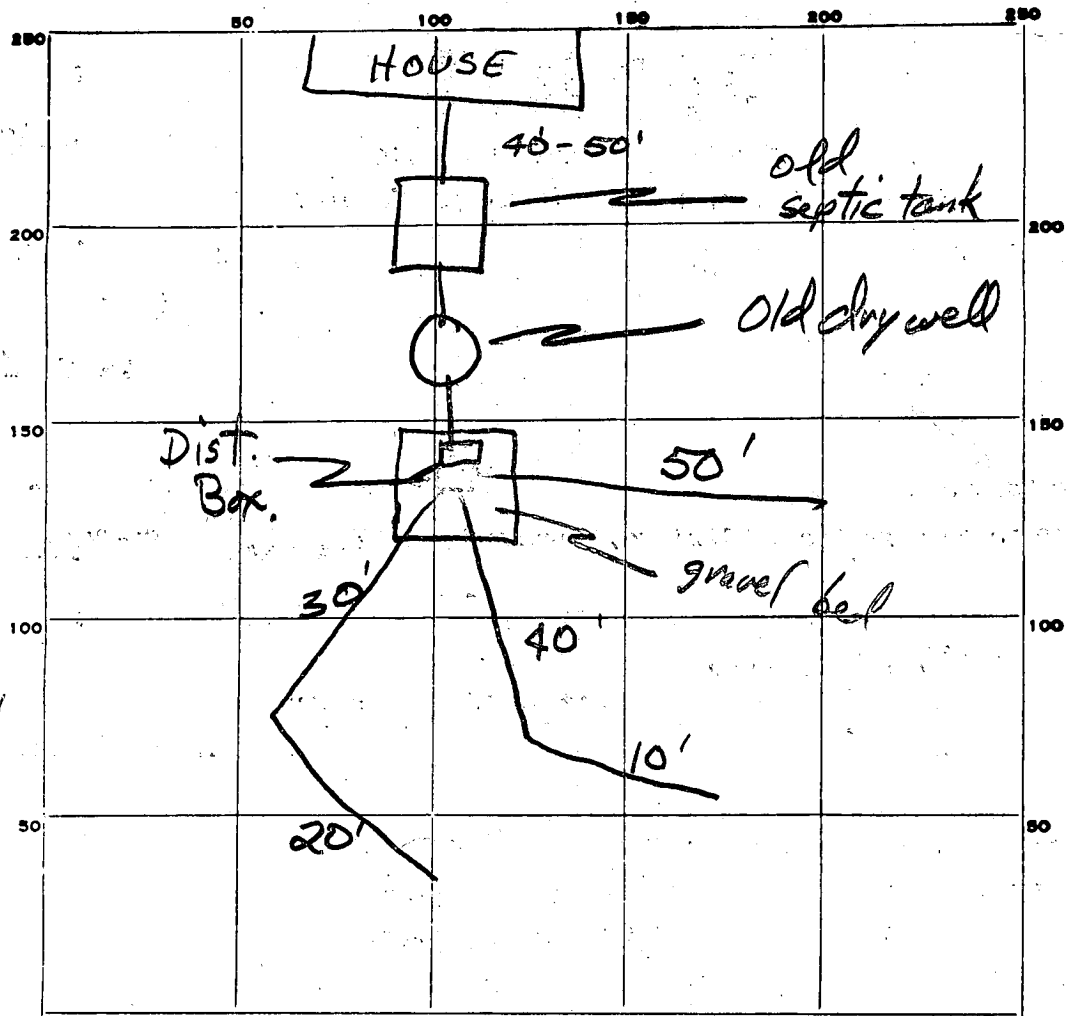

INDICATE NORTH. - NAME ADJOINING ROADWAY AS BASE LINE.

Road

PERMIT CARD _____

SEPTIC TANK, LEVEL N/A CLEANOUTS N/A

DISTRIBUTION BOX, LEVEL

TILE FIELD, DEPTH 3-5 FT. TRENCH WIDTH 3 FT.

GRAVEL DEPTH total 18+ IN. TOTAL LENGTH 50 FT.

NUMBER OF TRENCHES 3 TOTAL BOTTOM AREA 450 #

SEEPAGE PITS, INSIDE DIAMETER _____ FT. DEPTH BELOW INLET _____ FT.

ABSORBENT AREA _____ SQ. FT.

REMARKS _____

APPROVED 7-16-80 INSPECTOR L. J. Howell

1" = 50'

58° 17' W
MULLINE

575' +/-

4' POST & RAIL
FENCE WITH WIRE
TO CODE BY
OWNER

10,000 GPD SEPTIC
REPLACEMENT
AREA

PROPOSED POOL
(25' x 38')

45' +/-

150' +/-

ACCESS

EXISTING PASTURE

EXIST. SHED
(20' x 20')

HOUSE
ROOF

EXISTING
GARAGE

GENERAL
HOUSE
(25' x 28')

EXISTING
SEPTIC
TANK

EXISTING DRY
WELL (REPLACED BY DRAIN
FIELDS)

EXISTING
DRAIN
FIELDS

BOONE'S LANE

30' R.O.W.

N. 08° 13' W. 761.03'

7/16/04 NO PROBLEM

OK TO SIGN 13/14

Bond Beam

3"

Filter Plan