

9/24/80
93210

01-173189

Approved: 9-25-80
Steph. Nail

PERMIT

P 30948

A Repair

SEWAGE DISPOSAL SYSTEM

MARYLAND STATE DEPARTMENT OF HEALTH

HOWARD COUNTY

INDEXED

ELLICOTT CITY

DISTRICT _____

DATE 9/23/80

Otis Ketterman

IS PERMITTED TO INSTALL ~~ALTER~~ X

ADDRESS 4647 Manor Lane, Ellicott City, Md. 21043 PHONE 992-0062

SUBDIVISION _____ ROAD 5938 Montgomery Road LOT _____

PROPERTY OWNER Sidney R. McClure

ADDRESS 5938 Montgomery Road, Elkridge, Maryland

SPECIFICATIONS

SEPTIC TANK CAPACITY _____ GALLONS

DRAIN FIELD _____ DEPTH _____ FEET. BOTTOM AREA _____ SQ. FT.

DEEP TRENCH _____ DEPTH _____ FEET. BOTTOM AREA _____ SQ. FT.

SEEPAGE PITS _____ ABSORBENT SIDE-WALL AREA _____ SQ. FT.

INLET PIPE _____ FT. BELOW ORIGINAL GRADE. MAXIMUM DEPTH _____ FT. BELOW ORIGINAL GRADE

EFFECTIVE DEPTH AT _____ FT. BELOW ORIGINAL GRADE.

LOCATE DISPOSAL AREA _____ FT. FROM _____ LOT LINE AND _____ FT. FROM _____ LOT LINE AS SEEN WHEN FACING LOT FROM

BLDG. PERMIT SIGNED
AND RETURNED 9/26/80
#44396 (Garage)

REPAIR - CALL FOR INSPECTION WHEN GROUND IS OPENED UP SO SANITARIAN CAN RECOMMEND

REPAIR: 70' trench, 4' wide, 4' deep, 2' stone, Disconnect old system SR 9-24-80 Inlet no deeper than 2 1/2' 9K 9-24-80
Replace any damaged pipe with cast iron 9K 9-24-80

PLANS APPROVED BY Palmer F. Wine DATE 9/23/80

COVER NO WORK UNTIL INSPECTED AND APPROVED.

NEITHER THE HOWARD COUNTY COUNCIL NOR THE HEALTH DEPARTMENT IS RESPONSIBLE FOR THE SUCCESSFUL OPERATION OF ANY SYSTEM.

NOTE: IF TRENCH IS USED CALL FOR INSPECTION BEFORE PLACING GRAVEL IN TRENCH.

NOTE: NO DRY WELL SHALL EXCEED 15 FOOT IN DIAMETER.


NOTE: ALL PIPE FROM HOUSE TO DISPOSAL AREA MUST BE CAST IRON.

PERMIT VOID AFTER THREE YEARS.

NOTE: INSTALL STAND PIPE ON SEPTIC TANK AND DRY WELL. STAND PIPES MUST BE 6 INCHES IN DIAMETER. CAST IRON, CONCRETE OR TERRA COTTA ACCEPTED.

***INSTALLER IS RESPONSIBLE FOR OBTAINING FINAL APPROVAL ON THIS PERMIT.**

P. 30948

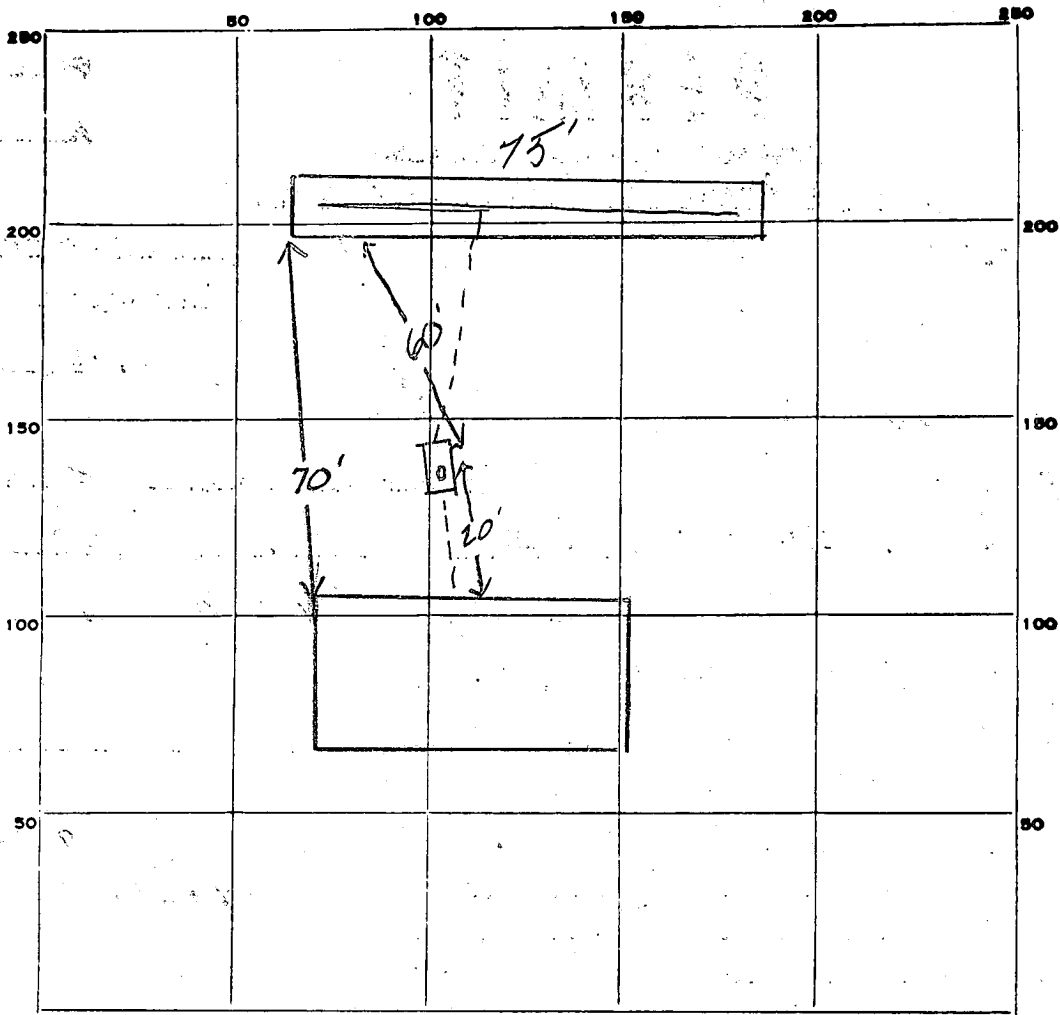

INDICATE NORTH - NAME ADJOINING ROADWAY AS BASE LINE.

PERMIT CARD

SEPTIC TANK, LEVEL _____

CLEANOUTS _____

DISTRIBUTION BOX, LEVEL _____

TILE FIELD, DEPTH 4' Slope FT.

TRENCH WIDTH 4' Slope FT.

GRAVEL DEPTH 2' Slope IN.

TOTAL LENGTH 75' Slope FT.

NUMBER OF TRENCHES 1

TOTAL BOTTOM AREA 300 sq ft

SEEPAGE PITS, INSIDE DIAMETER _____ FT.

DEPTH BELOW INLET _____ FT.

ABSORBENT AREA _____

SQ. FT.

REMARKS

9-27-80

OK for owner to verify length, width depth & gravel depth, SK

I Certify that the Above measurements are correct and accurate, Sidney R. McEllice 9-25-80
OK TO work all work SK 9-25-80

DATE SYSTEM APPROVED

9-25-80

INSPECTOR

Stephen Reil

Check out. ops. of existing
Septic S.

pub sewer available?

ER, mat. Rd

OVERFLOW LEAK OF
HOUSE 100' ft away
over →

Bertling B12,
January

lot 710 Mont. Rd.

wachnola

No
Records
re. these people

September 15, 1980

Mr. Sidney McClure
5938 Montgomery Road
Elkridge, Maryland 21227

Dear Mr. McClure:

Please contact this office as soon as possible regarding the building permit application for a garage on your property in Elkridge. I can be reached at 992-2330.

Very truly yours,

F. A. Skinner

Frank A. Skinner
Sanitarian

FAS:hs

9/17/80 T. C. c. Sidney McClure, he will secure a sewage disp. system repair permit within a week & repair system. Had reservations about doing so as public sewerage system might be available soon. F. A. S.