

11/19/79
please

approved 11/19/79
J. Stayer

PERMIT

P 30349
A 09901

SEWAGE DISPOSAL SYSTEM

MARYLAND STATE DEPARTMENT OF HEALTH

HOWARD COUNTY

ELLCOTT CITY

DISTRICT 5th.

INDEXED

DATE 11/0/79

Michael Kastner IS PERMITTED TO INSTALL ALTER

ADDRESS 13556 Arco Drive, Dayton, Md. PHONE 725-5000

SUBDIVISION Beaufort Park ROAD 8517 Beaufort Drive LOT 2, Blk R,

PROPERTY OWNER Donald Brescia

ADDRESS 8521 Beaufort Drive, Fulton, Md. 20759

SPECIFICATIONS 4 Bedrooms

SEPTIC TANK CAPACITY 1250 GALLONS

DRAIN FIELD _____ DEPTH _____ FEET, BOTTOM AREA _____ SQ. FT.

DEEP TRENCH _____ DEPTH _____ FEET, BOTTOM AREA _____ SQ. FT.

SEEPAGE PITS _____ ABSORBENT SIDE-WALL AREA _____ SQ. FT.

INLET PIPE _____ FT. BELOW ORIGINAL GRADE. MAXIMUM DEPTH _____ FT. BELOW ORIGINAL GRADE

EFFECTIVE DEPTH AT _____ FT. BELOW ORIGINAL GRADE.

LOCATE DISPOSAL AREA _____ FT. FROM _____ LOT LINE AND _____ FT. FROM _____ LOT LINE AS SEEN WHEN
FACING LOT FROM

Deep Trench: The invert will enter the trench at 3 ft. below original grade and maximum trench depth will not exceed 10 feet. The trench will be dug 2 feet wide, 100 feet long, and contain 7 feet of stone. The trench will begin at a point 40 feet from the left property line and 150 feet from the front property line as seen from the road. Direct the trench with the contour towards the right property line.

NOTE: TRENCHES NOT TO BE CONNECTED IN SERIES. MUST USE DISTRIBUTION BOX OR T'S AND CONNECT TO END NEAREST SEPTIC TANK. TWO INSPECTIONS.

PLANS APPROVED BY George Keller DATE 5/8/79

COVER NO WORK UNTIL INSPECTED AND APPROVED.

NEITHER THE HOWARD COUNTY COUNCIL NOR THE HEALTH DEPARTMENT IS RESPONSIBLE FOR THE SUCCESSFUL OPERATION OF ANY SYSTEM.

NOTE: IF TRENCH IS USED CALL FOR INSPECTION BEFORE PLACING GRAVEL IN TRENCH.

NOTE: NO DRY WELL SHALL EXCEED 16 FOOT IN DIAMETER.

NOTE: ALL PIPE FROM HOUSE TO DISPOSAL AREA MUST BE CAST IRON.


PERMIT VOID AFTER THREE YEARS.

NOTE: INSTALL STAND PIPE ON SEPTIC TANK AND DRY WELL. STAND PIPES MUST BE 8 INCHES IN DIAMETER. CAST IRON, CONCRETE OR TERRA COTTA ACCEPTED.

***INSTALLER IS RESPONSIBLE FOR OBTAINING FINAL APPROVAL ON THIS PERMIT.**

A 09901

150
4
600

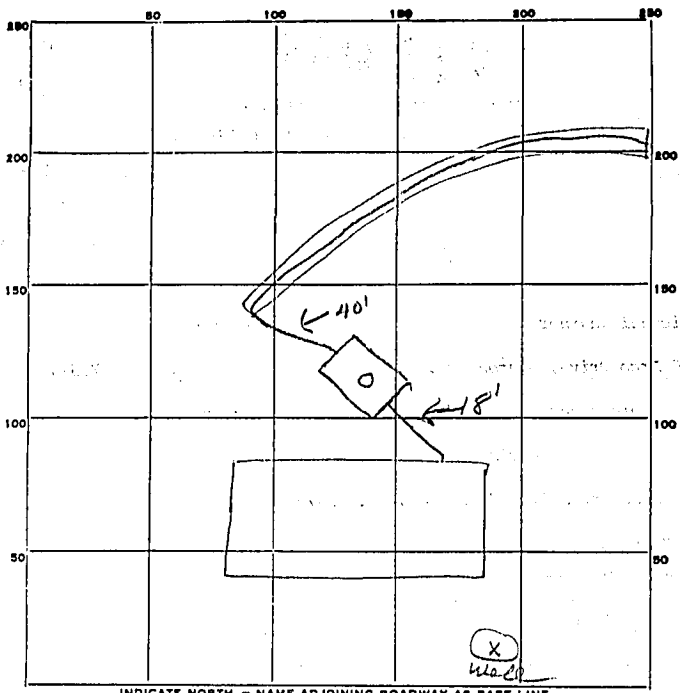

INDICATE NORTH. - NAME ADJOINING ROADWAY AS BASE LINE.

Beaufort Dr.

PERMIT CARD _____

SEPTIC TANK, LEVEL

CLEANOUTS ST / Cast Iron

DISTRIBUTION BOX, LEVEL _____

TILE FIELD, DEPTH 10 FT. TRENCH WIDTH 2 FT.

GRAVEL DEPTH 7 IN. TOTAL LENGTH 100 FT.

NUMBER OF TRENCHES 1 TOTAL BOTTOM AREA 700

SEEPAGE PITS, INSIDE DIAMETER _____ FT. DEPTH BELOW INLET _____ FT.

ABSORBENT AREA 700 SQ. FT.

REMARKS 11/9/79 - not ready - will check later today (10:30) JD

11/9/79 (2:00) OK to add gravel in trench. Jf

11/19/79 OK to cover all around. Jf

Well permit 73-3216 73' case, 50' open, set to 68', 20 days cement

Jf 5/8/79

DATE SYSTEM APPROVED 11/19/79 INSPECTOR J. Stoney