

SEWER SYSTEM TO BE
INSTALLED FIRST BEFORE
BUILDING PERMIT IS
SIGNED

PERMIT

SEWAGE DISPOSAL SYSTEM

P-25266

A19539

MARYLAND STATE DEPARTMENT OF HEALTH

HOWARD COUNTY

ELLICOTT CITY

DISTRICT 8th

DATE 2/18/77

3/19/77
2/11/77
10/25/77 ← House connection
OS-377633

INDEXED

Souder Builders, Inc. IS PERMITTED TO INSTALL X ALTER

ADDRESS 14269 Triadelphia Hill Road, Dayton, MD. PHONE _____

A SEWAGE DISPOSAL SYSTEM LOCATED AT _____

SUBDIVISION Linden Chapel Hills ROAD 13572 Army Drive LOT 21, Blk. C, Sec. 4

PROPERTY OWNER Frank F. Willson, & Wife (WURLEY - NEW OWNER)

ADDRESS c/o Ashton Realty Company, Ashton, MD. 20702

SPECIFICATIONS 3 bedrooms

DRAIN FIELD _____ DEPTH _____ FEET, BOTTOM AREA _____ SQ. FT.

SEEPAGE PITS _____ ABSORBENT SIDE-WALL AREA _____ SQ. FT. ~~_____~~
SEPTIC TANK CAPACITY 1000 GALLONS

FOR GARBAGE GRINDER, INCREASE DISPOSAL AREA 25% & TANK CAPACITY 50%.

OTHER DRY WELL-120 Sq. feet per bedroom, Dry well inlet to be 3 1/2 feet dia, and bottom of dry well to be 11 feet deep. Place dry well 125 feet from front lot line and 20 feet from right side of lot as seen when facing lot from Army Drive.

NOTE: ALL PIPE FROM HOUSE TO DISPOSAL AREA MUST BE CAST IRON. PERMIT VOID AFTER THREE YEARS.

NOTE: INSTALL STAND PIPE ON SEPTIC TANK AND DRY WELL. STAND PIPES MUST BE 6 INCHES IN DIAMETER. CAST IRON, CONCRETE OR TERRA COTTA ACCEPTED.

PLANS APPROVED BY Raymond Hodges DATE 10/21/75


FILL SEPTIC TANK AND DISTRIBUTION BOX WITH WATER BEFORE CALLING FOR AN INSPECTION. COVER NO WORK UNTIL INSPECTED AND APPROVED.

NEITHER THE HOWARD COUNTY COMMISSIONERS NOR THE HEALTH DEPARTMENT IS RESPONSIBLE FOR THE SUCCESSFUL OPERATION OF ANY SYSTEM.

BLDG. PERMIT SIGNED
AND RETURNED 9/26/96
Serial # B00103394
addition sunroom

A19539

A 25266

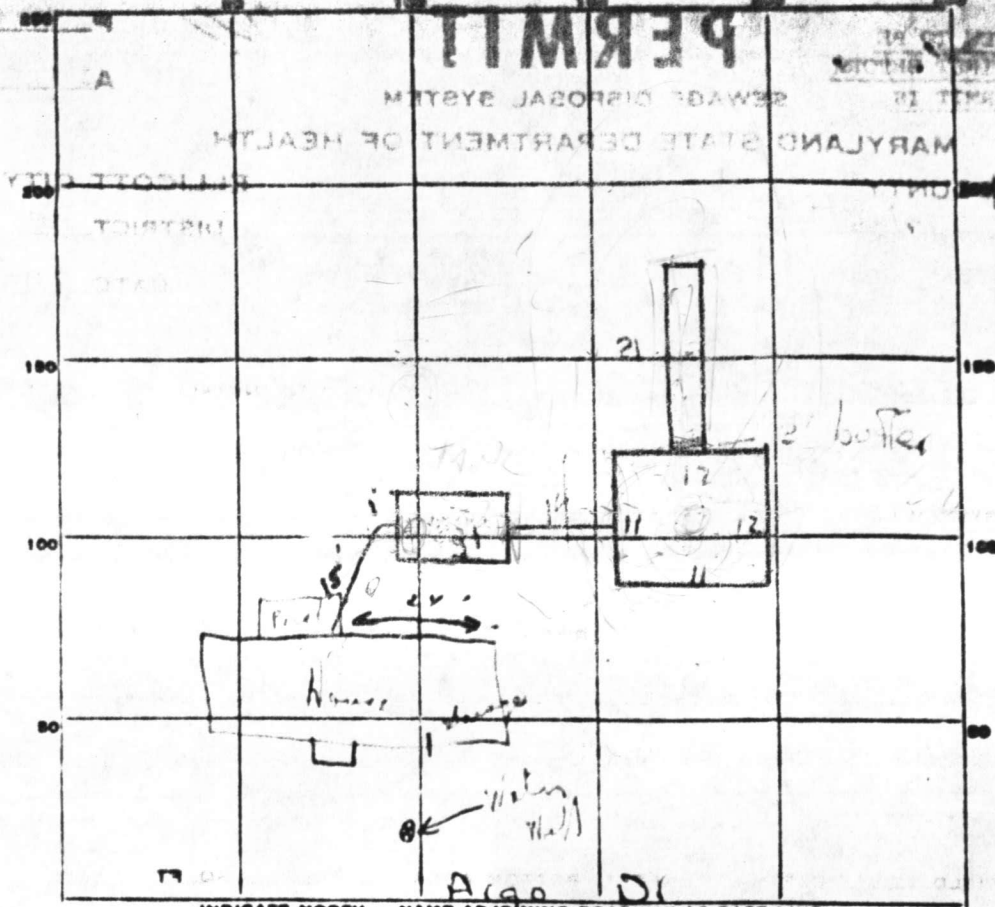

PERMIT CARD cost present, not done 10/25/77 DW / ST
 SEPTIC TANK, LEVEL 1002 CLEANOUTS no / no
 DISTRIBUTION BOX, LEVEL N/A yes/no -> yes

TILE FIELD, DEPTH 11 FT. TRENCH WIDTH 2 FT.
 GRAVEL DEPTH 7 IN. TOTAL LENGTH 21 FT.
 NUMBER OF TRENCHES 1 one side
 TOTAL BOTTOM AREA _____

SEEPAGE PITS, INSIDE DIAMETER 46 FT. DEPTH BELOW INLET 7.5 FT. 34/5 ft in DW
 ABSORBENT AREA 292 SQ. FT. 197
4.2

REMARKS March 9 1977 - HB - unable to measure depth in DW -
3-11-77 - HB - install perforated pipe on top of stone in trench -
place approved paper on top of all stone
11/11/77 all work done HB 17 May 7
10/25/77 have connection work pipe from tank to
land

DATE SYSTEM APPROVED 10/25/77 INSPECTOR C. B. Street

APPLICATION

19539

SEWAGE DISPOSAL TESTING

P _____

STATE OF MARYLAND - DEPARTMENT OF HEALTH AND MENTAL HYGIENE

HOWARD COUNTY HEALTH DEPARTMENT
ENVIRONMENTAL HEALTH SERVICES
P. O. BOX 476, ELLICOTT CITY, MARYLAND 21043
TELEPHONE: 465-5000, EXT. 386

DISTRICT 9th

DATE 2/11/74

TO: THE COUNTY HEALTH OFFICER
ELLICOTT CITY, MARYLAND

I, HEREBY, APPLY FOR THE NECESSARY TEST IN ORDER TO CONSTRUCT (OR RECONSTRUCT) A SEWAGE DISPOSAL SYSTEM.

PROPERTY OWNER Frank F. Willson and Wife, Et. Al.

ADDRESS e/o Ashton Realty Company, Ashton, Md. 20702

Any questions call Mr. Johnson:
PHONE 924-4021

PROPERTY LOCATION:

SUBDIVISION Linden Chapel Hills

new 23C
LOT NO. 27, Blk. C, Sec. 4

ROAD AND DESCRIPTION Arco Drive

SIZE OF LOT 44,100 sq. ft. ±

TYPE BLDG. 3 or 4 bedrooms

NUMBER OF BEDROOMS

IF NOT SINGLE RESIDENCE DESCRIBE _____

THE SYSTEM INSTALLED UNDER THIS APPLICATION IS ACCEPTABLE ONLY UNTIL PUBLIC FACILITIES BECOME AVAILABLE.

SIGNATURE OF APPLICANT /s/ Robert Johnson

APPROVED BY _____ FOR _____ DATE _____
(KIND OF SYSTEM)

REJECTED BY _____ FOR _____ DATE _____
(KIND OF SYSTEM)

HOLD PENDING FURTHER TESTS _____ DATE _____

REASONS FOR REJECTION OR HOLDING _____

THIS IS NOT A PERMIT

APPLICATION

A 19540

SEWAGE DISPOSAL TESTING

P _____

STATE OF MARYLAND - DEPARTMENT OF HEALTH AND MENTAL HYGIENE

HOWARD COUNTY HEALTH DEPARTMENT
ENVIRONMENTAL HEALTH SERVICES

DISTRICT 9th

P. O. BOX 476, ELLICOTT CITY, MARYLAND 21043
TELEPHONE: 465-5000, EXT. 366

DATE 2/11/74

TO THE COUNTY HEALTH OFFICER
ELLICOTT CITY, MARYLAND

I, HEREBY, APPLY FOR THE NECESSARY TEST IN ORDER TO CONSTRUCT (OR RECONSTRUCT) A SEWAGE DISPOSAL SYSTEM.

PROPERTY OWNER Frank F. Willson and Wife, Et. Al

ADDRESS c/o Ashton Realty Company, Ashton, Md. 20702

Any questions call Mr. Johnson:
PHONE 924-4811

PROPERTY LOCATION:

SUBDIVISION Linden Chapel Hills

new 23 C

LOT NO. 26, Blk. C, Sec. 4

ROAD AND DESCRIPTION "Unnamed Road"

SIZE OF LOT 50,400 sq. ft. ±

TYPE BLDG. 3 or 4 bedrooms

NUMBER OF BEDROOMS

IF NOT SINGLE RESIDENCE DESCRIBE _____

THE SYSTEM INSTALLED UNDER THIS APPLICATION IS ACCEPTABLE ONLY UNTIL PUBLIC FACILITIES BECOME AVAILABLE.

SIGNATURE OF APPLICANT /s/ Robert Johnson

APPROVED BY _____ FOR _____ DATE _____
(KIND OF SYSTEM)


REJECTED BY _____ FOR _____ DATE _____
(KIND OF SYSTEM)

HOLD PENDING FURTHER TESTS _____ DATE _____

REASONS FOR REJECTION OR HOLDING _____

THIS IS NOT A PERMIT

APPLICATION

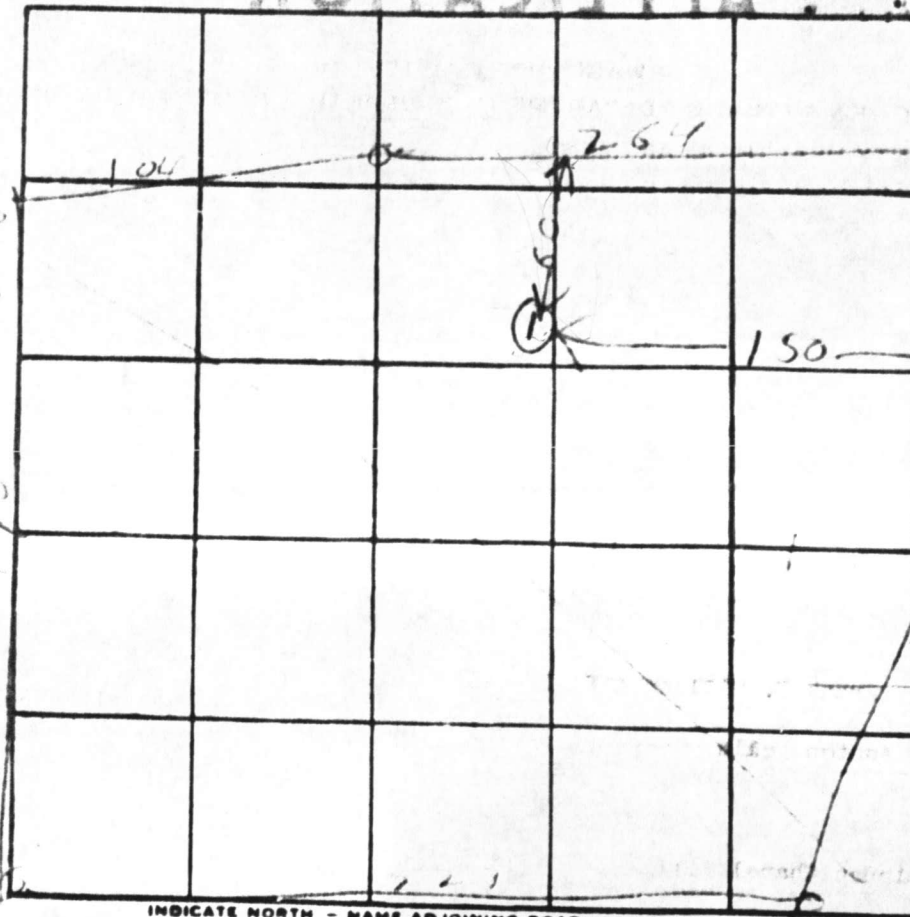

INDICATE NORTH - NAME ADJOINING ROADWAY AS BASE LINE

UNIMPROVED

DATE	TEST NO.	DEPTH	PRE-WET		TEST - 1" DROP		TIME
			START	STOP	START	STOP	
3/1/24	1	11 1/2	TOP	7 FT	7	CLAY	WATER AT
			BOT	4 FT	7	SAND	11 FT

Non
Bouldable


new
Lot 23C

REMARKS _____
 TYPE OF SOIL _____
 TESTED BY [Signature] _____
 ALSO PRESENT: [Signature]

The plot of land shown on a document may appear to be required by a zoning or other regulation or by a local ordinance with reference to the use of the land. The plot is not to be used for the establishment of any other use, structure, building or other structure or for any other purpose not shown on the plan. The plot does not guarantee the establishment of any other use, structure, building or other structure or for any other purpose not shown on the plan. The plot does not guarantee the establishment of any other use, structure, building or other structure or for any other purpose not shown on the plan.

N/F
MARTIN S.
THALER
498/543

N/F
JACKSON A.
BAXON
4-53/602

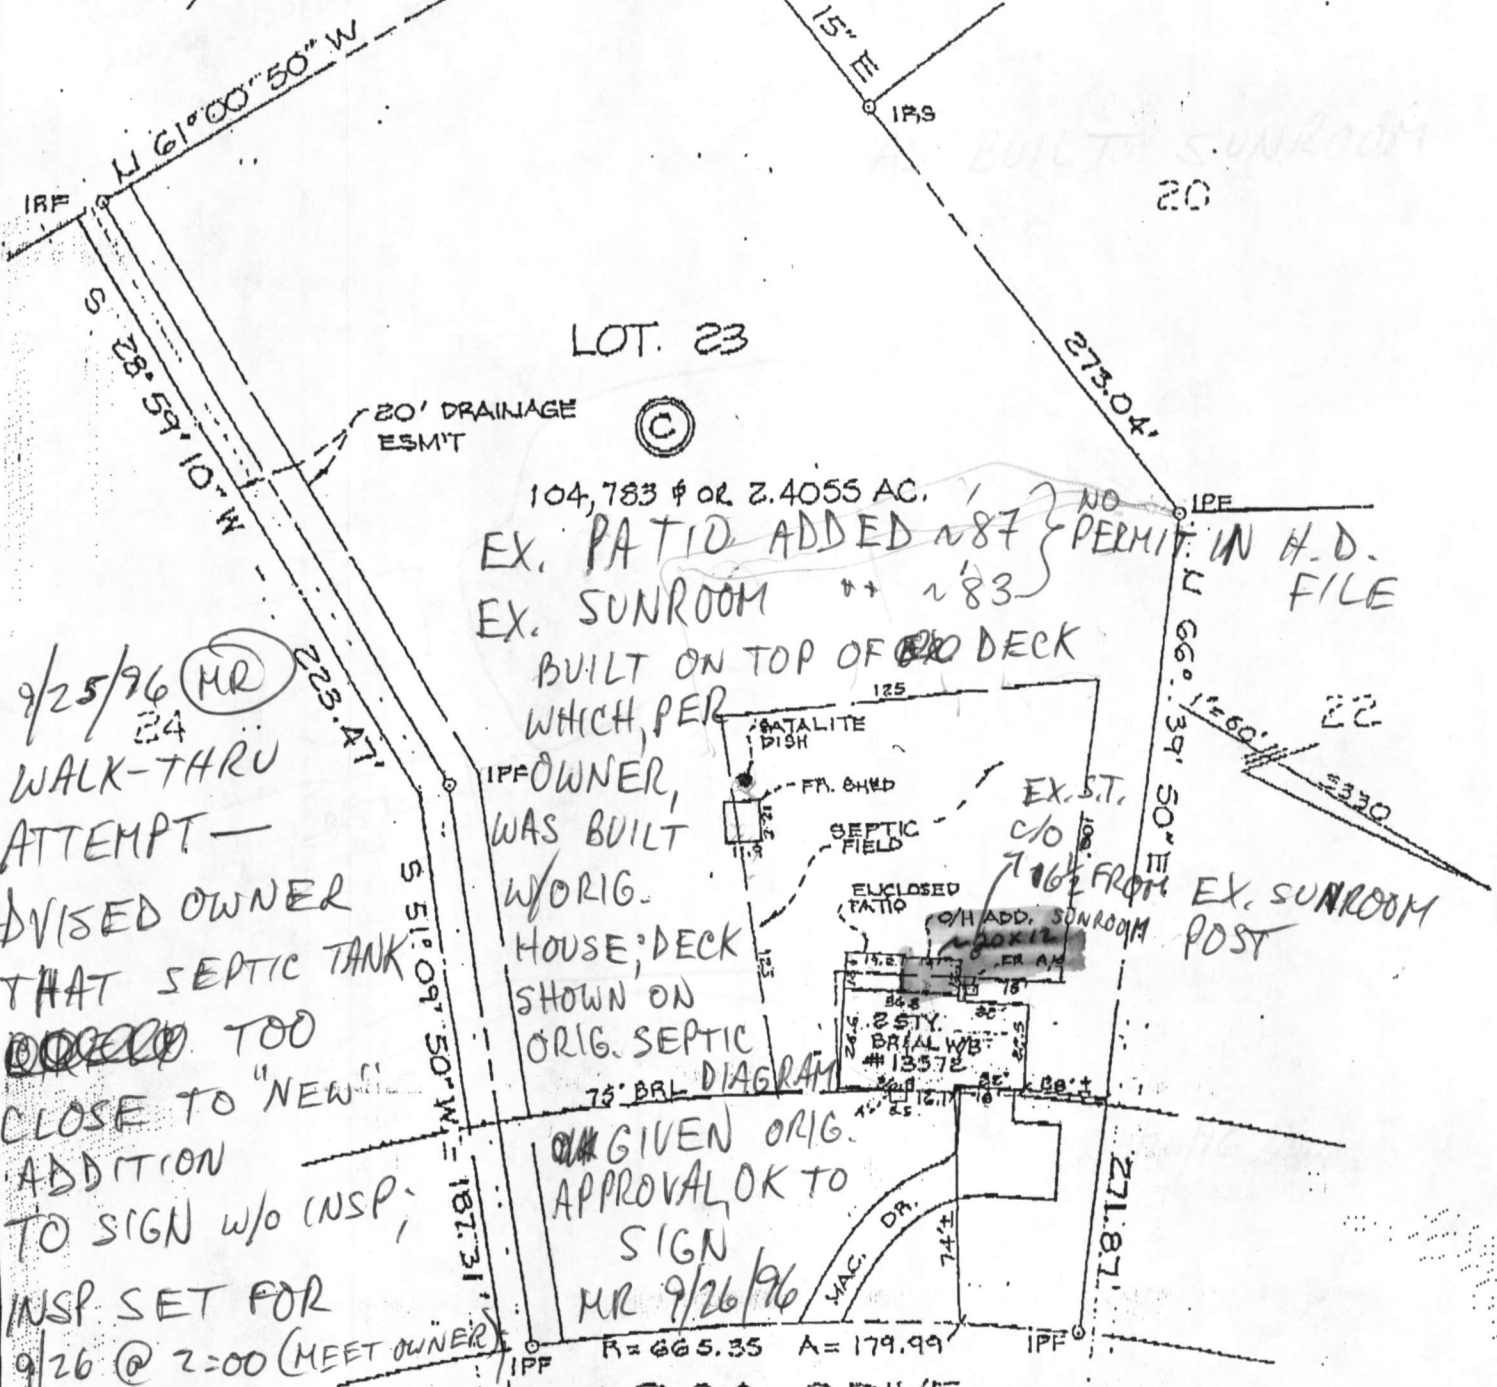

9/25/96 MR
24
WALK-THRU
ATTEMPT -
ADVISED OWNER
THAT SEPTIC TANK
TOO
CLOSE TO "NEW"
ADDITION
TO SIGN w/o INSP;
INSP SET FOR
9/26 @ 2:00 (MEET OWNER)
REPAIR TO MOVE S.T.
LIKELY REQ'D. ADVISED OWNER
THAT COMMITMENT (WRITTEN) TO
REPAIR SUFF. FOR BP SIG
IN LIGHT OF 9/27 SALE SETTLEMENT

104,783 sq ft OR 2.4055 AC.
EX. PATIO ADDED 1987 } NO PERMIT IN H.D. FILE
EX. SUNROOM 1983 }

BUILT ON TOP OF DECK
WHICH, PER
OWNER,
WAS BUILT
W/ ORIG.
HOUSE; DECK
SHOWN ON
ORIG. SEPTIC
75' BRL DIAGRAM

GIVEN ORIG.
APPROVAL OK TO
SIGN
MR 9/26/96

ARGO DRIVE

NOTES:
LOT located in a HUD designated Flood Hazard Zone as per FEMA Community Panel No. ZA0044 0024 B
Prepared without the benefit of a title report.
Information shown hereon should not be relied upon for construction of improvements.

P. 258 / 44

I hereby certify that I have surveyed the property shown hereon for the purpose of locating the improvements only, and the improvements are located as shown. Exact property corners have not been established or set, unless otherwise noted. We assume no responsibility or liability for any rights-of-way or easements recorded or unrecorded not appearing on the record plat or mentioned in the title deed referred to herein.

Marwan Faris Mustafa
Date: 9/25/96



LOT IMPROVEMENT SURVEY
13572 ARGO DRIVE
LOT 23 BLOCK "C" SECTION A
LINDEN CHAPEL HILLS
CLARKSVILLE 5TH Election District
HOWARD County, Maryland

LIGHT, ELLIOTT & ASSOCIATES, INC. 8508 Adelphi Road Adelphi, Maryland 20783 Phone 801-422-6080 FAX 422-6086	Draft: JCS CKI	Plat Book / Page 3930	Case Number W.B.C.M. 96-0133
	Job No. 15499	Liber / Folio	Scale 1" = 50'