

LAYOUT 12/20/2005 INSP 4 _____
INSP 2 12/21/2005 INSP 5 _____
INSP 3 12/22/2005 INSP 6 _____

ISSUE DATE: 11/17/05

P 523689

APPROVAL DATE: 10/10/06

A UPGRADE 09901

PERMIT

TAX ID # **05-344034**

ON-SITE SEWAGE DISPOSAL SYSTEM HOWARD COUNTY HEALTH DEPARTMENT BUREAU OF ENVIRONMENTAL HEALTH

Fogles Septic Clean, Inc. IS PERMITTED TO INSTALL ALTER

ADDRESS: 580 Obrecht Rd., Sykesville 21784 PHONE NUMBER: 410-795-5670

SUBDIVISION: Beaufort Park LOT NUMBER: 2

ADDRESS: 8517 Beaufort Drive PROPERTY OWNER: Marlene Brescia

SEPTIC TANK CAPACITY (GALLONS): 1500 OUTLET BAFFLE FILTER REQUIRED
MICROFAST 0.75 TREATMENT SYSTEM

PUMP CHAMBER CAPACITY (GALLONS) N/A COMPARTMENTED TANK REQUIRED

NUMBER OF BEDROOMS: 5

SQUARE FEET PER BEDROOM: 180

LINEAR FEET OF TRENCH REQUIRED: shared HOUSE SERVED BY PUBLIC WATER


TRENCHES:	Lot 2 will have a nitrogen pretreatment on the existing septic system with a MicroFast 0.75 Pretreatment along with the force main & trenches for lot #9 to be installed prior to building permit approval for lot #9.
LOCATION:	Pump and collapse old septic tank, place new septic tank with MicoFast 0.75 unit outside of well radii.
NOTES:	Purpose of permit is to upgrade septic system for lot 2 prior to building permit approval for lot 9 to create a perpetual septic easement between lot 2 & 9.

PLANS APPROVED: Sara Fegel Reviewed by: Gabe Creighton DATE: 11/18/05

NOTES: PERMIT VOID AFTER 2 YEARS
CONTRACTOR IS RESPONSIBLE FOR SCHEDULING A PRE-CONSTRUCTION INSPECTION FOR ALL INSTALLATIONS
WATERTIGHT SEPTIC TANKS REQUIRED
ALL PARTS OF SEPTIC SYSTEM SHALL BE 100 FEET FROM ANY WATER WELL UNLESS SPECIFICALLY AUTHORIZED
MANHOLE RISERS REQUIRED ON ALL SEPTIC TANKS AND PUMP CHAMBERS UNLESS SPECIFICALLY AUTHORIZED
CONTRACTOR RESPONSIBLE FOR COMPLIANCE WITH APPLICABLE REGULATIONS, GUIDELINES AND THE TERMS OF THIS PERMIT

**NEITHER THE HOWARD COUNTY COUNCIL NOR THE HEALTH DEPARTMENT IS
RESPONSIBLE FOR THE SUCCESSFUL OPERATION OF ANY SYSTEM
PERMITTEE RESPONSIBLE FOR OBTAINING FINAL APPROVAL ON THIS PERMIT
ALL 410-313-1771 FOR INSPECTION OF SEPTIC SYSTEM**

NOT TO SCALE

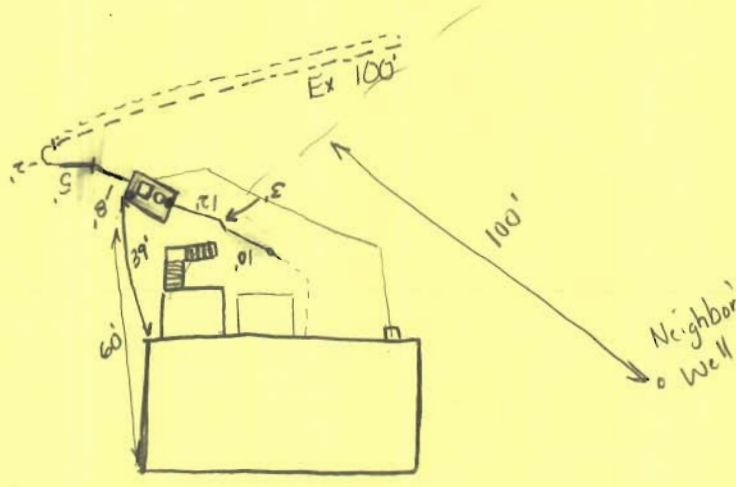

TRENCH/DRAINFIELD DATA		
WIDTH	INLET	BOTTOM
_____	_____	_____
NUMBER OF TRENCHES _____		
TOTAL LENGTH _____		
ABSORPTION AREA _____		
DISTRIBUTION BOX LEVEL _____		
DISTRIBUTION BOX BAFFLE _____		
DISTRIBUTION BOX PORT _____		

SEPTIC TANK DATA		
SEPTIC TANK 1 LEVEL _____		
w/	CAPACITY	1500 GAL
micro	SEAM LOC	Top
fast	TANK LID DEPTH	2-2 1/2'
.75	BAFFLES	yes
unit	BAFFLE FILTER	No
	MANHOLE LOC	Mid Inlet compartment
	8" PORT LOC	Inlet & Outlet
	WATERTIGHT TEST	No
SEPTIC TANK 2 LEVEL _____		
	CAPACITY	_____ GAL
	SEAM LOC	_____
	TANK LID DEPTH	_____
	BAFFLES	_____
	BAFFLE FILTER	_____
	MANHOLE LOC	_____
	6" PORT LOC	_____
	WATERTIGHT TEST	_____

PRE-CONSTRUCTION 12/20/05 Install New 1500 w/ FAST, 75 unit (outside well radius) tie into existing 100' trench. Abandon old septic tank & fill w/ gravel

INSTALLATION 12/20/05 Tank set and tied into. OK to cover line out of tank. 12/21/05 line out of house tied into new tank, Old tank abandoned, filled w/ gravel line run over is. Original cast iron is in great shape. OK to cover. 12/22/05 Blower hooked up. Tank still needs 8" lids for cleanouts. Need start-up/abnorm test. 10/10/06 Aerator and aerator alarm working correctly. (BB)

FINAL INSPECTOR B. Baker DATE OF APPROVAL 10/10/06

SEPTIC SYSTEM REPAIR / UPGRADE / EVALUATION REQUEST

Please fill out this form completely and check off the reason for the request:

Date requested: 11/17/05

Reason for Request

Failing System (includes surface discharge or inadequate treatment zone) _____

Has the contractor verified through excavation/pumping evaluation, that there are no pipe blockages?

In support of a building permit. Type of building addition: SFD

*System relocation for proposed addition for setback compliance _____

*Verification of adequate system capacity per COMAR 26.04.02.02D (4) _____

To replace collapsed septic tank or upgrade tank capacity _____

To replace collapsed drywell _____

Septic Contractor: Fogle's Septic Clean Inc

Contractor's Address: 580 Obrecht Rd
Sykesville, MD 21784

Contractor's Phone #: 410 795-5670

Property Address: 8517 Beaufort Dr

Property (Subdivision) & Lot # 2 Beaufort Park

Owner's Name: Minam Brescia

Is public sewer available/nearby: _____

Names of Any Previous Owners: _____

Year House Built: _____

of Existing Bedrooms: 3

of Bedrooms after completion of addition: N/A

Has this request been discussed previously with a Sanitarian, who? _____

If public sewer is close, further research will be performed to verify availability and possible hook up to public sewer.

A Sanitarian will be in contact within three business days depending upon the urgency of the situation to coordinate the scheduling of the repair /upgrade/evaluation. No inspection will be performed without fee collection at the office.

Environmental Sanitarian tentatively assigned _____

PLEASE ADD TO

approved 11/19/79
J. Stagers

~~11/17/79~~
11/19/79
for please

PERMIT THIS FILE

P. 34349

A 09901

SEWAGE DISPOSAL SYSTEM

MARYLAND STATE DEPARTMENT OF HEALTH

HOWARD COUNTY

ELLICOTT CITY

DISTRICT 5th.

INDEXED

DATE 11/8/79