

*Septer
First*

1/2/80 house connection

41182

APPROVED
11 21 80
J S R H
P *30264*

PERMIT

05-384362

A25712

SEWAGE DISPOSAL SYSTEM

MARYLAND STATE DEPARTMENT OF HEALTH

HOWARD COUNTY

ELLICOTT CITY

DISTRICT 5th

*10/19/79
trench a.m.
final p.m.*

*10/22/79
a.m. please*

(10:30-11:30)
BLDG. PERMIT SIGNED
AND RETURNED *10/29/79*
Serial # 41182

DATE 10/4/79

INDEXED

Bob Orndorff

IS PERMITTED TO INSTALL ALTER

ADDRESS _____ PHONE _____

SUBDIVISION Simpson Woods ROAD 7237 Meadow Wood Way LOT 13, Sec. 2

PROPERTY OWNER Nu-Homes, Inc.

ADDRESS 6655H Dobbin Road, Columbia, Md.

SPECIFICATIONS 4 bedrooms

SEPTIC TANK CAPACITY 1250 GALLONS

DRAIN FIELD _____ DEPTH _____ FEET, BOTTOM AREA _____ SQ. FT.

DEEP TRENCH _____ DEPTH _____ FEET, BOTTOM AREA _____ SQ. FT.

SEEPAGE PITS ABSORBENT SIDE-WALL AREA 300 SQ. FT. *in dry well.*

INLET PIPE 4 FT. BELOW ORIGINAL GRADE. MAXIMUM DEPTH 10 FT. BELOW ORIGINAL GRADE

EFFECTIVE DEPTH AT _____ FT. BELOW ORIGINAL GRADE.

LOCATE DISPOSAL AREA 70 FT. FROM rear LOT LINE AND 60 FT. FROM right LOT LINE AS SEEN WHEN FACING LOT FROM Meadow Wood Way.

TRENCH-to be 54 ft. long with total absorption area of 300 sq. ft. Inlet to be 4 1/4 and maximum depth 10 ft. Come off right side of dry well, run trench towards right lot line. Follow contour to keep trench level.

**NOTE: LEAVE A 5 FT. EARTH BUFFER BETWEEN DRY WELL AND TRENCH.
MANHOLE TYPE CLEANOUT TO FINAL GRADE LEVEL.**

PLANS APPROVED BY ~~XXXXXXXXXXXX~~ William Zepp DATE 1/9/78

COVER NO WORK UNTIL INSPECTED AND APPROVED.

NEITHER THE HOWARD COUNTY COUNCIL NOR THE HEALTH DEPARTMENT IS RESPONSIBLE FOR THE SUCCESSFUL OPERATION OF ANY SYSTEM.

NOTE: IF TRENCH IS USED CALL FOR INSPECTION BEFORE PLACING GRAVEL IN TRENCH.

NOTE: NO DRY WELL SHALL EXCEED 15 FOOT IN DIAMETER.

NOTE: ALL PIPE FROM HOUSE TO DISPOSAL AREA MUST BE CAST IRON.

PERMIT VOID AFTER THREE YEARS.


NOTE: INSTALL STAND PIPE ON SEPTIC TANK AND DRY WELL. STAND PIPES MUST BE 6 INCHES IN DIAMETER. CAST IRON, CONCRETE OR TERRAZO ACCEPTED.

***INSTALLER IS RESPONSIBLE FOR OBTAINING FINAL APPROVAL ON THIS PERMIT.**

BLDG. PERMIT SIGNED
AND RETURNED 5/5/81

*Serial # 46421
Screeded patch*

A25712

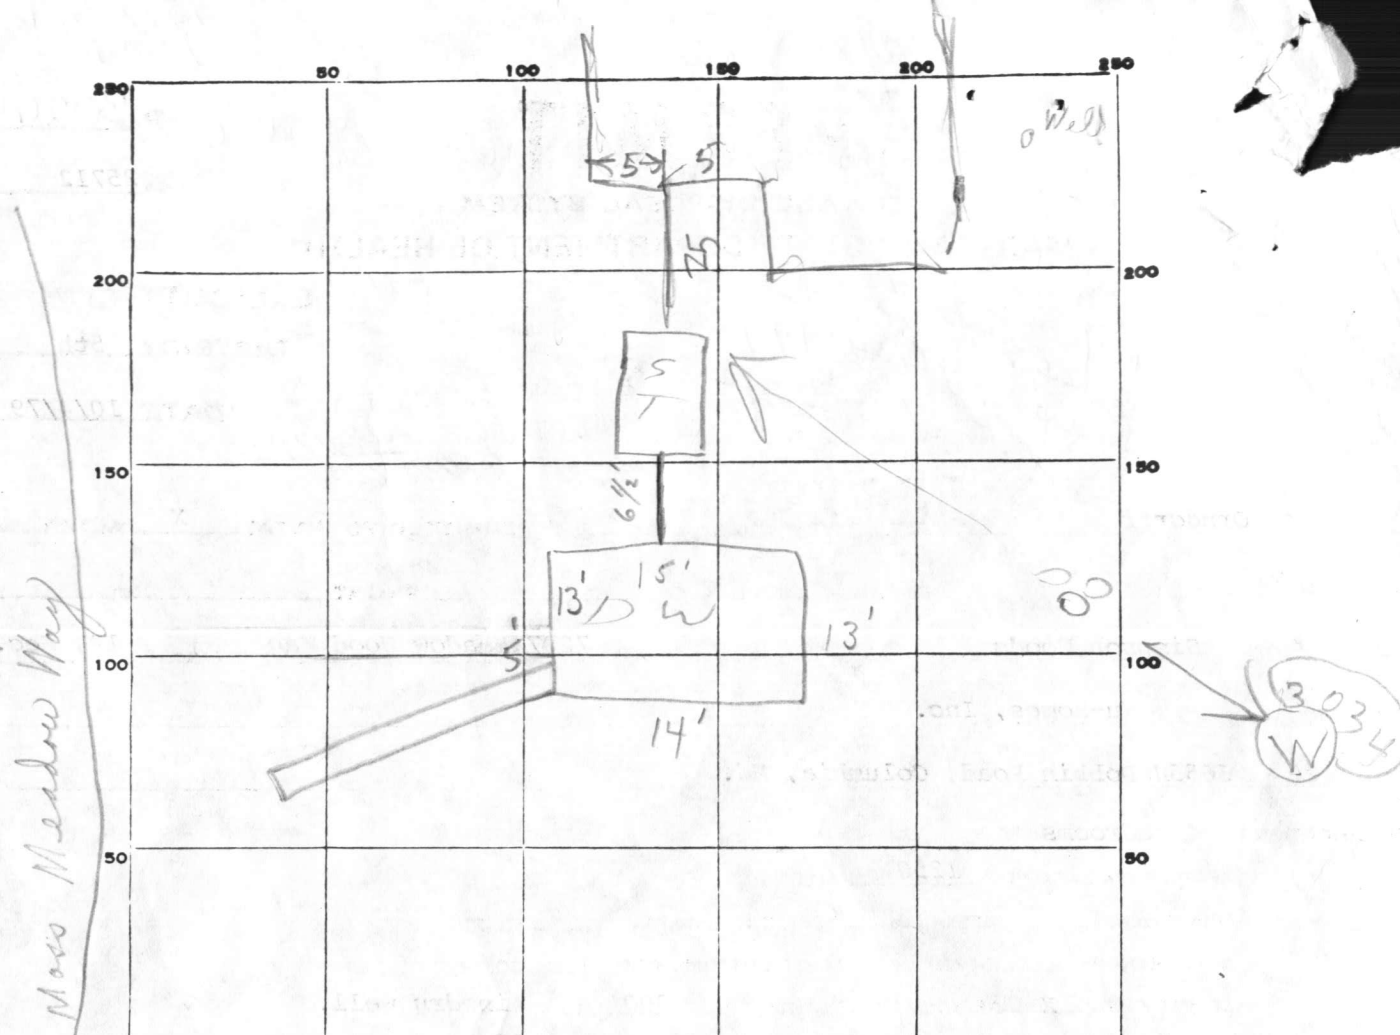

INDICATE NORTH. - NAME ADJOINING ROADWAY AS BASE LINE.

PERMIT CARD

✓ NO 1/480

SEPTIC TANK, LEVEL

✓

CLEANOUTS

ST | DW

DISTRIBUTION BOX, LEVEL

✓ | ✓

TILE FIELD, DEPTH

10

FT.

TRENCH WIDTH

2

FT.

GRAVEL DEPTH

5.75¹⁺

IN.

TOTAL LENGTH

55

FT.

316.25

NUMBER OF TRENCHES

1

TOTAL BOTTOM AREA

SEEPAGE PITS, INSIDE DIAMETER

55

FT.

DEPTH BELOW INLET

6⁺

FT.

330

ABSORBENT AREA

646.25

SQ. FT.

REMARKS

10/19/79 - OK to add gravel to trench.

Phynwell depth measured at 7 1/2 ft. 10/22/79 Partial

NEED TO SEE HOUSE CONNECTION-PIPE FROM TANK TO

HOUSE, C.B.S. OK TO COVER TO SEPTIC TANK, C.B.S.

1/2/80 - HOUSE HOOK UP OK.

DATE SYSTEM APPROVED

1/2/80

INSPECTOR

R H J S

APPLICATION

A 25712

P _____

SEWAGE DISPOSAL TESTING

STATE OF MARYLAND - DEPARTMENT OF HEALTH AND MENTAL HYGIENE

DISTRICT 5th

HOWARD COUNTY HEALTH DEPARTMENT
ENVIRONMENTAL HEALTH SERVICES
P. O. BOX 476, ELLICOTT CITY, MARYLAND 21043
TELEPHONE: 465-5000, EXT. 356

DATE 4-21-77

$$\bar{t} = 8\sqrt{89} = 72 \text{ min}$$

TO: THE COUNTY HEALTH OFFICER
ELLICOTT CITY, MARYLAND

I, HEREBY, APPLY FOR THE NECESSARY TEST IN ORDER TO CONSTRUCT (OR RECONSTRUCT) A SEWAGE DISPOSAL SYSTEM.

PROPERTY OWNER Phase II Ltd. Nu-Jones, Inc.

ADDRESS c/o Landborg, Inc., 1000 Century Plaza PHONE 995-0042
6655H Hobbin Road - Columbia, Md. 21045 730-0500

PROPERTY LOCATION: NEW LOT 13, SEC. 2

SUBDIVISION Simpson Woods Section Two LOT NO. 4, Block C

ROAD AND DESCRIPTION East Side of Road A; North of Johns Hopkins Road

SIZE OF LOT 40,600 square feet TYPE BLDG. 3 or 4
NUMBER OF BEDROOMS _____

IF NOT SINGLE RESIDENCE DESCRIBE _____

THE SYSTEM INSTALLED UNDER THIS APPLICATION IS ACCEPTABLE ONLY UNTIL PUBLIC FACILITIES BECOME AVAILABLE.

SIGNATURE OF APPLICANT Phase II Ltd, Elan Berg, Pres.

APPROVED BY Frank Skinnis FOR Drywell & trench DATE 5/17/78
(KIND OF SYSTEM)

REJECTED BY _____ FOR _____ DATE _____
(KIND OF SYSTEM)

HOLD PENDING FURTHER TESTS WWZ DATE 5/2/77


REASONS FOR REJECTION OR HOLDING prelim. plat, certified test holes

also disc w DIOM re water prob.

1/9/78 NON-BUILDABLE AT PRESENT TIME

THIS IS NOT A PERMIT

* Hole C had water @ 10' after 25 hours and 4 hours of rain.

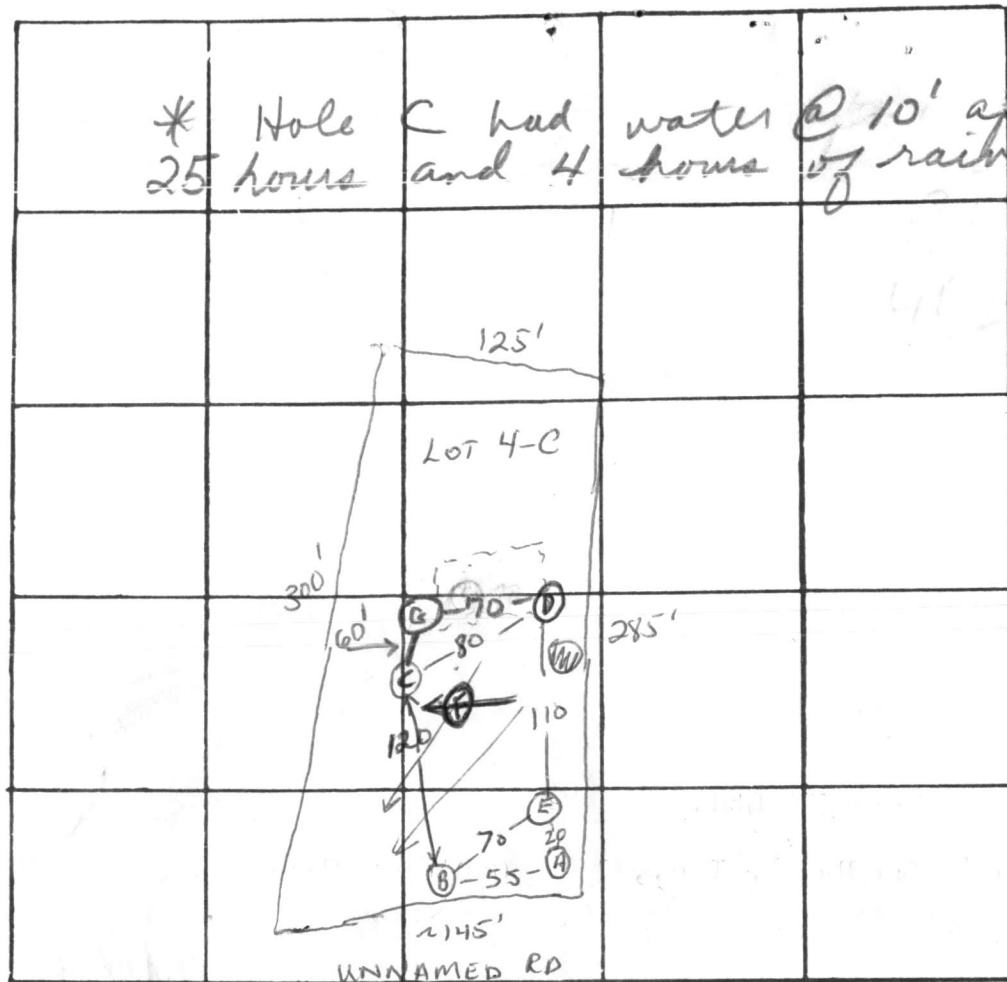

INDICATE NORTH. - NAME ADJOINING ROADWAY AS BASE LINE

DATE	TEST NO.	DEPTH	PRE-WET		TEST - 1" DROP		TIME	
			START	STOP	START	STOP		
4/28/77	A	7'	Rock					
LOW	B	5	3:07	3:09	3:09	3:13	4	21
	B-1	12	3:07	3:15	3:15	3:32	17	
LOW	E	3 1/2	3:24	3:26	3:26	3:32	6	34
	E-1	11 1/2	3:24	3:32	3:32	4:00	28	
HIGH	D	4	3:35	3:38	3:38	3:42	4	17
	D-1	12	3:35	3:42	3:42	3:55	13	
LOWEST	C	13	VISUAL ; water @ 12'					
	F	13 1/2	VISUAL ; excellent soil ; dry + sandy					
4/29/77	G	5 1/2	4:36	4:38	4:38	4:48	10	17
	G-1	14	4:34	4:38	4:38	4:45	7	
4/27/78	C-1	11'	Water at 9 1/2'					

REMARKS System in D (15' uphill fr D), run towards E
E - hard but sandy

TYPE OF SOIL Sandy - mica

TESTED BY WWZ ALSO PRESENT: Ketterman Co, Burg

C 1 0257
 SEQUENCE NO. (WRA USE ONLY)
 1 2 3 (SEQ. NO.) 6
 (THIS NUMBER IS TO BE PUNCHED IN COLS. 3-6 ON ALL CARDS)

STATE OF MARYLAND
 WATER RESOURCES ADMINISTRATION
 LAWES STATE OFFICE BLDG., ANNAPOLIS, MD. 21401
 WELL COMPLETION REPORT

THIS REPORT MUST BE SUBMITTED WI
 IN 30 DAYS AFTER WELL COMPLET

FILL IN THIS FORM COMPLETELY

COUNTY NUMBER W 29112

DATE RECEIVED (WRA USE ONLY)
 November 14, 1978
 DATE WELL COMPLETED
 1978

DEPTH OF WELL
 130
 22 (TO NEAREST FOOT) 26

PERMIT NO. FROM "PERMIT TO DRILL WELL"
 NO-53-3034
 28 29 30 31 32 33 34 35 36 37

DRILLERS IDENTIFICATION NO. 256

OWNER Nu-Homes, Inc.
 LAST NAME FIRST NAME
 STREET OR RFD 6655 H. Dobbin Road POST OFFICE Columbia, Md. 21044

WELL LOG
 STATE THE KIND OF FORMATIONS PENETRATED, THEIR COLOR, DEPTH, THICKNESS AND IF WATER BEARING
 DESCRIPTION (USE ADDITIONAL SHEETS IF NECESSARY) FEET CHECK IF WATER BEARING

DESCRIPTION	FEET		CHECK IF WATER BEARING
	FROM	TO	
Dirt	0	10	
Soft Brown Mica	10	29	
Soft Brown Mica	29	30	X
Soft Brown Mica	30	78	
Blue Mica	78	86	
Brown Mica & Flint	86	87	X
Blue Mica	87	93	
Brown Mica	93	95	X
Blue Mica	95	113	
Brown Mica	113	114	X
Blue Mica	114	130	

GROUTING RECORD
 WELL HAS BEEN GROUTED (CIRCLE APPROPRIATE BOX) YES Y NO N
 TYPE OF GROUTING MATERIAL (CIRCLE BOX)
 CEMENT CM BENTONITE CLAY BC
 NO. OF BAGS 37 NO. OF POUNDS 3,478
 GALLONS OF WATER 222

DEPTH OF GROUT SEAL (TO NEAREST FOOT)
 FROM 0 FT. TO 81 FT.
 (ENTER 0 IF FROM SURFACE)

CASING RECORD
 INSERT APPROPRIATE CODE BELOW
 STEEL ST CONCRETE CO
 PLASTIC PL OTHER OT

MAIN CASING TYPE NOMINAL DIAMETER TOP (MAIN) CASING (NEAREST INCH) TOTAL DEPTH OF MAIN CASING (NEAREST FOOT)
 S T 6 82

OTHER CASING (IF USED)
 DIAMETER (INCH) DEPTH (FEET) FROM TO

SCREEN RECORD
 INSERT APPROPRIATE CODE BELOW
 STEEL ST BRASS OR BRONZE BR OPEN HOLE HO
 PLASTIC PL OTHER OT

SCREEN TYPE OR OPEN HOLE
 C 2 (SEQ. NO.) 6
 DEPTH (NEAREST WHOLE FOOT) FROM TO
 1 HO 83 130
 2
 3

DIAMETER OF SCREEN 56 (NEAREST INCH) FROM 60 TO
 GRAVEL PACK
 IF WELL DRILLED WAS A FLOWING WELL CIRCLE BOX 68 F

WRA USE ONLY (NOT TO BE FILLED IN BY DRILLER)
 T (E.R.O.S.) W Q
 70 72 74 75 76
 TELESCOPE LOG OTHER DATA
 CASING INDICATOR AVAILABLE

PUMPING TEST
 C 3 (SEQ. NO.) 6
 HOURS PUMPED (TO NEAREST HOUR) 5
 PUMPING RATE (GALLONS PER MINUTE TO NEAREST GALLON) 30
 METHOD USED TO MEASURE PUMPING RATE Flowmeter

WATER LEVEL: (DISTANCE FROM LAND SURFACE)
 BEFORE PUMPING 27 (NEAREST FOOT)
 WHEN PUMPING 113 (NEAREST FOOT)
 TYPE OF PUMPED USED (CIRCLE APPROPRIATE BOX) (FOR PUMPING TEST)
 AIR A PISTON P TURBINE T
 CENTRIFUGAL C ROTARY R OTHER (DESCRIBE BELOW) O
 JET J SUBMERSIBLE S

PUMP INSTALLED
 TYPE OF PUMP (WRITE APPROPRIATE LETTER IN BOX - SEE ABOVE: A, C, J, P, R, S, T, O)
 DRILLER WILL INSTALL PUMP (CIRCLE APPROPRIATE BOX) YES Y NO N
 CAPACITY:
 GALLONS PER MINUTE (TO NEAREST GALLON) 31 35
 PUMP HORSE POWER 37 41
 PUMP COLUMN LENGTH (NEAREST FOOT) 43 47


CASING HEIGHT (CIRCLE APPROPRIATE BOX AND ENTER CASING HEIGHT)
 + ABOVE } LAND SURFACE (NEAREST FOOT)
 - BELOW } 2
 49 50 51

LOCATION OF WELL ON LOT
 SHOW PERMANENT STRUCTURE SUCH AS BUILDINGS, SEPTIC TANKS, AND/OR OTHER LAND MARKS AND INDICATE NOT LESS THAN TWO DISTANCES (MEASUREMENTS TO WELL).

CIRCLE APPROPRIATE BOXES
 A A WELL WAS ABANDONED AND SEALED WHEN THIS WELL WAS COMPLETED
 E ELECTRIC LOG OBTAINED
 P TEST WELL CONVERTED TO PRODUCTION WELL

I HEREBY CERTIFY THAT I HAVE COMPLIED WITH ALL CONDITIONS STATED ON THE ABOVE-CAPTIONED "PERMIT TO DRILL WELL", AND THAT INFORMATION CONTAINED IN THIS REPORT IS TRUE, ACCURATE, AND COMPLETE TO THE BEST OF MY KNOWLEDGE, INFORMATION AND BELIEF.

DRILLERS NAME Dana Kyker, Jr. II
 SIGNATURE

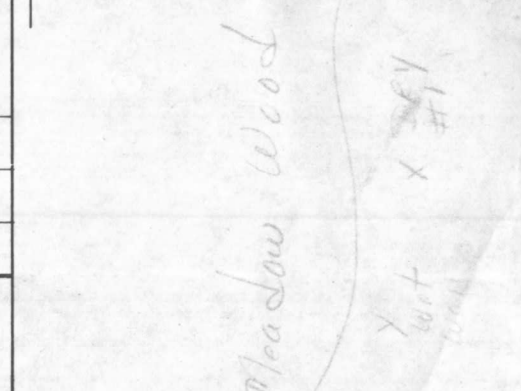

DNR-214 (7-77)

C 1 0257

SEQUENCE NO. (WRA USE ONLY)

STATE OF MARYLAND WATER RESOURCES ADMINISTRATION
TAYES STATE OFFICE BLDG., ANNAPOLIS, MD. 21401
WELL COMPLETION REPORT

THIS REPORT MUST BE SUBMITTED WITHIN 30 DAYS AFTER WELL COMPLETION

FILL IN THIS FORM COMPLETELY

COUNTY NUMBER W 29112

(THIS NUMBER IS TO BE PUNCHED IN COLS. 3-6 ON ALL CARDS)

DATE RECEIVED (WRA USE ONLY)
November 14, 1978
DATE WELL COMPLETED
19 78

DEPTH OF WELL
130
22 (TO NEAREST FOOT) 26

PERMIT NO. FROM "PERMIT TO DRILL WELL"
NO-73-3034
28 29 30 31 32 33 34 35 36 37

DRILLERS IDENTIFICATION NO. 256

OWNER: Nu-Homes, Inc. LAST NAME FIRST NAME
STREET OR RFD: 6655 W. Dobbin Road POST OFFICE: Columbia, Md. 21044

WELL LOG	FEET		CHECK IF WATER BEARING
	FROM	TO	
Dirt	0	10	
Soft Brown Mica	10	29	
Soft Brown Mica	29	30	X
Soft Brown Mica	30	78	
Blue Mica	78	86	
Brown Mica & Flint	86	87	X
Blue Mica	87	93	
Brown Mica	93	95	X
Blue Mica	95	113	
Brown Mica	113	114	X
Blue Mica	114	130	

GROUTING RECORD

WELL HAS BEEN GROUTED (CIRCLE APPROPRIATE BOX) YES Y NO N

TYPE OF GROUTING MATERIAL (CIRCLE APPROPRIATE BOX):
 CEMENT CM 45 46 BENTONITE CLAY BC 45 46

NO. OF BAGS 37 NO. OF POUNDS 3,478

GALLONS OF WATER 222

DEPTH OF GROUT SEAL (TO NEAREST FOOT)
 FROM 0 FT. TO 81 FT. (ENTER 0 IF FROM SURFACE)

CASING RECORD

INSERT APPROPRIATE CODE BELOW

STEEL ST CONCRETE CO
 PLASTIC PL OTHER OT

MAIN CASING TYPE: S T 6 83

NOMINAL DIAMETER TOP (MAIN) CASING (NEAREST INCH)

TOTAL DEPTH OF MAIN CASING (NEAREST FOOT)

OTHER CASING (IF USED)

DIAMETER (INCH)	DEPTH (FEET) FROM	TO

SCREEN RECORD

INSERT APPROPRIATE CODE BELOW

STEEL ST BRASS OR BRONZE BR OPEN HOLE HO
 PLASTIC PL OTHER OT

SCREEN TYPE OR OPEN HOLE

DEPTH (NEAREST WHOLE FOOT) FROM TO

1	EO	83	130
2			
3			

SLOT SIZE 1, 2, 3

DIAMETER OF SCREEN 56 (NEAREST INCH) FROM 60 TO

GRAVEL PACK

IF WELL DRILLED WAS A FLOWING WELL CIRCLE BOX 68 F

WRA USE ONLY (NOT TO BE FILLED IN BY DRILLER)

T (E.R.O.S.) 70 LOG INDICATOR 72

W Q 74 75 76 OTHER DATA AVAILABLE

PUMPING TEST

HOURS PUMPED (TO NEAREST HOUR) 5

PUMPING RATE (GALLONS PER MINUTE TO NEAREST GALLON) 30

METHOD USED TO MEASURE PUMPING RATE: Flowmeter

WATER LEVEL: (DISTANCE FROM LAND SURFACE)

BEFORE PUMPING 27 (NEAREST FOOT)
 17 20

WHEN PUMPING 113 (NEAREST FOOT)
 22 25

TYPE OF PUMPED USED (CIRCLE APPROPRIATE BOX) (FOR PUMPING TEST)

AIR A PISTON P TURBINE T
 27 27 27

CENTRIFUGAL C ROTARY R OTHER (DESCRIBE BELOW) O
 27 27 27

JET J SUBMERSIBLE S
 27 27

PUMP INSTALLED

TYPE OF PUMP (WRITE APPROPRIATE LETTER IN BOX - SEE ABOVE: A, C, J, P, R, S, T, O) 29

DRILLER WILL INSTALL PUMP (CIRCLE APPROPRIATE BOX) YES Y NO N

CAPACITY: GALLONS PER MINUTE (TO NEAREST GALLON) 31 35

PUMP HORSE POWER 37 41

PUMP COLUMN LENGTH (NEAREST FOOT) 43 47

CASING HEIGHT (CIRCLE APPROPRIATE BOX AND ENTER CASING HEIGHT)

ABOVE + BELOW -

LAND SURFACE 2 (NEAREST FOOT)
 49 51

LOCATION OF WELL ON LOT

SHOW PERMANENT STRUCTURE SUCH AS BUILDINGS, SEPTIC TANKS, AND/OR OTHER LAND MARKS AND INDICATE NOT LESS THAN TWO DISTANCES (MEASUREMENTS TO WELL).

CIRCLE APPROPRIATE BOXES

A A WELL WAS ABANDONED AND SEALED WHEN THIS WELL WAS COMPLETED

E ELECTRIC LOG OBTAINED

P TEST WELL CONVERTED TO PRODUCTION WELL

I HEREBY CERTIFY THAT I HAVE COMPLIED WITH ALL CONDITIONS STATED ON THE ABOVE-CAPTIONED "PERMIT TO DRILL WELL", AND THAT INFORMATION CONTAINED IN THIS REPORT IS TRUE, ACCURATE, AND COMPLETE TO THE BEST OF MY KNOWLEDGE, INFORMATION AND BELIEF.

DRILLERS NAME: Dana Kyker, Jr., II
SIGNATURE: Dana Kyker, Jr.

Meadow Wood
1-Dry Hole

C 1 **9516** SEQUENCE NO. (WRA USE ONLY)
 1 2 3 (SEQ. NO.) 6
 (THIS NUMBER IS TO BE PUNCHED IN COLS. 3-5 ON ALL CARDS)

STATE OF MARYLAND
WATER RESOURCES ADMINISTRATION
 TAWES STATE OFFICE BLDG., ANNAPOLIS, MD. 21401
WELL COMPLETION REPORT

THIS REPORT MUST BE SUBMITTED WITHIN 30 DAYS AFTER WELL COMPLETION
 FILL IN THIS FORM COMPLETELY
 COUNTY NUMBER **W29112**

DATE RECEIVED (WRA USE ONLY) **November 10, 1978** DEPTH OF WELL **90** PERMIT NO. FROM "PERMIT TO DRILL WELL" **10-13-501**
 DATE WELL COMPLETED **11-07-78** (TO NEAREST FOOT) **22** **26** DRILLERS IDENTIFICATION NO. **256**
DRY HOLE # 1

OWNER **Nu-Homes, Inc.** LAST NAME **6655 H. Dobbin Road** FIRST NAME **Columbia, Md. 21044**
 STREET OR RFD POST OFFICE

WELL LOG

STATE THE KIND OF FORMATIONS PENETRATED, THEIR COLOR, DEPTH, THICKNESS AND IF WATER BEARING

DESCRIPTION (USE ADDITIONAL SHEETS IF NECESSARY)	FEET		CHECK IF WATER BEARING
	FROM	TO	
DRY HOLE #1			
Dirt	0	12	
Mud	12	13	X
Mud	13	90	

GROUTING RECORD YES NO
 WELL HAS BEEN GROUTED (CIRCLE APPROPRIATE BOX) **Y** **N**
 TYPE OF GROUTING MATERIAL (CIRCLE BOX):
 CEMENT **C** **M** BENTONITE CLAY **B** **C**
 45 46 45 46
 NO. OF BAGS _____ NO. OF POUNDS _____
 GALLONS OF WATER _____
 DEPTH OF GROUT SEAL (TO NEAREST FOOT)
 FROM **48** FT. TO **54** FT. (ENTER 0 IF FROM SURFACE)

CASING RECORD
 INSERT APPROPRIATE CODE BELOW
 STEEL **S** **T** CONCRETE **C** **O**
 PLASTIC **P** **L** OTHER **O** **T**
 MAIN CASING TYPE _____ NOMINAL DIAMETER TOP (MAIN) CASING (NEAREST INCH) _____ TOTAL DEPTH OF MAIN CASING (NEAREST FOOT) **32**
 60 61 63 64 66 70

OTHER CASING (IF USED)
 DIAMETER (INCH) _____ DEPTH (FEET) FROM _____ TO _____
 E A C H C A S I N G

SCREEN RECORD
 INSERT APPROPRIATE CODE BELOW
 STEEL **S** **T** BRASS OR BRONZE **B** **R** OPEN HOLE **H** **O**
 PLASTIC **P** **L** OTHER **O** **T**

C 2 (SEQ. NO.) 6
DEPTH (NEAREST WHOLE FOOT)

E A C H S C R E E N	FROM		TO	
	1	2	3	6
1	8	9	11	17
2	23	24	26	36
3	38	39	41	51

SLOT SIZE 1, _____ 2, _____ 3, _____

C 3 (SEQ. NO.) 6
PUMPING TEST
 HOURS PUMPED (TO NEAREST HOUR) **5**
 PUMPING RATE (GALLONS PER MINUTE TO NEAREST GALLON) **30**
 METHOD USED TO MEASURE PUMPING RATE _____
WATER LEVEL: (DISTANCE FROM LAND SURFACE)
 BEFORE PUMPING **17** (NEAREST FOOT) **20**
 WHEN PUMPING **22** (NEAREST FOOT) **25**
TYPE OF PUMPED USED (CIRCLE APPROPRIATE BOX) (FOR PUMPING TEST)
 AIR **A** 27 PISTON **P** 27 TURBINE **T** 27
 CENTRIFUGAL **C** 27 ROTARY **R** 27 OTHER (DESCRIBE BELOW) **O** 27
 JET **J** 27 SUBMERSIBLE **S** 27

PUMP INSTALLED
 TYPE OF PUMP (WRITE APPROPRIATE LETTER IN BOX - SEE ABOVE: A, C, J, P, R, S, T, O) **29**
 DRILLER WILL INSTALL PUMP (CIRCLE APPROPRIATE BOX) YES NO
 CAPACITY: GALLONS PER MINUTE (TO NEAREST GALLON) **31** **35**
 PUMP HORSE POWER **37** **41**
 PUMP COLUMN LENGTH (NEAREST FOOT) **43** **47**
CASING HEIGHT (CIRCLE APPROPRIATE BOX AND ENTER CASING HEIGHT)
 + ABOVE } LAND SURFACE (NEAREST FOOT)
 - BELOW } **49** **51**

LOCATION OF WELL ON LOT
 SHOW PERMANENT STRUCTURE SUCH AS BUILDINGS, SEPTIC TANKS, AND/OR OTHER LAND MARKS AND INDICATE NOT LESS THAN TWO DISTANCES (MEASUREMENTS TO WELL).
 RECEIVED NOV 12 8 22 AM '78

CIRCLE APPROPRIATE BOXES
 A WELL WAS ABANDONED AND SEALED WHEN THIS WELL WAS COMPLETED
 E ELECTRIC LOG OBTAINED
 P TEST WELL CONVERTED TO PRODUCTION WELL

I HEREBY CERTIFY THAT I HAVE COMPLIED WITH ALL CONDITIONS STATED ON THE ABOVE-CAPTIONED "PERMIT TO DRILL WELL", AND THAT INFORMATION CONTAINED IN THIS REPORT IS TRUE, ACCURATE, AND COMPLETE TO THE BEST OF MY KNOWLEDGE, INFORMATION AND BELIEF.

DRILLERS NAME **Dana Kyker, Jr. II**
 (PLEASE PRINT)
 SIGNATURE _____

DIAMETER OF SCREEN **56** (NEAREST INCH) **60**
 FROM _____ TO _____
 GRAVEL PACK _____
 IF WELL DRILLED WAS A FLOWING WELL CIRCLE BOX **68** **F**
WRA USE ONLY (NOT TO BE FILLED IN BY DRILLER) (E.R.O.S.)
 T 70 LOG INDICATOR 72
 W 74 75 76 OTHER DATA AVAILABLE

STATE DEPARTMENT OF HEALTH
WELL COMPLETION REPORT

NOV 15 1978

PLUMBING

ROUTING RECORD

DATE

CLAIM RECORD

SCREEN RECORD

RECEIVED

NOV 15 8 55 AM '78

HOWARD COUNTY
HEALTH DEPT.
ELlicott CITY, MD.

CHECK APPROPRIATE BOXES

