

PERMIT

P-28850

A-16852

SEWAGE DISPOSAL SYSTEM

MARYLAND STATE DEPARTMENT OF HEALTH

HOWARD COUNTY

ELLICOTT CITY

DISTRICT 3rd

DATE 5/11/77

*5/13/77 please
p.m.*

INDEXED
03-287734

Jim Brittingham

IS PERMITTED TO INSTALL ALTER

ADDRESS 3004 N. Rogers Ave., Ellicott City, Md. 21043 PHONE 461-1870

SEWAGE DISPOSAL SYSTEM LOCATED AT _____

DIVISION Evergreen Valley Estates ^{*3145*} ROAD Emerald Valley Road LOT 5, Blk. D, Sec. 7

PROPERTY OWNER H. F. Cole & Company *EHREN FARED*

ADDRESS Teachers Building, Columbia, Md. 21044 Phone: 730-0910

SPECIFICATIONS 4 bedrooms

DRAIN FIELD _____ DEPTH _____ FEET, BOTTOM AREA _____ SQ. FT.

SEEPAGE PITS _____ ABSORBENT SIDE-WALL AREA _____ SQ. FT.

SEPTIC TANK CAPACITY 1250 GALLONS

FOR GARBAGE GRINDER, INCREASE DISPOSAL AREA 25% & TANK CAPACITY 50%.

OTHER DRY WELL - 450 sq. ft. absorbent sidewall area below the first 3 ft. of original grade. Maximum depth permitted for dry well is 10 ft. below original grade. Locate the dry well 125 ft. from front lot line and 25 ft. from left side line as seen from Emerald Valley Road. *OK for hook off DW. NWB 5/11/77*

NOTE: IN NO CASE IS ANY DRY WELL TO EXCEED 15 FOOT IN DIAMETER.

NOTE: ALL PIPE FROM HOUSE TO DISPOSAL AREA MUST BE CAST IRON.

PERMIT VOID AFTER THREE YEARS.

NOTE: INSTALL STAND PIPE ON SEPTIC TANK AND DRY WELL. STAND PIPES MUST BE 6 INCHES IN DIAMETER. CAST IRON, CONCRETE OR TERRA COTTA ACCEPTED.


APPROVED BY Robert V. Torre DATE 4/2/73

ALL SEPTIC TANK AND DISTRIBUTION BOX WITH WATER BEFORE CALLING FOR AN INSPECTION. COVER NO WORK UNTIL INSPECTED AND APPROVED.

EITHER THE HOWARD COUNTY COMMISSIONERS NOR THE HEALTH DEPARTMENT IS RESPONSIBLE FOR THE SUCCESSFUL OPERATION OF ANY SYSTEM.

BLDG. PERMITS SIGN'D
AND RETURNED 7-15-97
Serial B70106808
addition

A 25852
A 16852

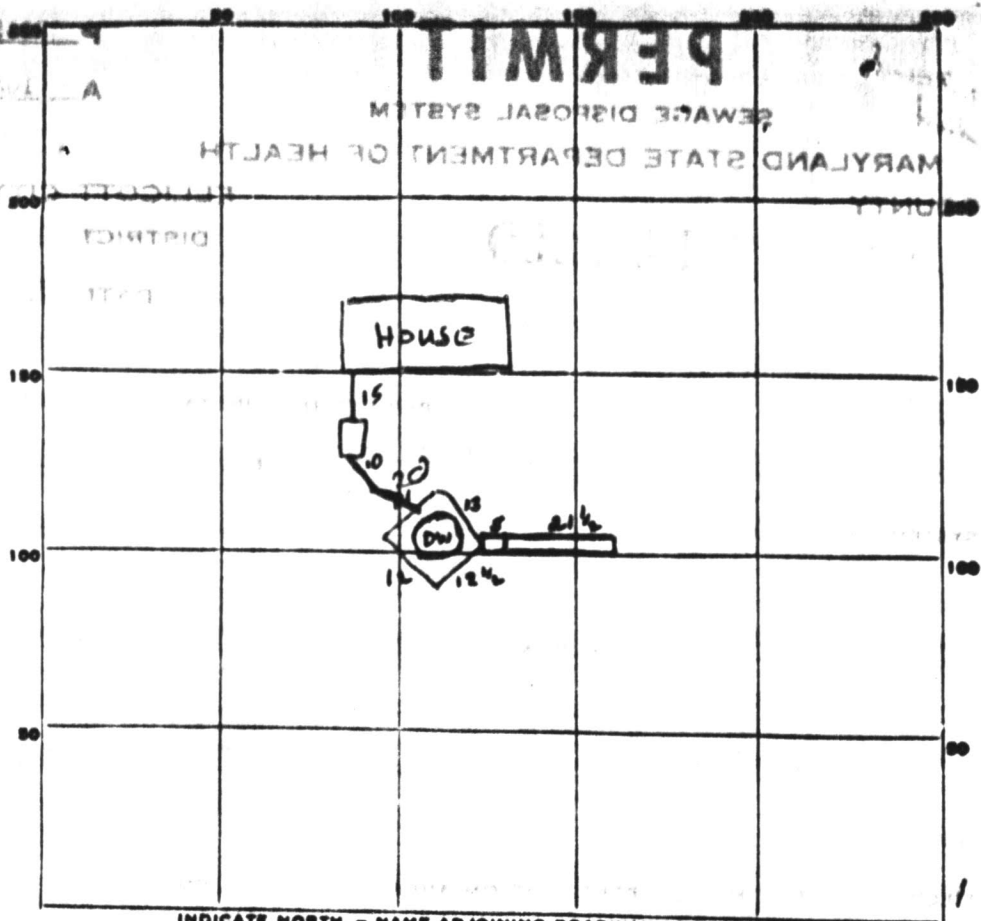

17
 51.5
 2
 360.5
 3
 21.5
 6.5
 107
 1290
 139.75

INDICATE NORTH. - NAME ADJOINING ROADWAY AS BASE LINE.
 ————— EMBLEO VALLEY RD —————


PERMIT CARD none seen
 SEPTIC TANK, LEVEL
 DISTRIBUTION BOX, LEVEL NA
 CLEANOUTS DW ST
 TRENCH # _____
 TRENCH DEPTH 9 1/2 FT. TRENCH WIDTH 2 FT.
 GRAVEL DEPTH 6.5 FT. TOTAL LENGTH 21 1/2 FT.
 NUMBER OF TRENCHES 1 SIDEWALL TOTAL BOTTOM AREA 139.75
 SEEPAGE PITS, INSIDE DIAMETER 5 1/2 FT. DEPTH BELOW INLET 7 FT.
 ABSORBENT AREA 360.5 SQ. FT.

51	21 1/2
7	2 1/2
360.5	126
107	11
494	137

REMARKS 5/12/77 DW is 10' deep, perimeter of 5 1/2, block in place but no stone, DW top. NW2

DATE SYSTEM APPROVED 13 May 77 INSPECTOR R Biggs

- NOTES:
- 1) B.R.L. information, if shown, was obtained from existing record plat or local agencies and is not guaranteed by NTT, Inc.
 - 2) Building line and/or Flood Zone information is subject to the interpretation of the originator.
 - 3) NTT, Inc. does not certify to unknown or unrecorded encroachments or overlaps.
 - 4) Property markers not found, or guaranteed by this location.
 - 5) Setback distance accuracy: 1/2".

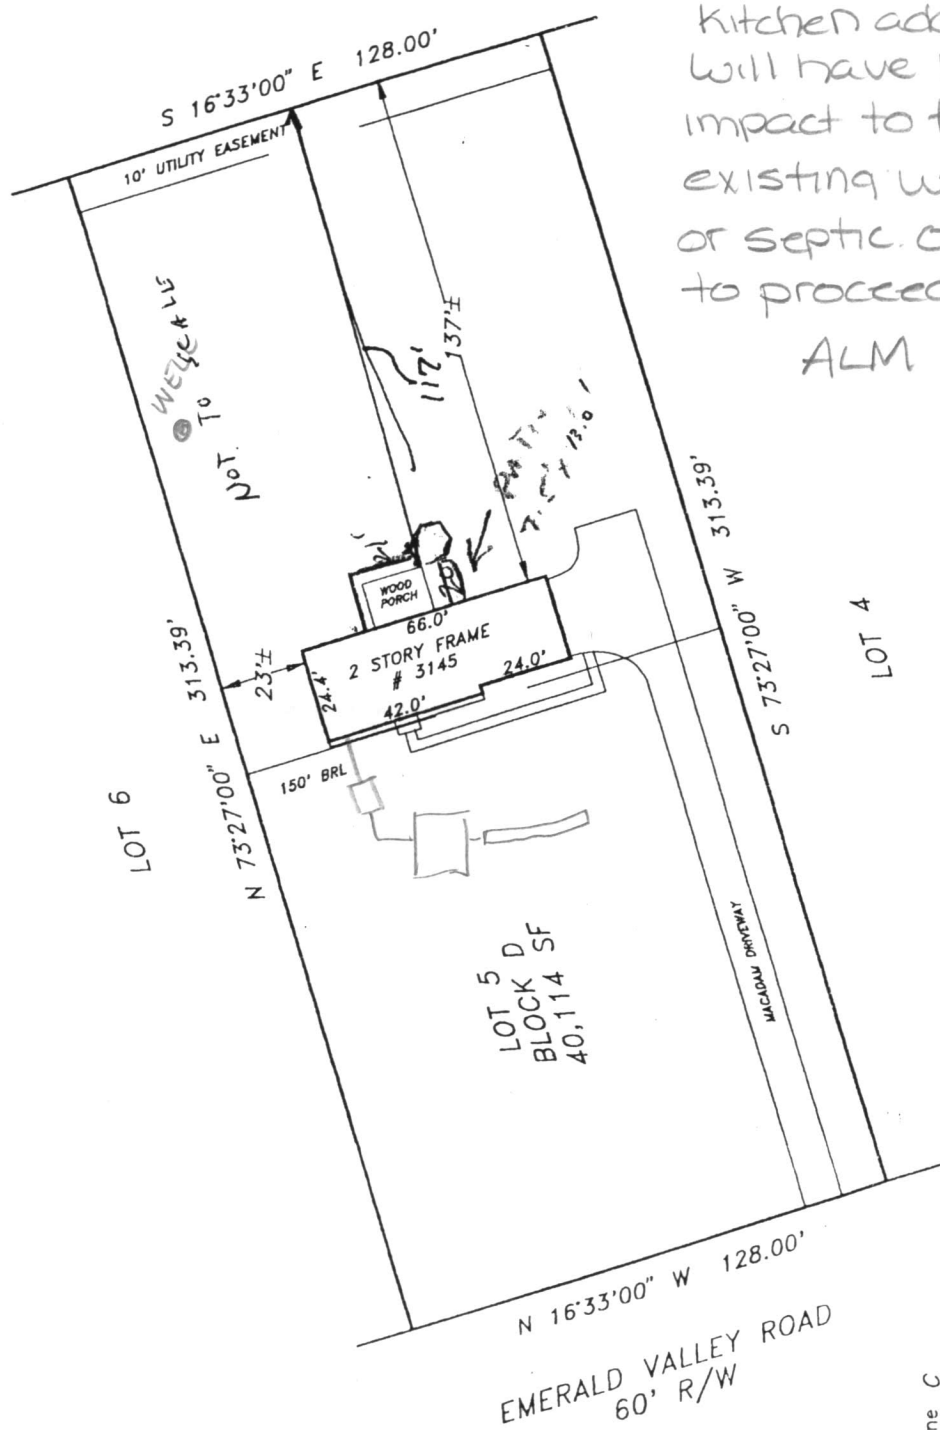

7/15/97


Shown kitchen addition will have no impact to the existing well or septic. OK to proceed

ALM

LOCATION DRAWING
3145 EMERALD VALLEY ROAD
EVERGREEN VALLEY ESTATES
3RD ELECTION DISTRICT
HOWARD COUNTY, MARYLAND

Scale:	1" = 50'
Date:	DECEMBER 3, 1996
Field by:	JLM
Drawn by:	JLM
Drawing #	AEC5027

NTT Associates, Inc.
16205 Old Frederick Road
Mt. Airy, Maryland 21771
Ph. (410)442-2031
Fax No. (410)442-1315

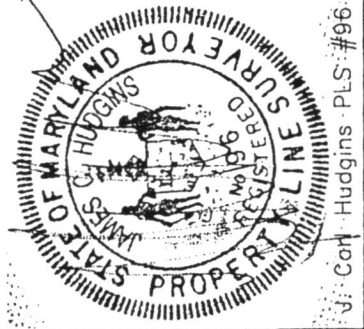

Subject property is shown in Zone C on the National Flood Insurance Program Flood Insurance Rate Map of Howard County, Maryland. Panel # 16 of 45 Community Panel # 240044-0016B Effective date: December 4, 1986

This is to certify that I have surveyed the property shown hereon, being known as LOT 5 BLOCK D 3145 EMERALD VALLEY ROAD recorded in the Land Records of Howard County, Maryland in Plat Bk. 24/61 Liber Folio for the purpose of locating the improvements thereon.

* This plat is of benefit to the consumer only insofar as it is required by a lender or a title insurance company or its agent in connection with contemplated transfer, financing, or refinancing purposes.
* This plat is not to be relied upon for the establishment of location of fences, garages, buildings, or other existing or future structures.
* This plat does not provide for the accurate identification of property boundary lines, but such identification may not be required for the transfer of title or for securing financing or refinancing.