

C1 4548

SEQUENCE NO. (OEP USE ONLY)

STATE OF MARYLAND WELL COMPLETION REPORT

THIS REPORT MUST BE SUBMITTED WITHIN 45 DAYS AFTER WELL IS COMPLETED.

(THIS NUMBER IS TO BE PUNCHED IN COLS. 3-6 ON ALL CARDS)

COUNTY NUMBER A 23905

DATE RECEIVED

DATE WELL COMPLETED 08/18/84

DEPTH OF WELL 200 (TO NEAREST FOOT)

PERMIT NO. FROM "PERMIT TO DRILL WELL" 40-81-0672

OWNER REARDON STEPHEN last name first name STREET OR RFD FLORENCE RD TOWN FLORENCE MD. SUBDIVISION DALE JACKSON PROPERTY SECTION LOT 1

WELL LOG table with columns: DESCRIPTION, FEET (FROM, TO), Check if water bearing. Includes entries for Top Soil, Sandy Sandstone, Micka, and Sandstone Micka.

GROUTING RECORD: WELL HAS BEEN GROUTED (Y), TYPE OF GROUTING MATERIAL CEMENT CM, BENTONITE CLAY BC, NO. OF BAGS 5, NO. OF POUNDS 500.

CASING RECORD: MAIN CASING TYPE PL, Nominal diameter 6, Total depth of main casing 23.

OTHER CASING (if used) section with diameter and depth fields.


SCREEN RECORD: SCREEN TYPE HO (OPEN HOLE), DEPTH (nearest ft.) 70, 19, 200.

GRAVEL PACK section with diameter of screen and slot size fields.

OEP USE ONLY (NOT TO BE FILLED IN BY DRILLER) section with T, WQ, and other data fields.

PUMPING TEST: HOURS PUMPED 3, PUMPING RATE 6, METHOD USED TO MEASURE PUMPING RATE Bucket, TYPE OF PUMP USED S (submersible).

PUMP INSTALLED: DRILLER WILL INSTALL PUMP YES NO, TYPE OF PUMP INSTALLED PLACE (A,C,J,P,R,S,T,O) IN BOX.

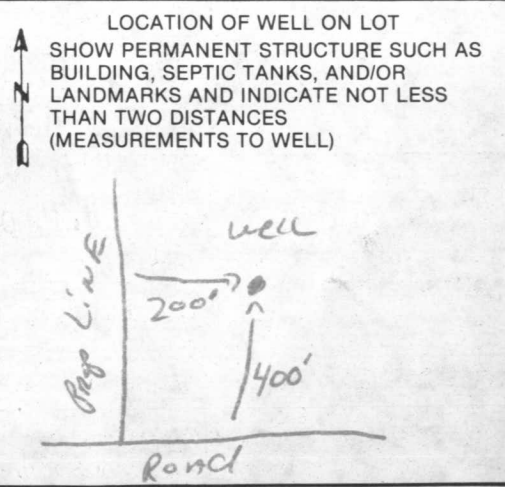

DRILLERS IDENT. NO. 253, DRILLERS SIGNATURE Ralph E. Mayne, SITE SUPERVISOR responsible for sitework if different from permittee.