

PERMIT

SEWAGE DISPOSAL SYSTEM

MARYLAND STATE DEPARTMENT OF HEALTH

HOWARD COUNTY

ELLICOTT CITY

DISTRICT 5th

DATE 3/30/77

INDEXED

APPROVED
7/30/77
B1665

P 25521
A _____

Jack Fyock

IS PERMITTED TO INSTALL ALTER X

ADDRESS 13775 Triadelphia Rd., Glenelg, Md.

PHONE 988-9270

A SEWAGE DISPOSAL SYSTEM LOCATED AT _____

SUBDIVISION _____

7344 Hopkins Way
ROAD off Johns Hopkins Road LOT _____
2nd driveway past Flamewood off Route 29

PROPERTY OWNER Pratt

ADDRESS Johns Hopkins Road

SPECIFICATIONS

DRAIN FIELD _____ DEPTH _____ FEET, BOTTOM AREA _____ SQ. FT.

SEEPAGE PITS _____ ABSORBENT SIDE-WALL AREA _____ SQ. FT.

SEPTIC TANK CAPACITY _____ GALLONS

FOR GARBAGE GRINDER, INCREASE DISPOSAL AREA 22% & TANK CAPACITY 50%.

OTHER REPAIR-Call For inspection when ground is opened up so Sanitarian
can recommend repair system.

PLANS APPROVED BY Palmer F. Wine

DATE 3/30/77


FILL SEPTIC TANK AND DISTRIBUTION BOX WITH WATER BEFORE CALLING FOR AN INSPECTION. COVER NO WORK UNTIL INSPECTED AND APPROVED.

NEITHER THE HOWARD COUNTY COMMISSIONERS NOR THE HEALTH DEPARTMENT IS RESPONSIBLE FOR THE SUCCESSFUL OPERATION OF ANY SYSTEM.

BLDG. PERMIT SIGNED
AND RETURNED 6/8/2000
B00124744
Renovate kitchen and
bathroom

BLDG. PERMIT SIGNED
AND RETURNED 6/3/84
Serial # 70720
addition

P 25521

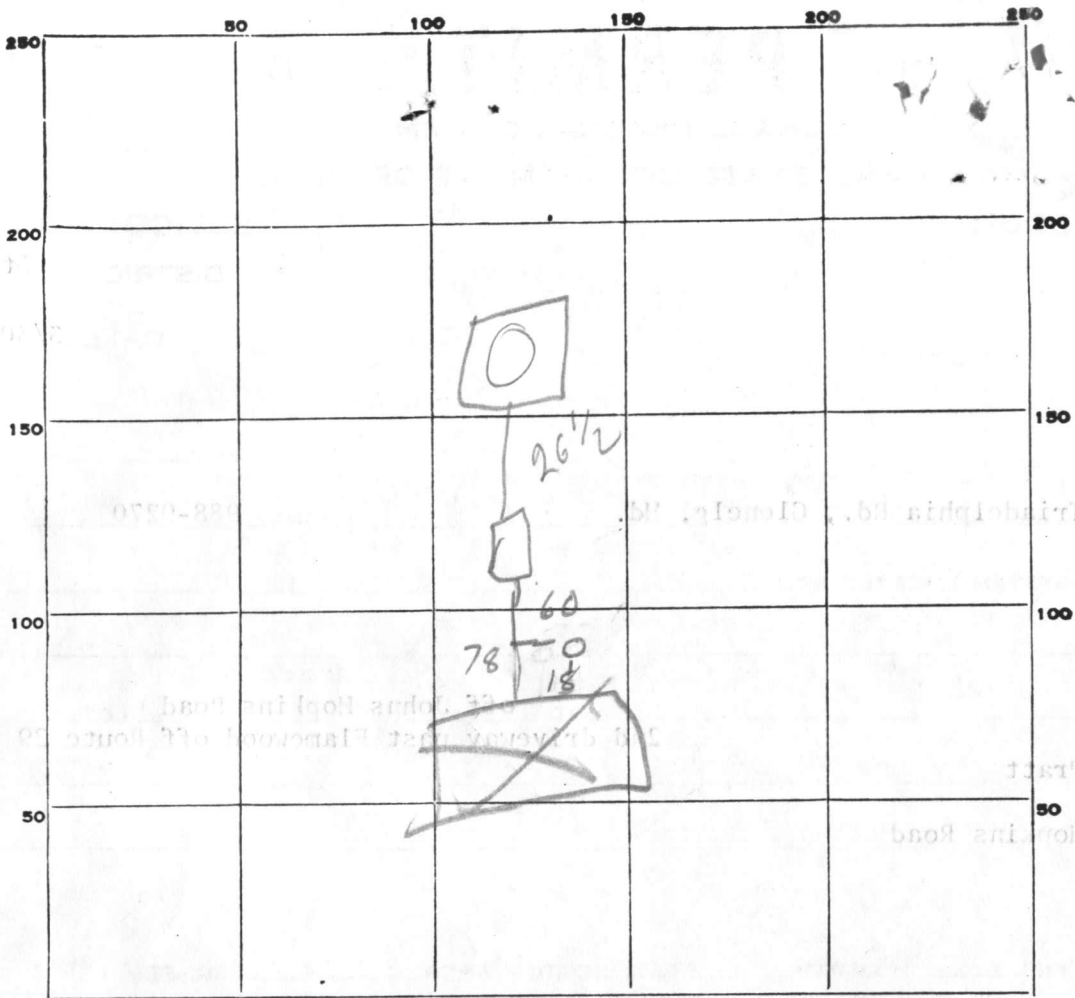

INDICATE NORTH. - NAME ADJOINING ROADWAY AS BASE LINE.

PERMIT CARD _____

SEPTIC TANK, LEVEL 1000 gal ✓

CLEANOUTS CO DW/ST

DISTRIBUTION BOX, LEVEL _____

TILE FIELD, DEPTH _____ FT. TRENCH WIDTH _____ FT.

GRAVEL DEPTH _____ IN. TOTAL LENGTH _____ FT.

NUMBER OF TRENCHES _____ TOTAL BOTTOM AREA _____

SEEPAGE PITS, outside perimeter 52 FT. INSIDE DIAMETER _____ FT. DEPTH BELOW INLET 7.5 FT.





ABSORBENT AREA 390 SQ. FT.

REMARKS _____

DATE SYSTEM APPROVED E/30/77


INSPECTOR R. Riggs

owner for = 13 years
 Septic system = 10 years old
 addition w/ 2 BD rooms
 will bring to total
 3 BD rooms.

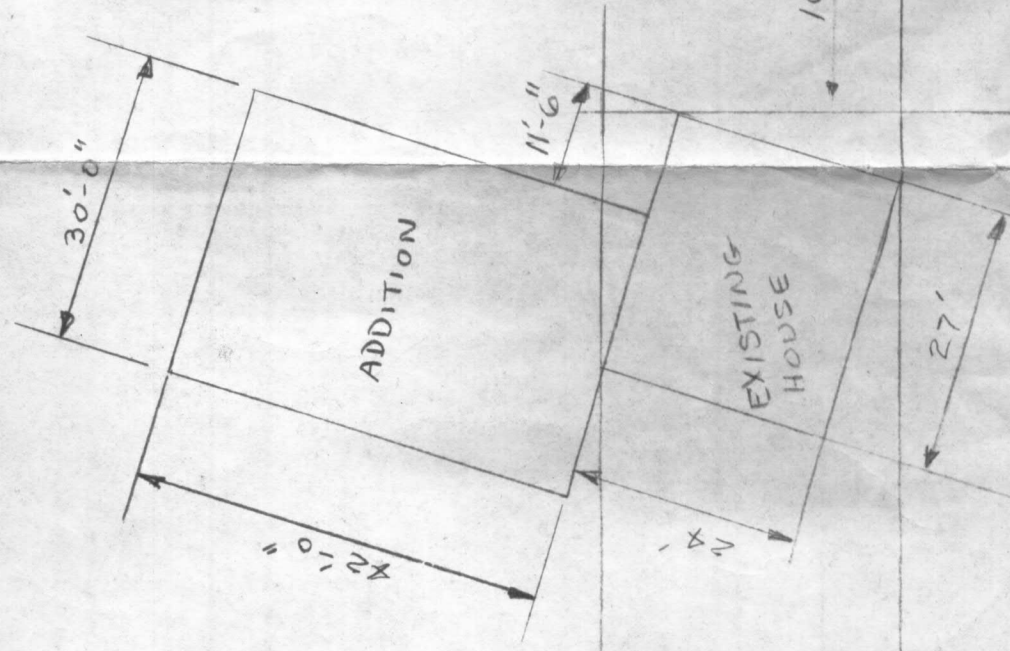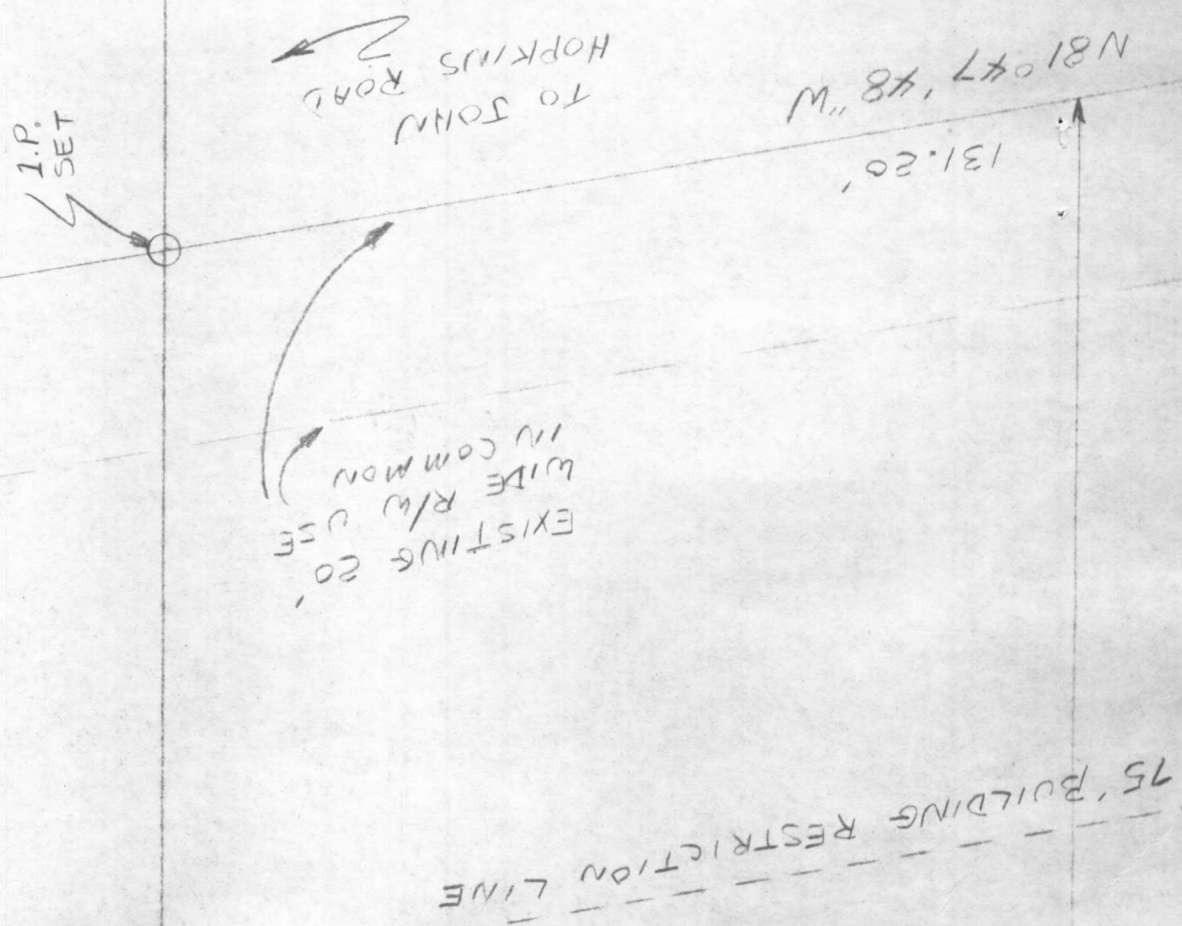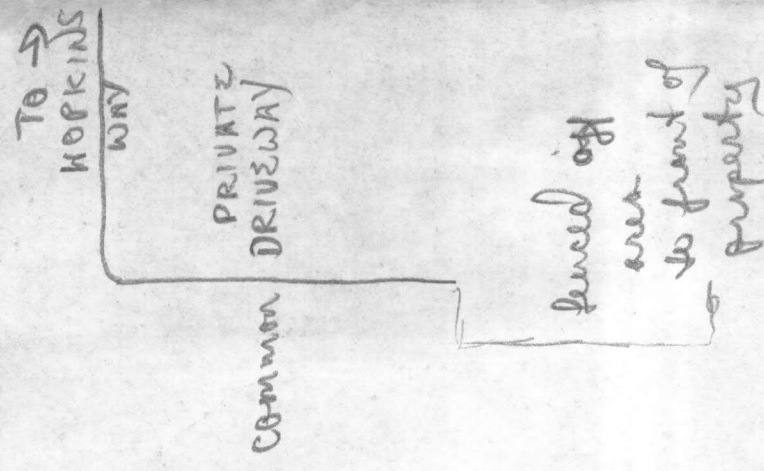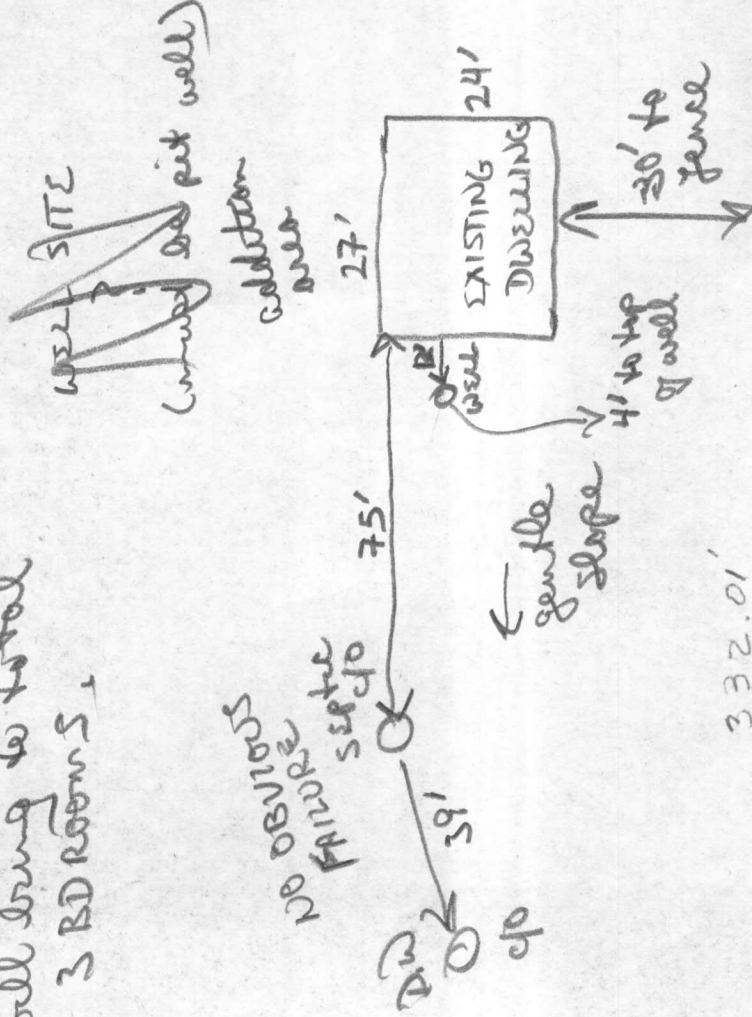

RICHARD & SHARON PRATT
 7344 HOPKINS WAY
 CLARKSVILLE, MD. 21029
 725-0979

SCALE "A"
 0 AC ±

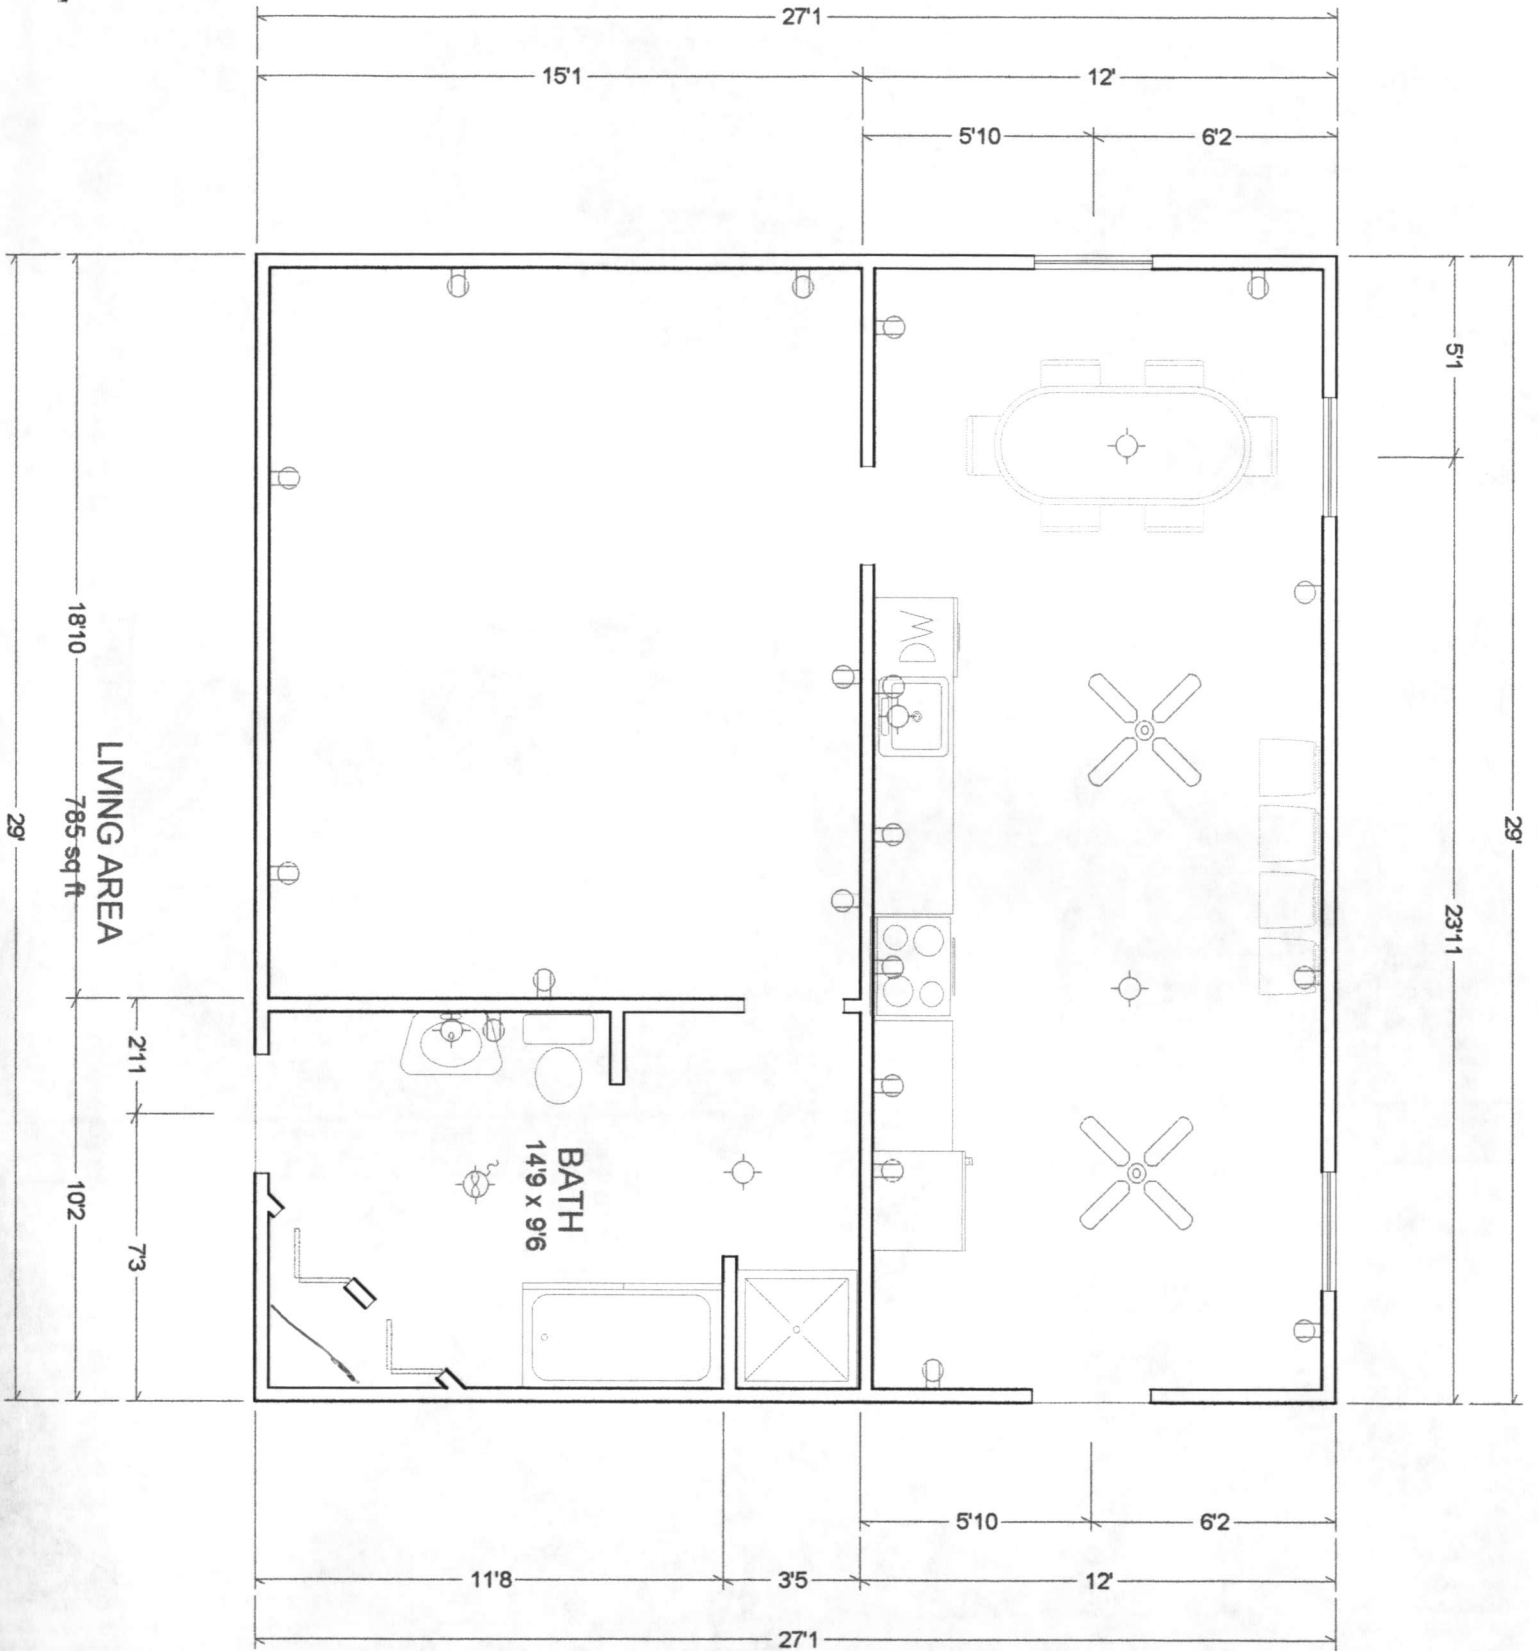

B00124744 - Renovate exterior only
 7344 Hopkins way - No change in bedroom #
 Received approval R/P 6/8/00