

4/15/77  
G.M. please

# PERMIT

P 25628

SEWAGE DISPOSAL SYSTEM

A \_\_\_\_\_

MARYLAND STATE DEPARTMENT OF HEALTH

HOWARD COUNTY

ELLICOTT CITY

INDEXED

DISTRICT 5th

DATE 4/14/77

Mr. Hays

IS PERMITTED TO INSTALL \_\_\_\_\_ ALTER

ADDRESS 6906 Deer Valley Road, Highland, Md. PHONE \_\_\_\_\_

A SEWAGE DISPOSAL-SYSTEM LOCATED AT \_\_\_\_\_

SUBDIVISION \_\_\_\_\_ ROAD 6906 Deer Valley Road LOT \_\_\_\_\_

PROPERTY OWNER Mr. Hays

ADDRESS same as above

SPECIFICATIONS

DRAIN FIELD \_\_\_\_\_ DEPTH \_\_\_\_\_ FEET, BOTTOM AREA \_\_\_\_\_ SQ. FT.

SEEPAGE PITS \_\_\_\_\_ ABSORBENT SIDE-WALL AREA \_\_\_\_\_ SQ. FT.

SEPTIC TANK CAPACITY \_\_\_\_\_ GALLONS

FOR GARBAGE GRINDER, INCREASE DISPOSAL AREA 22% & TANK CAPACITY 50%.

OTHER REPAIR - Call for inspection when ground is opened up and Sanitarian will

recommend repair system. Okay to put gravel in trench. Owner to give us state-


ment as to how much stone and depth of trench./ per D.W.M.

PLANS APPROVED BY Palmer F. Wine DATE 4/13/77

FILL SEPTIC TANK AND DISTRIBUTION BOX WITH WATER BEFORE CALLING FOR AN INSPECTION. COVER NO WORK UNTIL INSPECTED AND APPROVED.

NEITHER THE HOWARD COUNTY COMMISSIONERS NOR THE HEALTH DEPARTMENT IS RESPONSIBLE FOR THE SUCCESSFUL OPERATION OF ANY SYSTEM.

P 25628

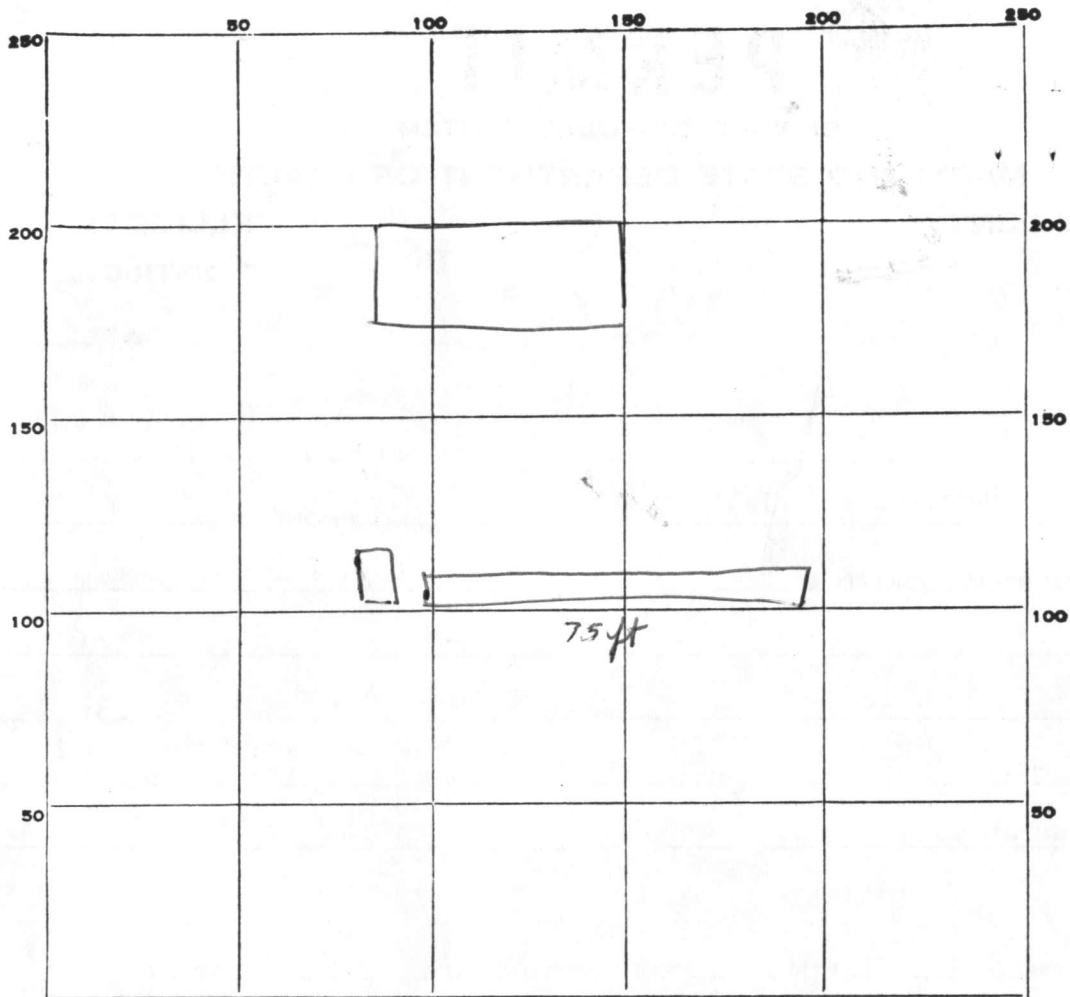

INDICATE NORTH. - NAME ADJOINING ROADWAY AS BASE LINE.  
 ← Deer Valley →

PERMIT CARD \_\_\_\_\_

SEPTIC TANK, LEVEL N/A

CLEANOUTS ST/OR

DISTRIBUTION BOX, LEVEL N/A

TILE FIELD, DEPTH ~~11-12~~ 11-12 FT. TRENCH WIDTH 2 FT.

GRAVEL DEPTH 2.5-3.5 IN. TOTAL LENGTH 75 FT.

NUMBER OF TRENCHES 1 TOTAL side wall BOTTOM AREA \_\_\_\_\_

SEEPAGE PITS, INSIDE DIAMETER NA FT. DEPTH BELOW INLET \_\_\_\_\_ FT.

ABSORBENT AREA 637.5 SQ. FT.

4  
 75  
 85  
 375  
 600  
 637.5

REMARKS \_\_\_\_\_  
 \_\_\_\_\_  
 \_\_\_\_\_  
 \_\_\_\_\_  
 \_\_\_\_\_

DATE SYSTEM APPROVED 15 Apr 77

INSPECTOR R Biggs

This is to certify that the trench  
for my drain field was from 12' to 11' in  
depth as I witnessed on 15 April 1977

Harold Hayes

Property owner

6906 Deer Valley Rd  
Highland, Md.