

5-12-77 F.F. app

5/10/77  
5/11/77 a.m. if possible

# PERMIT

SEWAGE DISPOSAL SYSTEM

MARYLAND STATE DEPARTMENT OF HEALTH

HOWARD COUNTY

ELLICOTT CITY

DISTRICT 5th

## INDEXED

DATE 5/4/77

P 25773

A \_\_\_\_\_

Olen Ketterman

IS PERMITTED TO INSTALL \_\_\_\_\_ ALTER X

ADDRESS 6119 Jerry's Drive, Columbia, Md. 21044

PHONE 997-8740

A SEWAGE DISPOSAL SYSTEM LOCATED AT \_\_\_\_\_

SUBDIVISION Cedar Acres

ROAD Hilltop Road - off Cedar Lane

LOT \_\_\_\_\_

PROPERTY OWNER Mr. Ray Taylor

ADDRESS Hilltop Road, Clarksville, Md. 21029

SPECIFICATIONS 3 bedrooms

DRAIN FIELD \_\_\_\_\_ DEPTH \_\_\_\_\_ FEET, BOTTOM AREA \_\_\_\_\_ SQ. FT.

SEEPAGE PITS \_\_\_\_\_ ABSORBENT SIDE-WALL AREA \_\_\_\_\_ SQ. FT.

SEPTIC TANK CAPACITY 1000 GALLONS

FOR GARBAGE GRINDER, INCREASE DISPOSAL AREA 22% & TANK CAPACITY 50%.

OTHER REPAIR - Replace septic tank. - Spoke to Ketterman by phone. Told him add minimum 360 # turned upon 5/10/77


PLANS APPROVED BY Palmer F. Wine

DATE 5/4/77

FILL SEPTIC TANK AND DISTRIBUTION BOX WITH WATER BEFORE CALLING FOR AN INSPECTION. COVER NO WORK UNTIL INSPECTED AND APPROVED.

NEITHER THE HOWARD COUNTY COMMISSIONERS NOR THE HEALTH DEPARTMENT IS RESPONSIBLE FOR THE SUCCESSFUL OPERATION OF ANY SYSTEM.

25773

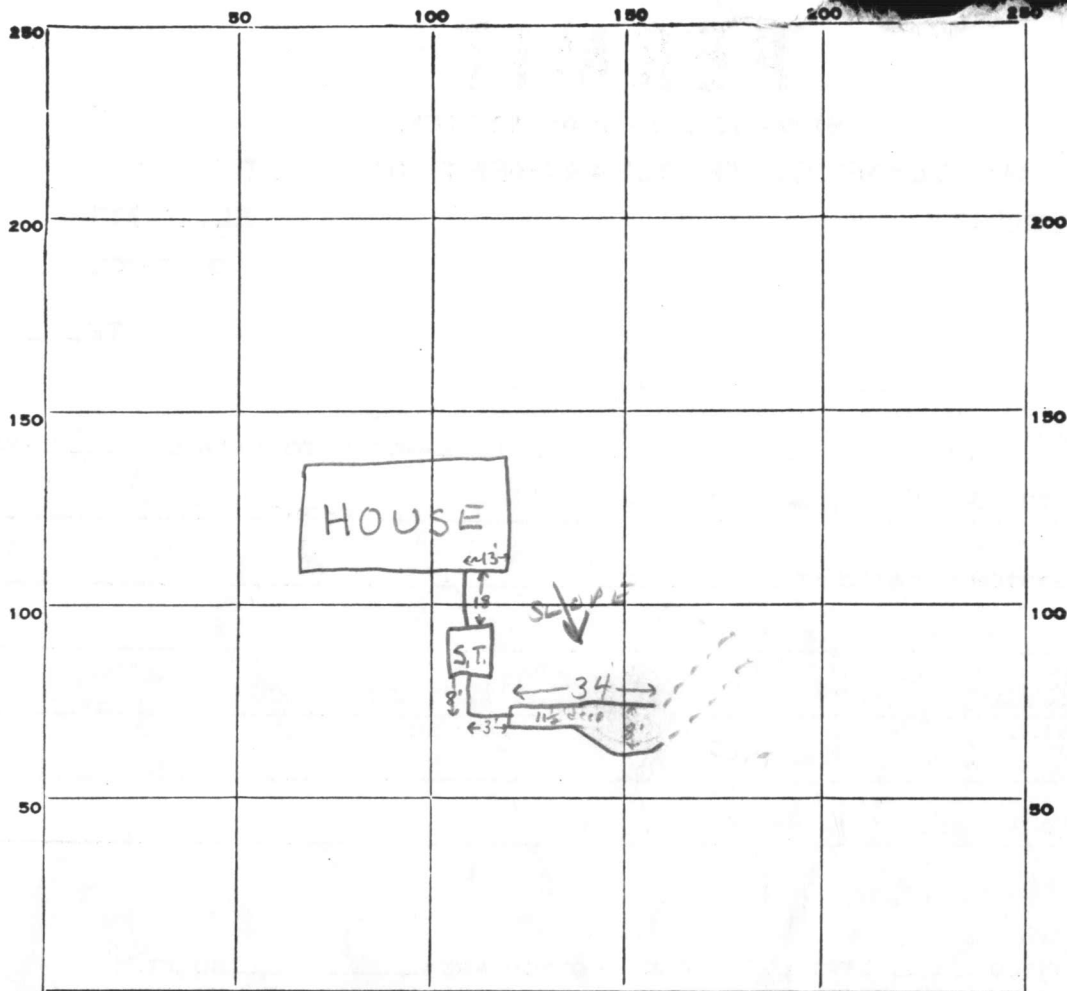

INDICATE NORTH. NAME ADJOINING ROADWAY AS BASE LINE.

Hilltop Lane

PERMIT CARD \_\_\_\_\_

SEPTIC TANK, LEVEL  \_\_\_\_\_

CLEANOUTS

|      |        |
|------|--------|
| S.T. | trench |
| O.K. | n.a    |

DISTRIBUTION BOX, LEVEL n.a. \_\_\_\_\_

TILE FIELD, DEPTH \_\_\_\_\_ FT. TRENCH WIDTH 2 → 8 FT.

GRAVEL DEPTH \_\_\_\_\_ <sup>FT</sup> IN. TOTAL LENGTH \_\_\_\_\_ FT.

NUMBER OF TRENCHES 1

1/2 SIDEWALL  
TOTAL BOTTOM AREA \_\_\_\_\_

SEEPAGE PITS, INSIDE DIAMETER \_\_\_\_\_ FT. DEPTH BELOW INLET \_\_\_\_\_ FT.

ABSORBENT AREA \_\_\_\_\_ SQ. FT.

REMARKS 5/10/77 S.tank not yet connected; 5/10/77 S. Tank o.k. trench dug  
34' x 1 1/2' x 2' → 8' o.k. to add gravel in trench. 5/11/77 T.C. = O.Ketterman, trench  
is carrying in, gave o.k. to gravel trench as it is dug out T.C.  
No paper in trench P103 5/11/77

DATE SYSTEM APPROVED

5-12-77

INSPECTOR

*L. Somerville*