

01-182692

In AM 5/16/77 unless  
P 25802 calls others

# PERMIT

SEWAGE DISPOSAL SYSTEM

MARYLAND STATE DEPARTMENT OF HEALTH

HOWARD COUNTY

ELLICOTT CITY

DISTRICT 1st

DATE 5/9/77

INDEXED

5/13/77 Partial  
see back  
verify  
last 10'  
+ trench  
12' deep

5/16/77  
a.m.

~~5/12/77~~  
~~5/13/77~~  
2:30 P.M.

Clifford Neubauer

IS PERMITTED TO INSTALL ALTER X

ADDRESS 6161 Meadowridge Road, Elkridge, Md.

PHONE 796-4117

A SEWAGE DISPOSAL SYSTEM LOCATED AT

SUBDIVISION ROAD 6239 Montgomery Road LOT

PROPERTY OWNER Mr. Michael A. Wade

ADDRESS 6239 Montgomery Road, Baltimore, Md. 21227

Phone: 796-4171

SPECIFICATIONS

DRAIN FIELD DEPTH FEET, BOTTOM AREA SQ. FT.

SEEPAGE PITS ABSORBENT SIDE-WALL AREA SQ. FT.

SEPTIC TANK CAPACITY GALLONS

FOR GARBAGE GRINDER, INCREASE DISPOSAL AREA 22% & TANK CAPACITY 50%.

OTHER REPAIR - Call for inspection when ground is opened up and Sanitarian will

recommend repair system. → minimum 350 sq. ft. sidewall area in trench, 5'

~60' long; max depth 12' see comment on reverse side P.S.

see back

BLDG. PERMIT SIGNED  
AND RETURNED 5/24/77  
Serial No. 31825


PLANS APPROVED BY Palmer F. Wine

DATE 5/9/77

FILL SEPTIC TANK AND DISTRIBUTION BOX WITH WATER BEFORE CALLING FOR AN INSPECTION. COVER NO WORK UNTIL INSPECTED AND APPROVED.

NEITHER THE HOWARD COUNTY COMMISSIONERS NOR THE HEALTH DEPARTMENT IS RESPONSIBLE FOR THE SUCCESSFUL OPERATION OF ANY SYSTEM.

P 25802

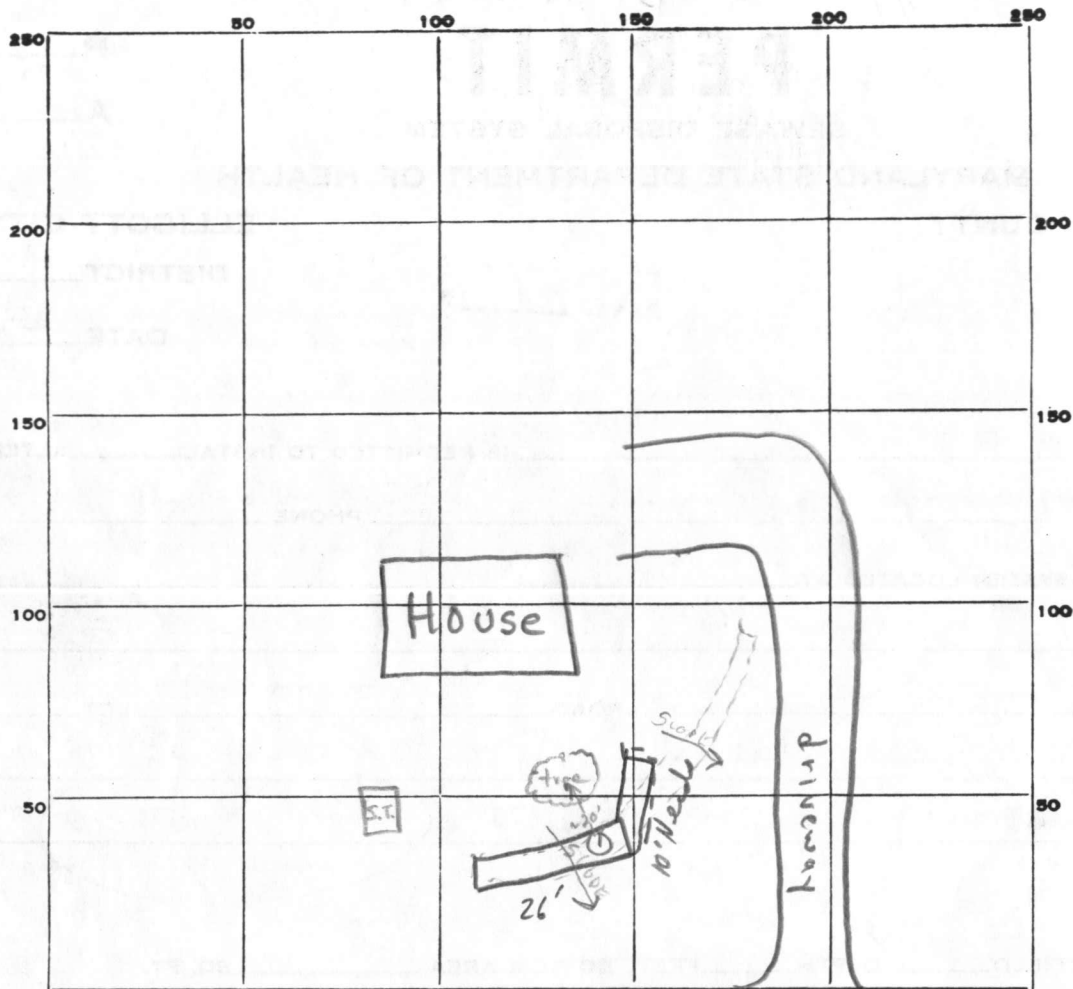

INDICATE NORTH. - NAME ADJOINING ROADWAY AS BASE LINE.

← to Ellicott City

Montgomery Road

to → Elkridge

PERMIT CARD \_\_\_\_\_

SEPTIC TANK, LEVEL \_\_\_\_\_

CLEANOUTS \_\_\_\_\_

DISTRIBUTION BOX, LEVEL \_\_\_\_\_

TILE FIELD, DEPTH 12(?) FT. TRENCH WIDTH 2-4 FT.

GRAVEL DEPTH 6-7 IN. TOTAL LENGTH \_\_\_\_\_ FT.

35'  
7'  
245

NUMBER OF TRENCHES 1 TOTAL BOTTOM AREA 245

SEEPAGE PITS, INSIDE DIAMETER \_\_\_\_\_ FT. DEPTH BELOW INLET \_\_\_\_\_ FT.

ABSORBENT AREA 245 SQ. FT.

REMARKS 5/12/77 Hole dug 12' deep; ~4-5' clay soil; sandy below. Recommend trench ~60' long = 6' gravel under pipe. Location as shown in above sketch F.S.

partial 5/13/77 Note cavity in - sandy on trench 35' because first 26' is 4'+ in most places - 12' deep. Note to call on permit if changed from A.M.; owner Mr. Wade to confirm last 10' + 12' depth.

DATE SYSTEM APPROVED 16/may 77

INSPECTOR R. M. Mumford (as per CB's D)

