

PERMIT

SEWAGE DISPOSAL SYSTEM

MARYLAND STATE DEPARTMENT OF HEALTH

HOWARD COUNTY

De-421407

ELLICOTT CITY

DISTRICT 6th

DATE 5/18/77

P 25886

*3-10-78
inst
not opp
Duma*

INDEXED

James W. Lenczycki

IS PERMITTED TO INSTALL _____ ALTER

ADDRESS 6399 Old Washington Blvd., Elkridge, Md. 21227 PHONE 796-0511

A SEWAGE DISPOSAL SYSTEM LOCATED AT _____

SUBDIVISION "The Dedars" ROAD 7268 Cedar Avenue LOT _____

PROPERTY OWNER Hosea Phillips

ADDRESS 7268 Cedar Avenue, Jessup, Md. 20794

SPECIFICATIONS

DRAIN FIELD _____ DEPTH _____ FEET, BOTTOM AREA _____ SQ. FT.

SEEPAGE PITS _____ ABSORBENT SIDE-WALL AREA _____ SQ. FT.

SEPTIC TANK CAPACITY _____ GALLONS

FOR GARBAGE GRINDER, INCREASE DISPOSAL AREA 22% & TANK CAPACITY 50%.


OTHER Install sealed tank with a visual or audible alarm device. Mininum requirement for sealed tank is 1500 gallons.

PLANS APPROVED BY Fred ~~KHX~~ Frommelt DATE 5/18/77

FILL SEPTIC TANK AND DISTRIBUTION BOX WITH WATER BEFORE CALLING FOR AN INSPECTION. COVER NO WORK UNTIL INSPECTED AND APPROVED.

NEITHER THE HOWARD COUNTY COMMISSIONERS NOR THE HEALTH DEPARTMENT IS RESPONSIBLE FOR THE SUCCESSFUL OPERATION OF ANY SYSTEM.

*P
25886*

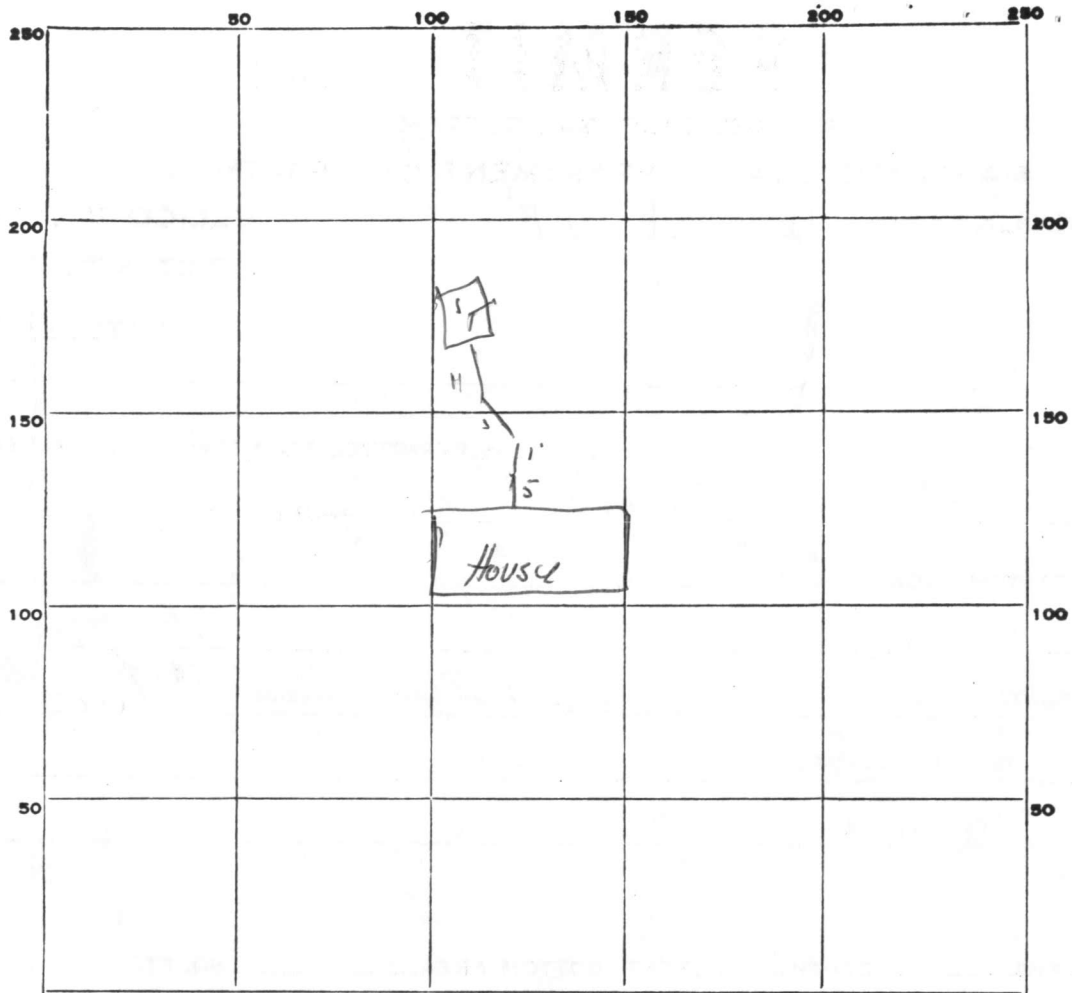

INDICATE NORTH. - NAME ADJOINING ROADWAY AS BASE LINE.

PERMIT CARD _____

SEPTIC TANK, LEVEL _____

CLEANOUTS _____

DISTRIBUTION BOX, LEVEL _____

TILE FIELD, DEPTH _____ FT. TRENCH WIDTH _____ FT.

GRAVEL DEPTH _____ IN. TOTAL LENGTH _____ FT.

NUMBER OF TRENCHES _____ TOTAL BOTTOM AREA _____

SEEPAGE PITS, INSIDE DIAMETER _____ FT. DEPTH BELOW INLET _____ FT.

ABSORBENT AREA _____ SQ. FT.

REMARKS ^{6/21/77} Sealed Tank installed - ok to cover -
 alarm not yet installed to be done w/ plumber

DATE SYSTEM APPROVED 3-10-78 inst. not app INSPECTOR [Signature]

0511



Modern Plumbing and Heating

JAMES W. LENCZYCKI, REG. PLUMBER

PLUMBING - HEATING - AIR CONDITIONING

6399

REGISTERED - BONDED - INSURED

6625 OLD WASHINGTON BOULEVARD, ELK RIDGE, BALTIMORE, MD., 21227 _____ 19__

To _____

All Service Calls
C. O. D.

Permit for Hosea J. Phillips
7268 Cedar Ave.
Jessup, Md. 20794
Ser. # 29201
Ref. # 41556

Home address
1842 Capital ave, N.E.
Wash. D.C. 20002

1500 gal. minimum with
alarm device. Visual or audible.