

Preliminary

APPLICATION

A 15594

SEWAGE DISPOSAL TESTING

P _____

MARYLAND STATE DEPARTMENT OF HEALTH

HOWARD COUNTY

ELLICOTT CITY

DISTRICT 2

DATE 10/19/70

TO: THE COUNTY HEALTH OFFICER
ELLICOTT CITY, MARYLAND

I, HEREBY, APPLY FOR THE NECESSARY TESTS IN ORDER TO CONSTRUCT (OR RECONSTRUCT) A SEWAGE DISPOSAL SYSTEM.

PROPERTY OWNER Earl H. Heckman

ADDRESS Bonnie Branch Road, Ellicott City, Md. PHONE _____

PROPERTY LOCATION:

SUBDIVISION (Earl H. Heckman property - no name) LOT NO. 2

ROAD AND DESCRIPTION Bonnie Branch Road

OCCUPANT _____ PHONE _____

PERSON TO CONSTRUCT SYSTEM _____

ADDRESS _____ PHONE _____

SIZE OF LOT 40,000 sq ft. TYPE BLDG. 3 or 4
NUMBER OF BEDROOMS

IF NOT SINGLE RESIDENCE DESCRIBE _____

SIGNATURE OF APPLICANT /s/ Betty J. Heckman

APPROVED BY _____ FOR _____ DATE _____
(KIND OF SYSTEM)


REJECTED BY _____ FOR _____ DATE _____
(KIND OF SYSTEM)

HOLD PENDING FURTHER TESTS James T. Wright DATE 10/21/70

REASONS FOR REJECTION OR HOLDING _____

THIS IS NOT A PERMIT

60

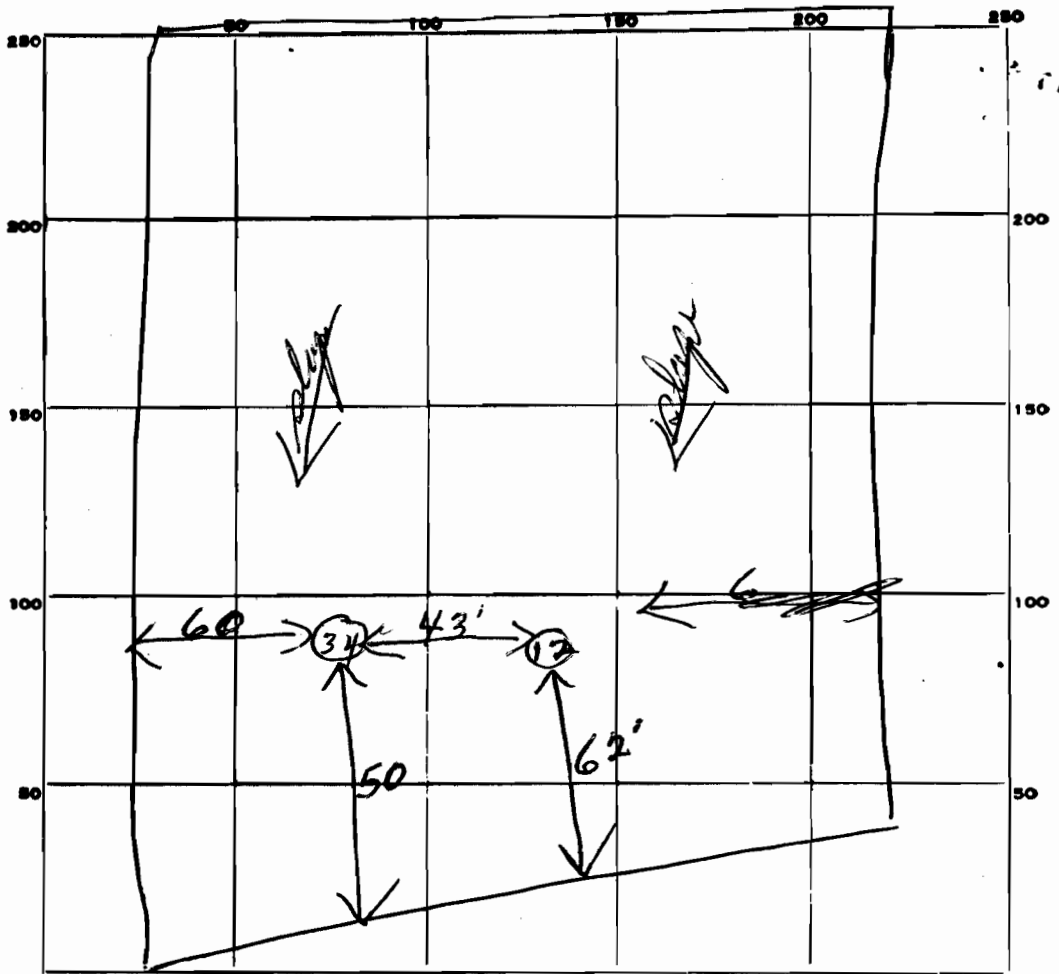

INDICATE NORTH. - NAME ADJOINING ROADWAY AS BASE LINE.

Barnie Branch Rd

DATE	TEST NO.	DEPTH	PRE-WET		TEST - 1" DROP		TIME
			START	STOP	START	STOP	
11/10/70	1	13'	11:18	11:25	11:25	11:30	5 in
	2	5'	11:20	11:24	11:24	11:30	6 in
	3	13	11:34	11:46	11:46	12:10	14 in
	4	5 1/2	11:34	12:06	Slow over turn		
Shallow hole ^{no. 4} to be 1 ft deeper.							

lot 2

SOIL AUGER FINDING _____

TESTED BY 

REMARKS 



Purdum and Jeschke,
 Engineers
 5697 Park Avenue
 Ellicott City, Maryland 21043

PRELIMINARY PLAN
 PROPERTY OF
 EARL H. HECKMAN
 2ND ELECT. DIST. HOWARD CO., MD.
 SCALE: 1"=100' OCT. 15, 1970