

11/26/91 10/00
(DATE TELEPHONED TO 208-F.R.C.C.)

APPLICATION

PERCOLATION TESTING

A 47612
P _____

HOWARD COUNTY HEALTH DEPARTMENT
BUREAU OF ENVIRONMENTAL HEALTH
P.O. BOX 476 ELLICOTT CITY, MARYLAND 21043
TELEPHONE. 461-9933

PERVIEW OK
2 LOT SUBD.
NOTE TO INSPECTOR: - BE ALERT TO POTENTIAL IMPACT TO
WELL SITE ON LOTS ACROSS WARFIELD RD.
(PROBABLY NOT AN ISSUE) CW.
11/8/91

DISTRICT _____

DATE 11/8/91

TO: THE COUNTY HEALTH OFFICER
ELLICOTT CITY, MARYLAND

I HEREBY APPLY FOR THE NECESSARY TEST IN ORDER TO CONSTRUCT (OR RECONSTRUCT) A SEWAGE DISPOSAL SYSTEM.

PROPERTY OWNER THEODORE F. MARIANI Andrew + Nancy Molnar

ADDRESS 16449 ED WARFIELD ROAD WOODBINE MD. 21797 PHONE 410-730-6436
1-202-462-5656

PROSPECTIVE BUYER _____

ADDRESS _____ PHONE _____

PROPERTY LOCATION:

SUBDIVISION MARIANI PROPERTY LOT NO. 1

ROAD AND DESCRIPTION 16215' ED WARFIELD ROAD

TAX MAP 13 PARCEL # 317

SIZE OF LOT 7.738 AC. TYPE BLDG S.F.D.
(SINGLE FAMILY DWELLING OR COMMERCIAL)

THE SYSTEM INSTALLED UNDER THIS APPLICATION IS ACCEPTABLE ONLY UNTIL PUBLIC FACILITIES BECOME AVAILABLE. I FULLY UNDERSTAND THE FEE CONNECTED WITH THE FILING OF THIS PERC TEST APPLICATION IS NON-REFUNDABLE UNDER ANY CIRCUMSTANCES. I ALSO AGREE TO COMPLY WITH ALL M.O.S.H.A. REQUIREMENTS IN TESTING THIS LOT.

Zacharia y. Fisch (agent)
(SIGNATURE OF APPLICANT)

APPROVED BY _____ FOR _____ DATE _____

REJECTED BY _____ FOR _____ DATE _____

HOLD PENDING FURTHER TESTS _____ DATE _____

REASONS FOR REJECTION OR HOLDING 11/20/91 PERC OK HOLD FOR PLAT R/H



BLDG. PERMIT SIGNED
AND RETURNED 9/10/93
Serial # 30985
SFD - 4 Bedroom

THIS IS NOT A PERMIT

HD-216

Lot 1

ON LINE
SOIL PROFILE

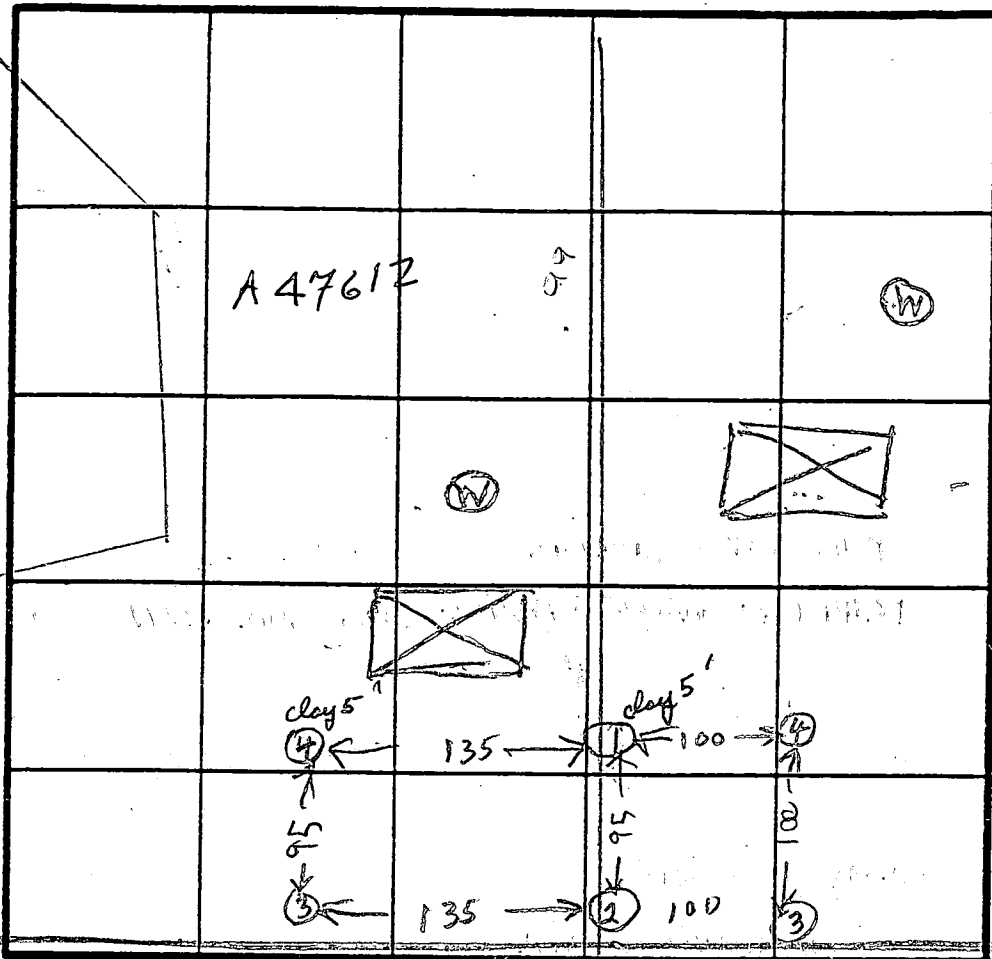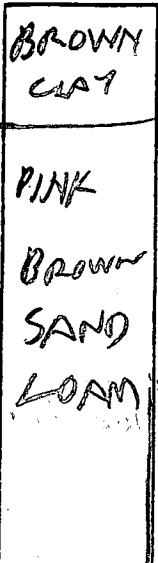

46
32
90
95
43
Σ = 9
210' BL
Inset 5'
Bottom 9'

INDICATE NORTH - NAME ADJOINING ROADWAY AS BASE LINE.

211 WARFIELD RD




DATE	TEST NO.	DEPTH	PRE-WET		TEST - 1" DROP		TIME	
			START	STOP	START	STOP		
11/20/91	1 S	6 1/2	1040	1045	1045	1051	6	ON LINE HOLE LOT 182
	1 V	10	1040	1041	1041	1045	4	
	1 V	12 1/2	OK deep					
	2 S	7	1054	1057	1057	1105	8	ON LINE LOT 182
	2 V	12 1/2	OK deep					
	3 S	5 1/2	1105	1108	1108	1126	18	
	3 V	12 1/2	OK deep					
+	4 V	13 1/2	OK deep					

REMARKS _____

TYPE OF SOIL _____

TESTED BY R. HODGES

ALSO PRESENT TED MARIANT JR
HUGH OR KETTERMAN
OLEN KETTERMAN
OLEN JR

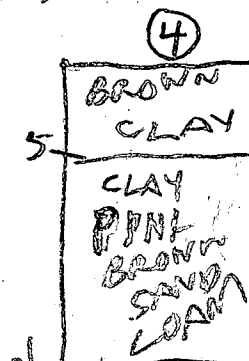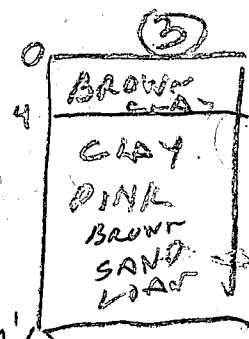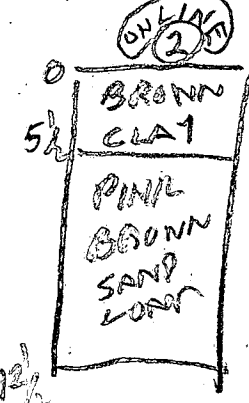

13 1/2