

12/7/78
12/13/78

12/13/78 P.C.O.
c.B.S.
P. 29215
A. 26211 1/10/79 P.C.O.
c.B.S.

PERMIT

SEWAGE DISPOSAL SYSTEM

MARYLAND STATE DEPARTMENT OF HEALTH*

HOWARD COUNTY

05-382947

ELLICOTT CITY

DISTRICT 5th

INDEXED

DATE 11/13/78

Mitchell-Wiley

IS PERMITTED TO INSTALL X ALTER

ADDRESS _____

PHONE _____

SUBDIVISION Hallmark

7398 Hopkins Way

ROAD ~~Johns Hopkins Road~~

LOT 50, Sec. 1

PROPERTY OWNER John Mikolosko

ADDRESS _____

SPECIFICATIONS 4 bedrooms

SEPTIC TANK CAPACITY 1250 GALLONS

DRAIN FIELD _____ DEPTH _____ FEET. BOTTOM AREA _____ SQ. FT.

DEEP TRENCH _____ DEPTH _____ FEET. BOTTOM AREA _____ SQ. FT.

SEEPAGE PITS _____ ABSORBENT SIDE-WALL AREA 130 SQ. FT. per bedroom, 288 sq. ft. in dry well.

INLET PIPE 4 FT. BELOW ORIGINAL GRADE. MAXIMUM DEPTH 10 FT. BELOW ORIGINAL GRADE

EFFECTIVE DEPTH AT _____ FT. BELOW ORIGINAL GRADE.

LOCATE DISPOSAL AREA 125 FT. FROM front LOT LINE AND 45 FT. FROM _____ LOT LINE AS SEEN WHEN

~~SEEN WHEN~~ Johns Hopkins Road.

TRENCH-to be 60 ft. long with inlet at 4 ft. and maximum depth 10 ft. Run trench parallel to Hopkins Way, 130 ft. from Hopkins Way.

PLANS APPROVED BY David O'Neill

DATE 11/19/77

COVER NO WORK UNTIL INSPECTED AND APPROVED.

NEITHER THE HOWARD COUNTY COUNCIL NOR THE HEALTH DEPARTMENT IS RESPONSIBLE FOR THE SUCCESSFUL OPERATION OF ANY SYSTEM.

NOTE: IF TRENCH IS USED CALL FOR INSPECTION BEFORE PLACING GRAVEL IN TRENCH.

NOTE: NO DRY WELL SHALL EXCEED 15 FOOT IN DIAMETER.

NOTE: ALL PIPE FROM HOUSE TO DISPOSAL AREA MUST BE CAST IRON.

PERMIT VOID AFTER THREE YEARS.


NOTE: INSTALL STAND PIPE ON SEPTIC TANK AND DRY WELL. STAND PIPES MUST BE 6 INCHES IN DIAMETER. CAST IRON, CONCRETE OR TERRA

COTTA ACCEPTED.

***INSTALLER IS RESPONSIBLE FOR OBTAINING FINAL APPROVAL ON THIS PERMIT.**

~~OLD PERMITS~~
~~NO PERMITS~~ 8/9/01
B00131910
2 12'x12' Horse stalls w/
attached 12' wide overhang

A 26211

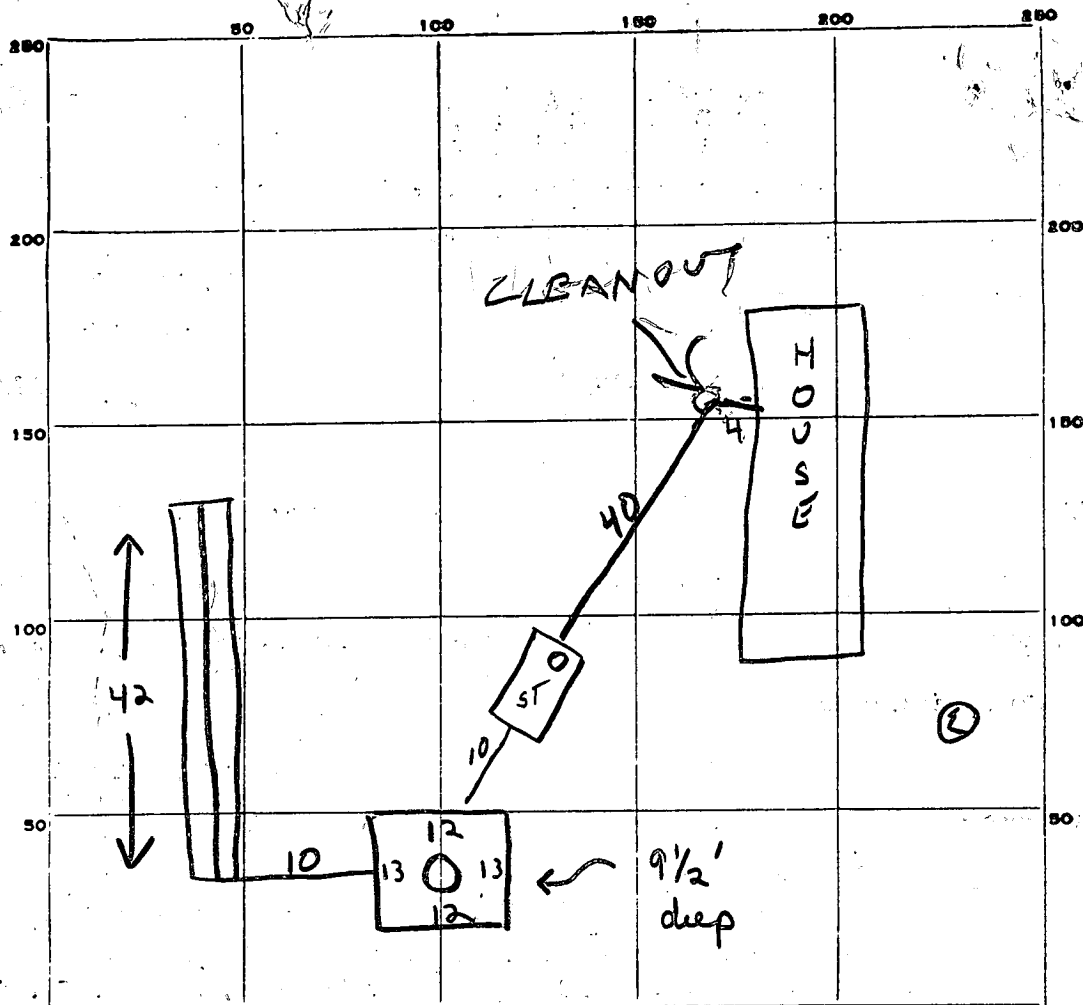

17 1/2
294

INDICATE NORTH. - NAME ADJOINING ROADWAY AS BASE LINE.

JOHNS HOPKINS RD

PERMIT CARD

(Not seen) spoke to man w/ flare of Mitchell

SEPTIC TANK, LEVEL 1250

ST	DW
12/13	OK

DISTRIBUTION BOX, LEVEL

1/10/79 C.B.D. C.B.D.
N. Masphy

TILE FIELD, DEPTH 10 FT. TRENCH WIDTH 2 FT.

GRAVEL DEPTH 6' TOTAL LENGTH 42 FT.

252

NUMBER OF TRENCHES 1 TOTAL 1/25W BOTTOM AREA

(± 294')

SEEPAGE PITS, INSIDE DIAMETER 50 FT. DEPTH BELOW INLET 5.5 FT.

± 275

ABSORBENT AREA 529 SQ. FT.

12/13/78
(No)

12/13/78

569

REMARKS 7 Dec. 78 - Call for final when; house connection & cleanouts are installed, gravel added to drywell's trench. House sewer must be properly supported (GLK)

12/13/78 - checked found house connection not in - pointed ok to cover to 10' of house, sewer pipe need to see house connection, C.B.D.

1/10/79 Checked found - no change - no house connection - graded to area of proper connection C.B.D. (also septic tank plug raised C.B.D.)

DATE SYSTEM APPROVED

3/27/79

INSPECTOR

R. Hodges

SEE BACK OF YELLOW WELL SHEET

APPLICATION

A 26211

P _____

SEWAGE DISPOSAL TESTING

STATE OF MARYLAND - DEPARTMENT OF HEALTH AND MENTAL HYGIENE

HOWARD COUNTY HEALTH DEPARTMENT
ENVIRONMENTAL HEALTH SERVICES
P. O. BOX 476, ELLICOTT CITY, MARYLAND 21043
TELEPHONE: 465-5000, EXT. 356

DISTRICT 5TH

DATE JUNE 22, 1977

TO: THE COUNTY HEALTH OFFICER
ELLICOTT CITY, MARYLAND

I, HEREBY, APPLY FOR THE NECESSARY TEST IN ORDER TO CONSTRUCT (OR RECONSTRUCT) A SEWAGE DISPOSAL SYSTEM.

PROPERTY OWNER DONALD SIMPSON

ADDRESS JOHNS HOPKINS ROAD CLARKSVILLE MARYLAND PHONE 725-2847

PROPERTY LOCATION:

SUBDIVISION HALLMARK SECTION I LOT NO. 19

ROAD AND DESCRIPTION JOHNS HOPKINS ROAD

SIZE OF LOT 40,000^{sq} TYPE BLDG. 30R4
NUMBER OF BEDROOMS _____

IF NOT SINGLE RESIDENCE DESCRIBE _____

THE SYSTEM INSTALLED UNDER THIS APPLICATION IS ACCEPTABLE ONLY UNTIL PUBLIC FACILITIES BECOME AVAILABLE.

SIGNATURE OF APPLICANT Charles J. Conrad

APPROVED BY Paul J. O'Neil FOR Dry Well + Trench DATE 11/29/79
(KIND OF SYSTEM)

REJECTED BY _____ FOR _____ DATE _____
(KIND OF SYSTEM)

HOLD PENDING FURTHER TESTS _____ BLDG. PERMIT SIGNED _____ DATE _____

REASONS FOR REJECTION OR HOLDING #46536 (concrete) replaces wood lot


AND RETURNED 6/1/81
blgd. permit signed
5/5/78
serial # 33653

BLDG. PERMIT SIGNED
AND RETURNED 1/24/78

serial # 34571

THIS IS NOT A PERMIT

79

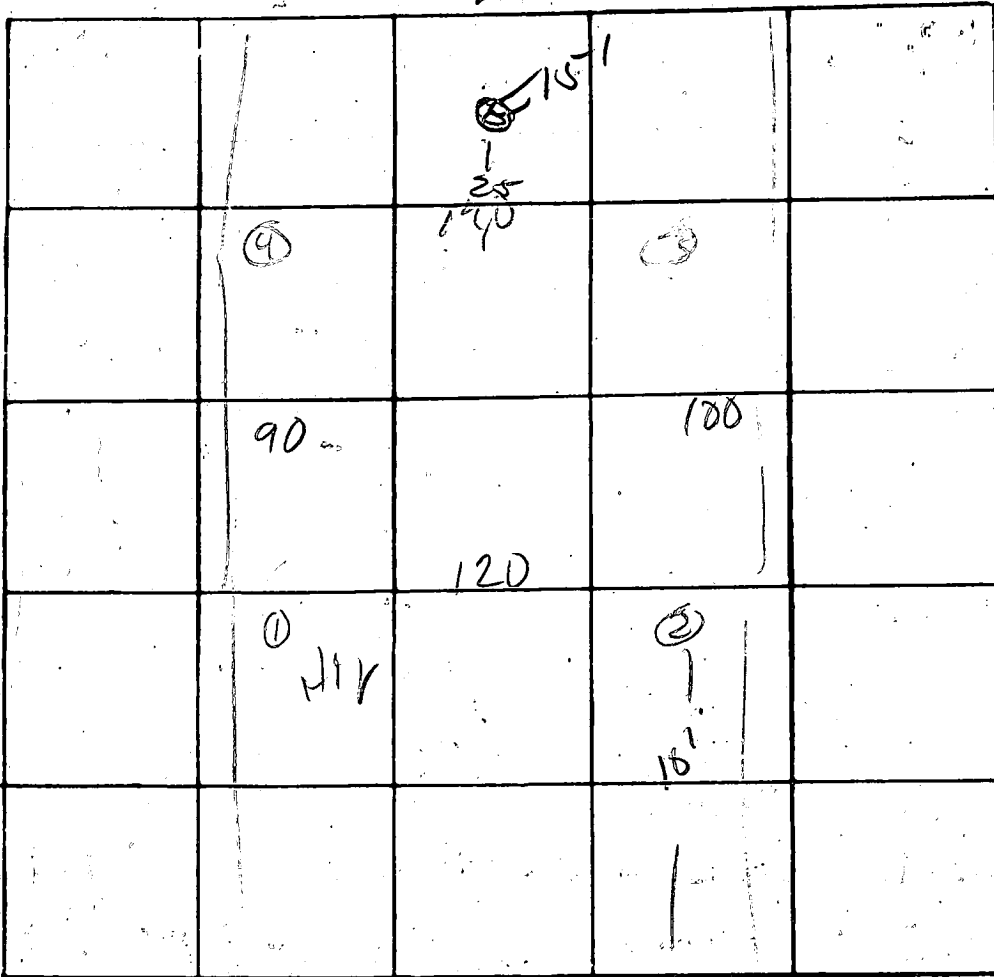

INDICATE NORTH. - NAME ADJOINING ROADWAY AS BASE LINE

Road

DATE	TEST NO.	DEPTH	PRE-WET		TEST - 1" DROP		TIME
			START	STOP	START	STOP	
	45	4	202			208	6
	9	13	202			208	6
	25	5	206			216	9
	9	15	206			216	9
	35	5	213	228	225	243	18
	9	13	213	219	219	228	9
	1	4-13-14	HIV hole!				
	5	15'	dry, looks good				

4
9
4

REMARKS _____

TYPE OF SOIL _____

TESTED BY _____ ALSO PRESENT: _____

Drainage Easement
50°33'N-40'13'


Drainage Easement

Drainage Easement
N 13°39'42"W-495.00'

JOHNS
N 13°39'40"W-150.00'

676°30'00"W-780.44'
576°20'30"W-805.33'

dedicated to Howard County, Md.

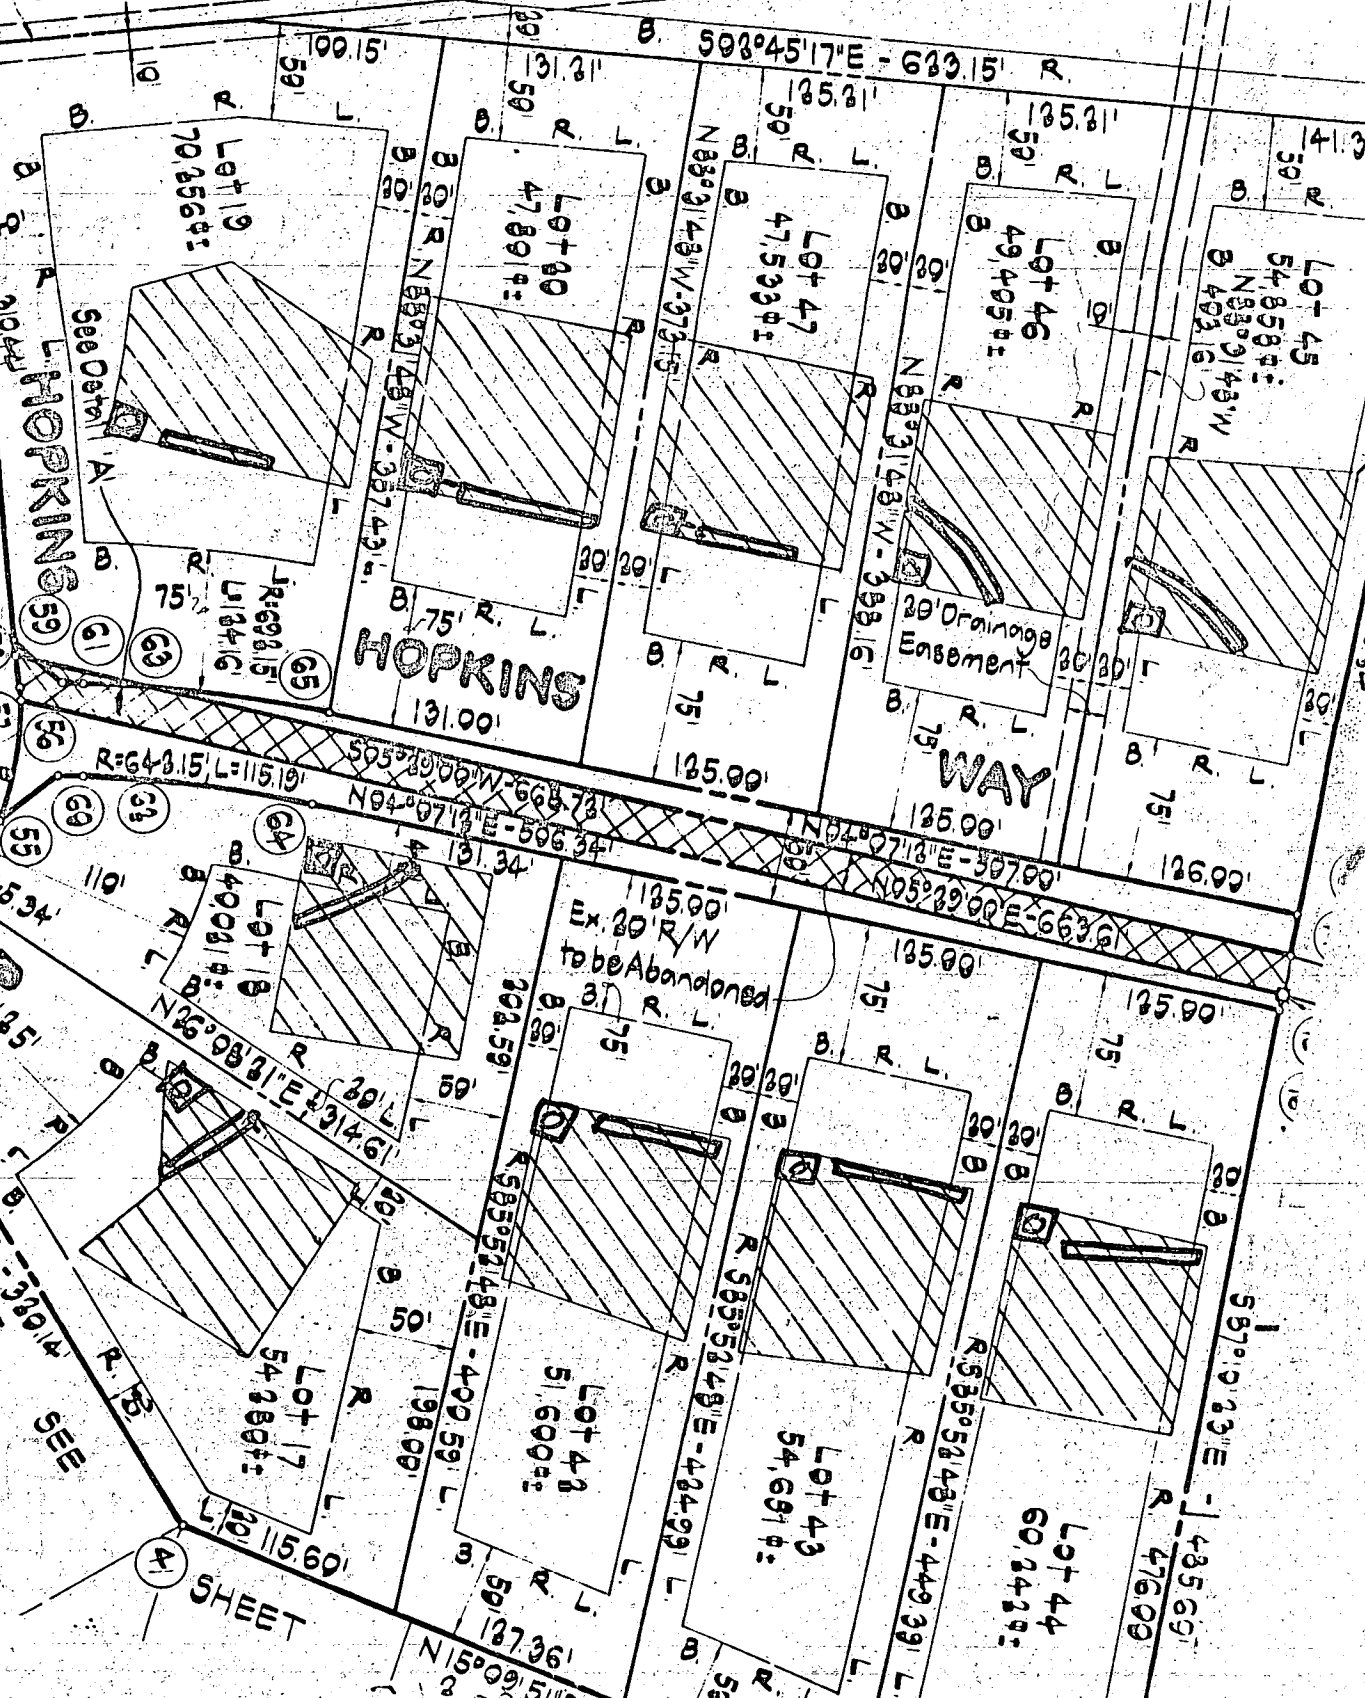

SHEET

C 1 8580 SEQUENCE NO. (WRA USE ONLY)

1 (THIS NUMBER IS TO BE PUNCHED IN COLUMNS 5-6 ON ALL CARDS)

DATE RECEIVED (WRA USE ONLY) May 19 1977

DATE WELL COMPLETED 2/85

DEPTH OF WELL 2185 (TO NEAREST FOOT) 22 26

PERMIT NO. FROM "PERMIT TO DRILL WELL" MD-73-2450

DRILLERS IDENTIFICATION NO. 1238

STATE OF MARYLAND
 WATER RESOURCES ADMINISTRATION
 TAWES STATE OFFICE BLDG., ANNAPOLIS, MD 21401
 WELL COMPLETION REPORT

THIS REPORT MUST BE SUBMITTED WITHIN 30 DAYS AFTER WELL COMPLETION

FILL IN THIS FORM COMPLETELY

COUNTY NUMBER 11111

OWNER Newberry LAST NAME James FIRST NAME

STREET OR RFD 475 Pine Street POST OFFICE TO U V...

WELL LOG

STATE THE KIND OF FORMATIONS PENETRATED, THEIR COLOR, DEPTH, THICKNESS AND IF WATER BEARING

DESCRIPTION (USE ADDITIONAL SHEETS IF NECESSARY)	FEET		CHECK IF WATER BEARING
	FROM	TO	
<u>Sand</u>	<u>0</u>	<u>47</u>	
<u>Gray Medium Sand</u>	<u>47</u>	<u>185</u>	

WELL DESCRIPTION

WELL HAS BEEN GROUTED (CIRCLE APPROPRIATE BOX) Y N

TYPE OF GROUTING MATERIAL (CIRCLE A BOX) C M BENTONITE CLAY B C

CEMENT C M BENTONITE CLAY B C

NO. OF BAGS 11 NO. OF POUNDS 1034

GALLONS OF WATER 66

DEPTH OF GROUT SEAL (TO NEAREST FOOT)

FROM 0 FT. TO 48 FT. (ENTER 0 IF FROM SURFACE)

PUMPING TEST

HOURS PUMPED (TO NEAREST HOUR) 2

PUMPING RATE (GALLONS PER MINUTE TO NEAREST GALLON) 6

METHOD USED TO MEASURE PUMPING RATE air

WATER LEVEL: (DISTANCE FROM LAND SURFACE)

BEFORE PUMPING 45 (NEAREST FOOT)

WHEN PUMPING 5 (NEAREST FOOT)

TYPE OF PUMP USED (CIRCLE APPROPRIATE BOX) (FOR PUMPING TEST)

A AIR P PISTON T TURBINE

C CENTRIFUGAL R ROTARY O OTHER (DESCRIBE BELOW)

J JET S SUBMERSIBLE

CASING RECORD

INSERT APPROPRIATE CODE BELOW

STEEL S T CONCRETE C O

PLASTIC P L OTHER O T

MAIN CASING TYPE S T NOMINAL DIAMETER TOP (MAIN) CASING (NEAREST INCH) 6 TOTAL DEPTH OF MAIN CASING (NEAREST FOOT) 50

OTHER CASING (IF USED)

EACH CASING	DIAMETER (INCH)	DEPTH (FEET)	
		FROM	TO

PUMP INSTALLED

TYPE OF PUMP (WRITE APPROPRIATE LETTER IN BOX - SEE ABOVE: A, C, J, P, R, S, T, O)

DRILLER WILL INSTALL PUMP (CIRCLE APPROPRIATE BOX) Y N

CAPACITY

GALLONS PER MINUTE (TO NEAREST GALLON) 31 35

PUMP HORSE POWER 37 41

PUMP COLUMN LENGTH (NEAREST FOOT) 43 47

SCREEN RECORD

INSERT APPROPRIATE CODE BELOW

STEEL S T BRASS OR BRONZE B R OPEN HOLE H O

PLASTIC P L OTHER O T

DEPTH (NEAREST WHOLE FOOT)

EACH SCREEN	DIAMETER (INCH)	DEPTH (NEAREST WHOLE FOOT)	
		FROM	TO
<u>H O</u>	<u>4</u>	<u>48</u>	<u>185</u>

SLOT SIZE 1, 2, 3

CASING HEIGHT (CIRCLE APPROPRIATE BOX AND ENTER CASING HEIGHT)

ABOVE } LAND SURFACE

BELOW } (NEAREST FOOT)

50 51

CIRCLE APPROPRIATE BOXES

A A WELL WAS ABANDONED AND SEALED WHEN THIS WELL WAS COMPLETED

E ELECTRIC LOG OBTAINED

P TEST WELL CONVERTED TO PRODUCTION WELL

I HEREBY CERTIFY THAT I HAVE COMPLIED WITH ALL CONDITIONS STATED ON THE ABOVE-CAPTIONED "PERMIT TO DRILL WELL", AND THAT INFORMATION CONTAINED IN THIS REPORT IS TRUE, ACCURATE, AND COMPLETE TO THE BEST OF MY KNOWLEDGE, INFORMATION AND BELIEF.

DRILLERS NAME Joseph L. Morgan

(PLEASE PRINT) Joseph L. Morgan

SIGNATURE Joseph L. Morgan

DIAMETER OF SCREEN 56 (NEAREST INCH) FROM 60 TO


GRAVEL PACK

IF WELL DRILLED WAS A FLOWING WELL CIRCLE BOX 68 F

WRA USE ONLY (NOT TO BE FILLED IN BY DRILLER)

T (E.R.O.S.) W Q

70 72 74 75 76 OTHER DATA AVAILABLE

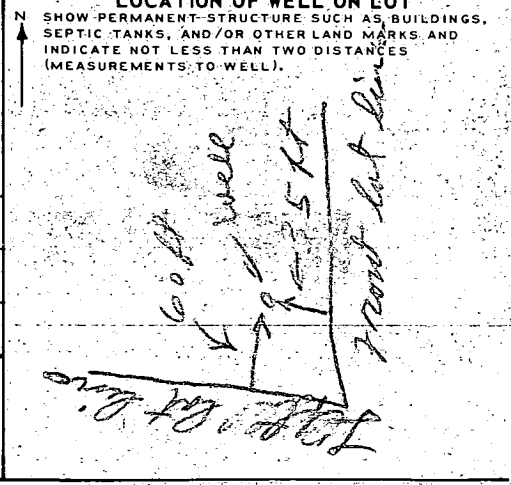

3/27/79 CONTINUED FROM SBDD
PERMIT #29215

HOUSE CONNECTION WITH
CLEANOUT ON HOUSE SEWER
FINISH OK TO COVER
HOUSE SEWER SYSTEM OK

RH


Owner Michael Clout & wife
7398 Hopkins Way
C/Noile, Md. 21029

NOTES:

1. THE LOTS SHOWN AND LOT AREAS HEALTH AND MENTAL IMPROVEMENTS OF PUBLIC SEWAGE AND VOID UPON HEALTH OFFICER ENCROACHMENTS IN A MODIFIED SEWAGE COUNTY GEODETIC THE PURPOSE OF LOT 19.
2. THIS AREA SQUARE FEET AS HEALTH AND MENTAL IMPROVEMENTS OF PUBLIC SEWAGE AND VOID UPON HEALTH OFFICER ENCROACHMENTS IN A MODIFIED SEWAGE COUNTY GEODETIC THE PURPOSE OF LOT 19.
3. THE COORDINATES COUNTY GEODETIC THE PURPOSE OF LOT 19.
4. THE PURPOSE OF LOT 19.

E 827,000

N 486,000

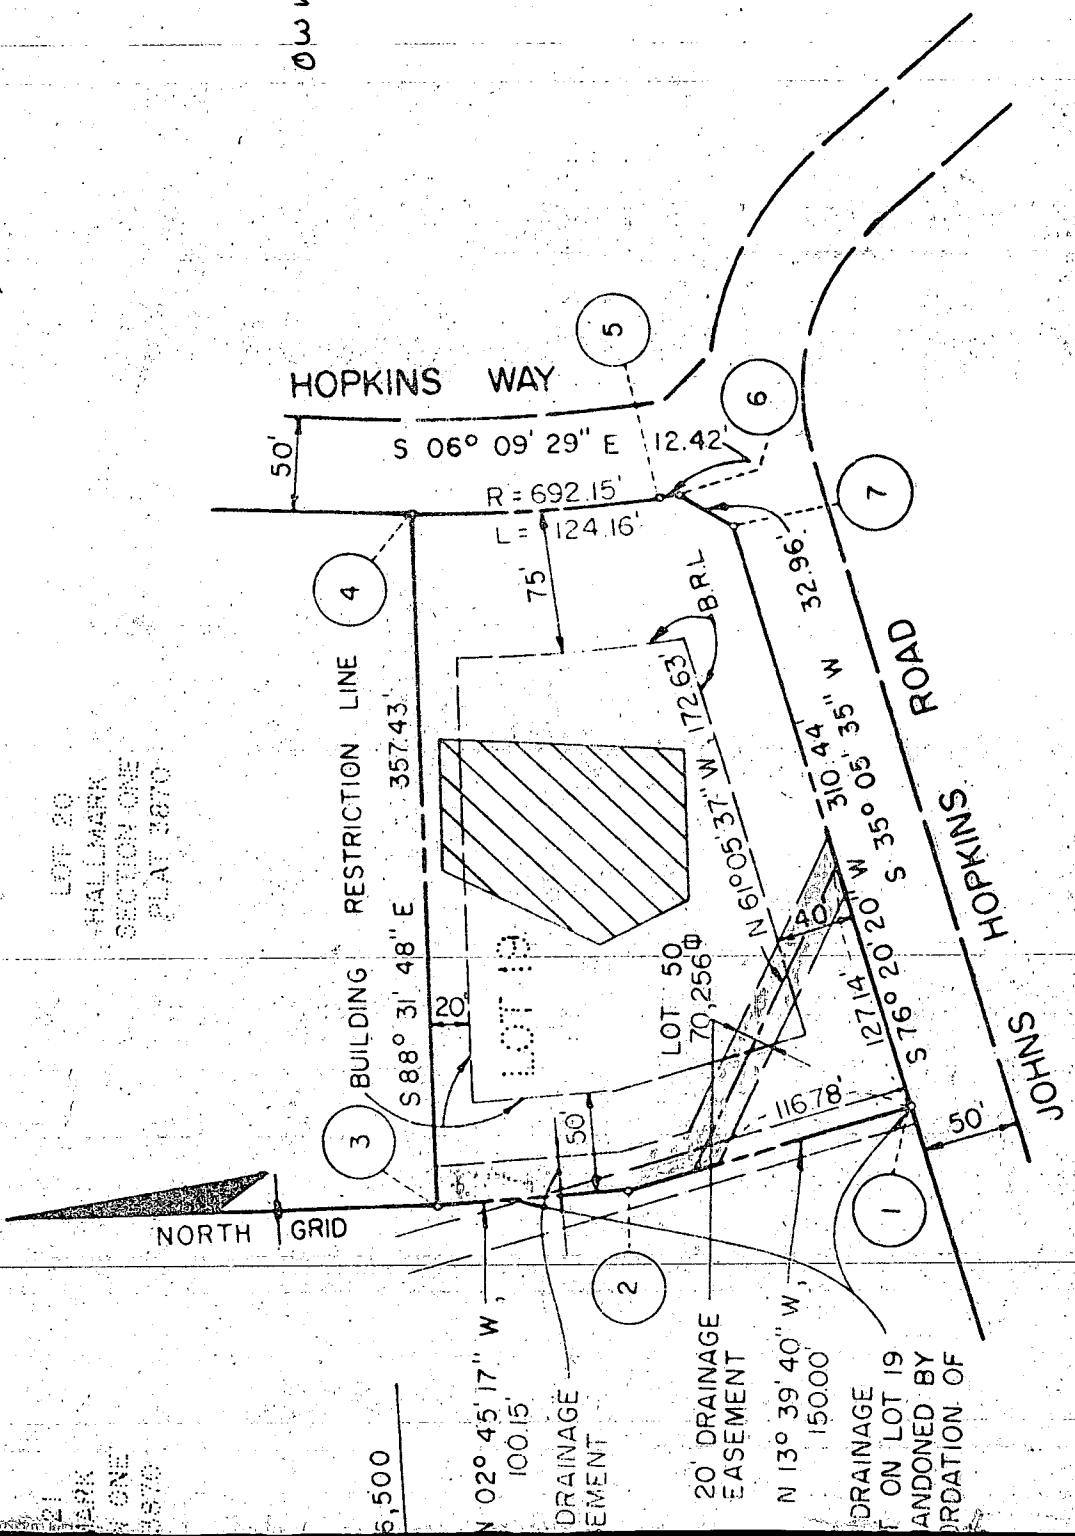

LOT 20
HALLMARK
SECTION ONE
PLAT 3870

LOT 21
HALLMARK
SECTION ONE
PLAT 3870


486,000

The plat is of benefit to a consumer only insofar as it is required by a lender or a title insurance company or its agent in connection with contemplated transfer, financing or re-financing. The plat is not to be relied upon for the establishment or location of fences, garages, buildings, or other existing or future improvements. The plat does not provide for the accurate identification of property boundary lines, but such identification may not be required for the transfer of title or securing financing or re-financing.

NOTE: The lot shown hereon does not lie within the limits of the 100 year flood plain as shown on FIRM Panel No. 34
Date of Map: 12-4-86
Flood Zone: 1C

NOTE: No property corners found or set unless otherwise noted.

NOTE: The accuracy of this survey and the apparent setback distances is 2 Ft. ±.

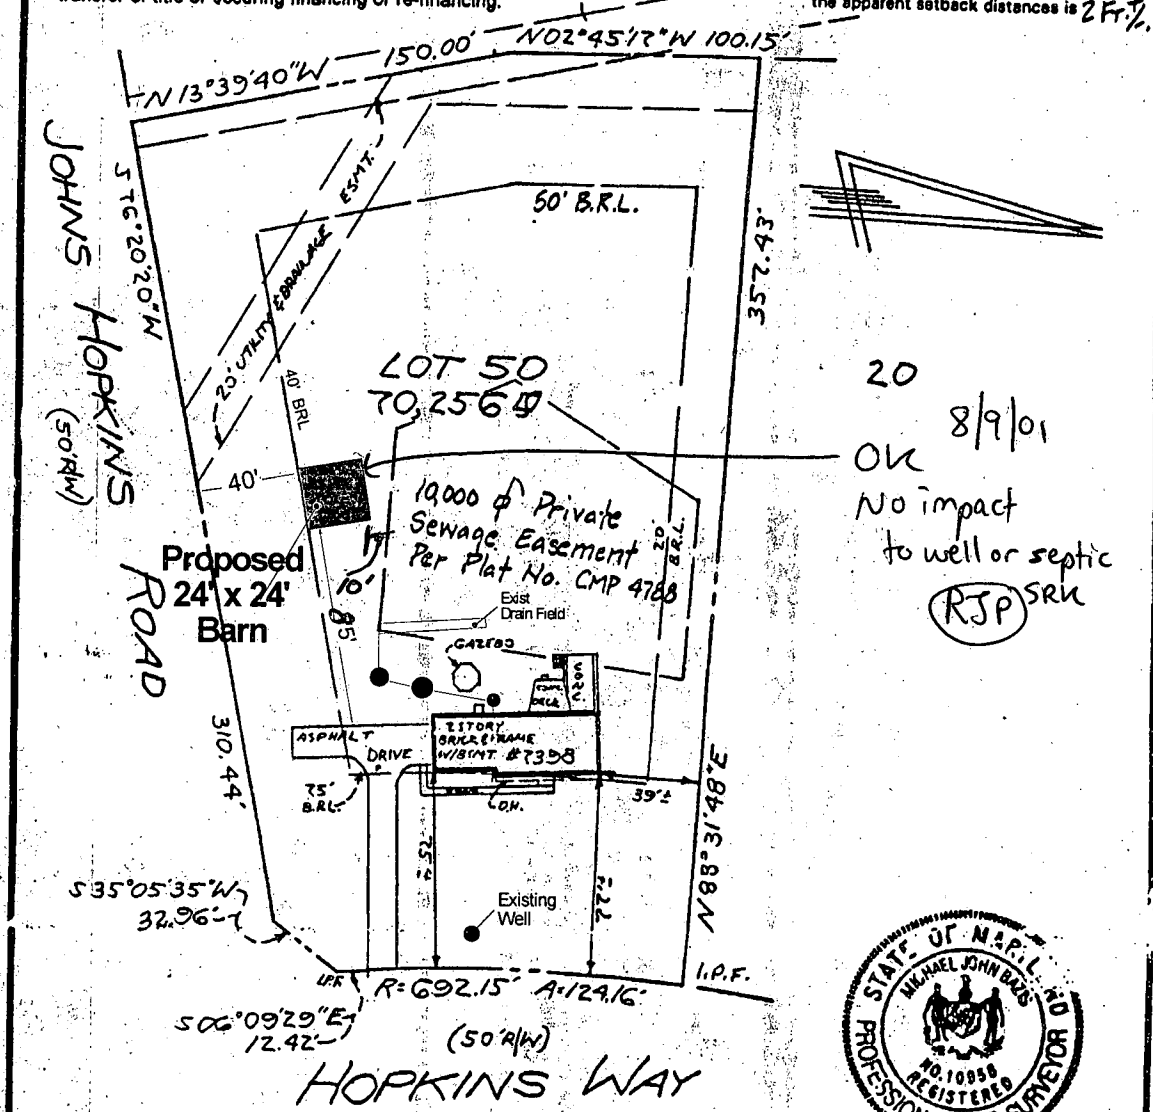

20
8/9/01
OK
No impact
to well or septic
(RJP)SRU



LOCATION DRAWING
LOT 50
HALLMARK
SECTION ONE
HOWARD COUNTY, MD.

SURVEYOR'S CERTIFICATE


I hereby certify that the property delineated hereon is in accordance with the Plat of Subdivision and/or deed of record, that the improvements were located by accepted field practices and include permanent visible structures and apparent encroachments, if any. This Plat is not for determining property lines or for construction of improvements, but prepared for exclusive use of present owners of property and also those who purchase, mortgage, or guarantee the title thereto, within six months from date hereof, and as to them I warrant the accuracy of this Plat.

Michael J. Bazis
Michael J. Bazis RPLS #10956

THIS SURVEY IS FOR TITLE PURPOSES ONLY

JOB # 99.0632 H	DATE 6-4-99
FIELD D.H.	DRAFT CB
	P.B. P# 4788

R.C. KELLY & ASSOCIATES, INC.
ENGINEERS & SURVEYORS
10111 COLESVILLE ROAD, SUITE 133
SILVER SPRING, MARYLAND 20901
(301) 593-8005
FAX: (301) 681-7216

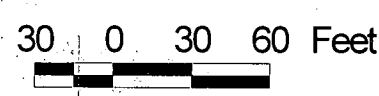

APPLICATION FOR PERMIT FOR BARN
APPLICANT - Christopher Powers
7398 Hopkins Way