

PUB. SEWER STATUS VERIFIED BY _____

ISSUE DATE: 2/14/1968

APPROVAL DATE: 3/26/1968

PERMIT

INDEXED

ON-SITE SEWAGE DISPOSAL SYSTEM HOWARD COUNTY HEALTH DEPARTMENT BUREAU OF ENVIRONMENTAL HEALTH

P _____

A 26373-A

_____ IS PERMITTED TO INSTALL ALTER

ADDRESS: _____ PHONE NUMBER: _____

SUBDIVISION: Allenford LOT NUMBER: 6, Block C

ADDRESS: 10213 Green Clover Drive PROPERTY OWNER: ~~Angel~~ BRADLEY

SEPTIC TANK CAPACITY (GALLONS): _____

PUMP CHAMBER CAPACITY (GALLONS): _____

NUMBER OF BEDROOMS: _____

SQUARE FEET PER BEDROOM: _____

LINEAR FEET OF TRENCH REQUIRED: _____

TRENCHES:	Trench to be _____ feet wide. Inlet _____ feet below original grade. Bottom maximum depth _____ feet below original grade. Effective area begins at _____ feet below original grade. _____ feet of stone below distribution pipe.
LOCATION:	Dry Well
PURPOSE:	

PLANS APPROVED: _____ DATE: 2/14/1968

- NOTE: PERMIT VOID AFTER 2 YEARS
- NOTE: CONTRACTOR RESPONSIBLE FOR SCHEDULING A PRE-CONSTRUCTION INSPECTION FOR ALL INSTALLATIONS
- NOTE: WATERTIGHT SEPTIC TANKS REQUIRED
- NOTE: ALL PARTS OF SEPTIC SYSTEM SHALL BE 100 FEET FROM ANY WATER WELL
- NOTE: MANHOLE RISERS REQUIRED ON ALL SEPTIC TANKS AND PUMP CHAMBERS

NEITHER THE HOWARD COUNTY COUNCIL NOR THE HEALTH DEPARTMENT IS RESPONSIBLE FOR THE SUCCESSFUL OPERATION OF ANY SYSTEM PERMITTEE RESPONSIBLE FOR OBTAINING FINAL APPROVAL ON THIS PERMIT CALL 410-313-2640 FOR INSPECTION OF SEPTIC SYSTEM

AP 26373-A

3/26/68
Ready

770 5-26-67

PERMIT

P 13283
12281
A 12284

SEWAGE DISPOSAL SYSTEM

MARYLAND STATE DEPARTMENT OF HEALTH

HOWARD COUNTY

INDEXED

ELLICOTT CITY

DISTRICT 2

DATE 2/15/68

EMERSON TRASH IS PERMITTED TO INSTALL ALTER

ADDRESS Triadelphia Rd., Ellicott City, Md. PHONE AT - 6-2316

A SEWAGE DISPOSAL SYSTEM LOCATED AT _____

SUBDIVISION Allenford ROAD 10213 Green Clover Drive LOT 6, Blk. 8, Sec. 1

PROPERTY OWNER Douglas Lichter

ADDRESS _____

SPECIFICATIONS - 3 bedrooms

DRAIN FIELD _____ DEPTH _____ FEET, BOTTOM AREA _____ SQ. FT.

SEEPAGE PITS _____ ABSORBENT SIDE-WALL AREA _____ SQ. FT.

SEPTIC TANK CAPACITY 750 GALLONS

FOR GARBAGE GRINDER, INCREASE DISPOSAL AREA 22% & TANK CAPACITY 50%.

OTHER Dry well - 100 sq. ft. absorbent sidewall area below inlet pipe.

Inlet pipe 4 ft. below original grade. Max. depth permitted for dry well 12 ft.

below original grade. Place dry well 80 ft. from front lot line and 45 ft. from

left side line as seen when facing lot from Green Clover Dr.

PERMIT VOID AFTER THREE YEARS.

PLANS APPROVED BY D. W. Monaghan DATE 4/25/67

FILL SEPTIC TANK AND DISTRIBUTION BOX WITH WATER BEFORE CALLING FOR AN INSPECTION. COVER NO WORK UNTIL INSPECTED AND APPROVED.

NEITHER THE HOWARD COUNTY COMMISSIONERS NOR THE HEALTH DEPARTMENT IS RESPONSIBLE FOR THE SUCCESSFUL OPERATION OF ANY SYSTEM.

NOTIFY THE HEALTH DEPARTMENT 48 HOURS BEFORE EXCAVATIONS ARE TO BE BACK FILLED.

12281

A 216393-A

INDEXED

ELLICOTT CITY

DISTRICT 2

DATE 2/15/68

Emerson Pease
IS PERMITTED TO INSTALL ALTER

ADDRESS Triadelphia Md., Ellicott City, Md. PHONE AT - 6-2516

A SEWAGE DISPOSAL SYSTEM LOCATED AT _____

SUBDIVISION Allenford ROAD Green Clover Drive LOT 6, Blk. C, Sec. 1

PROPERTY OWNER Douglas Lichter

ADDRESS _____

SPECIFICATIONS - 3 bedrooms

DRAIN FIELD _____ DEPTH _____ FEET, BOTTOM AREA _____ SQ. FT.

SEEPAGE PITS _____ ABSORBENT SIDE-WALL AREA _____ SQ. FT.

SEPTIC TANK CAPACITY 750 GALLONS

FOR GARBAGE GRINDER, INCREASE DISPOSAL AREA 22% & TANK CAPACITY 50%.

OTHER Dry well - 100 sq. ft. absorbent sidewall area below inlet pipe.

Inlet pipe 4 ft. below original grade. Max. depth permitted for dry well 12 ft. below original grade. Place dry well 80 ft. from front lot line and 45 ft. from left side line as seen when facing lot from Green Clover Dr.

PERMIT VOID AFTER THREE YEARS.

PLANS APPROVED BY D. W. Monaghan DATE 4/25/67

FILL SEPTIC TANK AND DISTRIBUTION BOX WITH WATER BEFORE CALLING FOR AN INSPECTION. COVER NO WORK UNTIL INSPECTED AND APPROVED.

NEITHER THE HOWARD COUNTY COMMISSIONERS NOR THE HEALTH DEPARTMENT IS RESPONSIBLE FOR THE SUCCESSFUL OPERATION OF ANY SYSTEM.

NOTIFY THE HEALTH DEPARTMENT 48 HOURS BEFORE EXCAVATIONS ARE TO BE BACK FILLED.

Handwritten signature/initials

W-62
4-66

State Office Building
ANNAPOLIS, MARYLAND 21401

STATE OF MARYLAND

DEPARTMENT OF
WATER RESOURCES

10:4

THIS REPORT
MUST BE SUBMITTED
WITHIN 30 DAYS
AFTER COMPLETION
OF THE WELL

WELL COMPLETION REPORT

A 12281

WELL DESCRIPTION

DATE: 6C

WELL LOG

State the kind of formations penetrated, their color, their depth, their thickness, and if water-bearing

CASING AND SCREEN RECORD

State the kind and size and position of casing, liner, shoe, screen, and other accessories (if no casing used, give diameter of well).

DIRT
CLAY Red
Sand Stone
White & Green

FEET
from L to
20-35
35-60

6 1/4 PIPE

DIAM.
(inches)

FEET
from m
1-42

PUMPING TEST

Hours Pumped 1
Type of Pump Used Blower
Pumping Rate
Gallons per Minute 3

WATER LEVEL

Distance from land surface to water)
Before Pumping 40 Ft.
When Pumping 50 Ft.

APPEARANCE OF WATER

Clear Cloudy
Taste None
Odor None

Height of Casing Above Land


Surface 1 Ft.

PUMP INSTALLED

Type
Capacity
Gallons per Minute
Gallons per Hour
Pump Column Length

LOCATION OF WELL ON LOT

Show permanent structures such as building(s), septic tank, and/or other landmarks and indicate not less than 2 distances (measurements) to well.

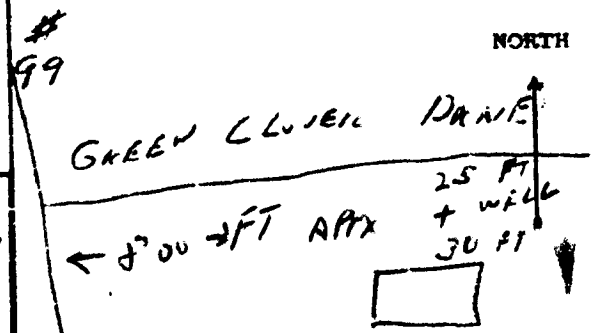

DATE
WELL WAS
COMPLETED

2/15/68

I hereby affirm that this report contains no willful misrepresentations or falsifications and that information given in this report is true, accurate and complete to the best of my knowledge and belief.

Henry J. Mathis, Well Driller

Well Driller License No.: 96

