

9/22/70
Ready

9/22/50 approved J. D. W. ED W. W.

PERMIT

P 15508
A 13406

SEWAGE DISPOSAL SYSTEM

MARYLAND STATE DEPARTMENT OF HEALTH

HOWARD COUNTY

INDEXED

ELLCOTT CITY,
DISTRICT 4

DATE 9/8/70

Howard Pickett IS PERMITTED TO INSTALL _____ ALTER

ADDRESS Watersville Road, Mt. Airy, Md. PHONE 829-0543

A SEWAGE DISPOSAL SYSTEM LOCATED AT _____

SUBDIVISION _____ ROAD Ed Warfield (see application for better directions) LOT _____

PROPERTY OWNER Wilton M. Kiefer

ADDRESS _____

SPECIFICATIONS - 3 bedrooms or
4 bedrooms

DRAIN FIELD _____ DEPTH _____ FEET, BOTTOM AREA _____ SQ. FT.

SEEPAGE PITS _____ ABSORBENT SIDE WALL AREA _____ SQ. FT.

SEPTIC TANK CAPACITY 750 GALLONS for 3 bedrooms
1,000 " 4 "

FOR GARBAGE GRINDER, INCREASE DISPOSAL AREA 22% & TANK CAPACITY 50%
3 bedroom

OTHER Dry well - dig pit 16 ft. sq. - set block and top for 12 ft. diameter

and fill rest of pit with gravel. Dry well to be 7 ft. deep below inlet pipe. Inlet
4 bdrms.

pipe to be 3 ft. below original grade. Dry well - same as for 3 bedrooms but 9 1/2 ft.

deep below inlet pipe. Place dry well about 69 ft. from rear lot line and about 39 ft.

from right side line as seen when facing from Ed Warfield Rd. * Due to amount of rocky ground
all pipe must be cast iron.


PLANS APPROVED BY D. W. Monaghan DATE 2/20/68

FILL SEPTIC TANK AND DISTRIBUTION BOX WITH WATER BEFORE CALLING FOR AN INSPECTION. COVER NO WORK
UNTIL INSPECTED AND APPROVED.

NEITHER THE HOWARD COUNTY COMMISSIONERS NOR THE HEALTH DEPARTMENT IS RESPONSIBLE FOR THE
SUCCESSFUL OPERATION OF ANY SYSTEM.

A 13406

16
66
8
480

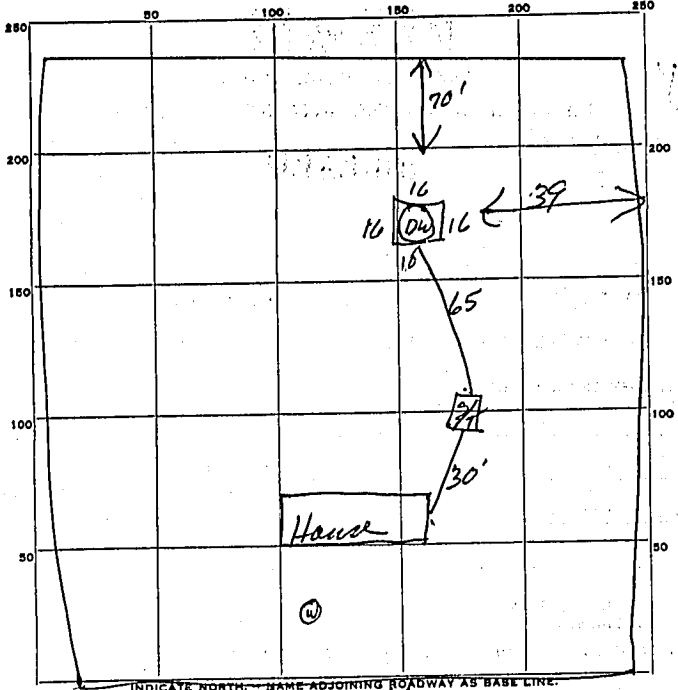

INDICATE NORTH - NAME ADJOINING ROADWAY AS BASE LINE.

CD Warfield

PERMIT CARD OK

SEPTIC TANK, LEVEL Concrete 1000 CLEANOUTS OK

DISTRIBUTION BOX, LEVEL _____

TILE FIELD, DEPTH _____ FT. TRENCH WIDTH _____ FT.

GRAVEL DEPTH _____ IN. TOTAL LENGTH _____ FT.

NUMBER OF TRENCHES _____ TOTAL BOTTOM AREA 8

SEEPAGE PITS: INSIDE DIAMETER 12 FT. DEPTH BELOW INLET 8 FT.

ABSORBENT AREA 480 SQ. FT.

REMARKS _____

DATE SYSTEM APPROVED 9/22/70 INSPECTOR JTA

