

10/27/70
9:30
Recorded

APPLICATION

Jones
A 15591
P _____

SEWAGE DISPOSAL TESTING

MARYLAND STATE DEPARTMENT OF HEALTH

HOWARD COUNTY

ELLICOTT CITY

Septic Tank 1200 gal.

DISTRICT 4

Dry Well 350 sq. ft. absorbent side wall cased to begin below the first 4 ft. of non absorbent ground Max depth permitted for Dry Well is 11 ft. below original grade.

DATE 10/19/70

Place Dry Well about 260 ft from front lot line and about 100 ft from left side line as seen below facing lot from Warfield Rd

TO: THE COUNTY HEALTH OFFICER
ELLICOTT CITY, MARYLAND

I, HEREBY, APPLY FOR THE NECESSARY TESTS IN ORDER TO CONSTRUCT (OR RECONSTRUCT) A SEWAGE DISPOSAL SYSTEM.

PROPERTY OWNER Edwin Warfield, III

Samuel C. Jones
10519 The Wood Road Rd.
Aberdeen, Md.
22783
1-434-0625

ADDRESS Oakdale, Woodbine, Maryland

PHONE

PROPERTY LOCATION:

SUBDIVISION _____ LOT NO. 2

ROAD AND DESCRIPTION Ed Warfield Road - approx. 4/10 mile from intersecion with Jennings Chapel Rd.

OCCUPANT _____ PHONE _____

PERSON TO CONSTRUCT SYSTEM _____

ADDRESS _____ PHONE _____

SIZE OF LOT 5.000 acres TYPE BLDG. 34
NUMBER OF BEDROOMS

IF NOT SINGLE RESIDENCE DESCRIBE _____

SIGNATURE OF APPLICANT /s/ Margaret G. Allnutt

APPROVED BY Donald W. Managahan FOR Dry Well DATE 10-27-70
(KIND OF SYSTEM)


REJECTED BY _____ FOR _____ DATE _____
(KIND OF SYSTEM)

HOLD PENDING FURTHER TESTS _____ DATE _____

REASONS FOR REJECTION OR HOLDING _____

Harry Taylor - Pld.
944 0846

THIS IS NOT A PERMIT

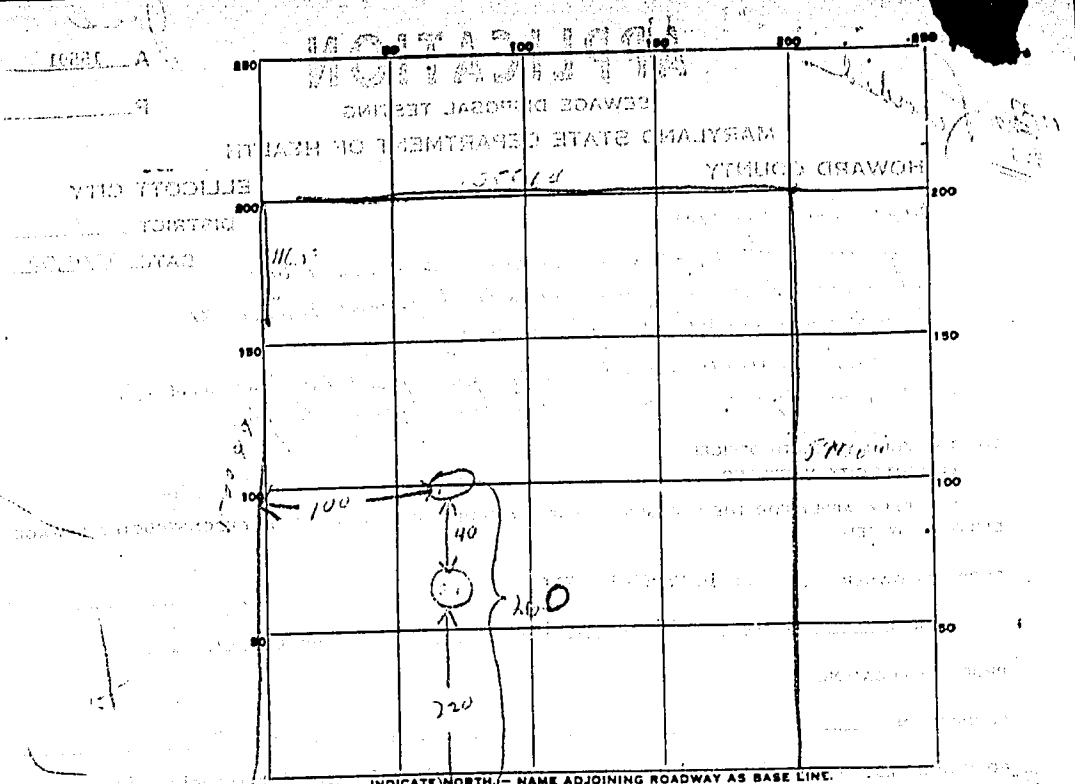

INDICATE NORTH - NAME ADJOINING ROADWAY AS BASE LINE.

DATE	TEST NO.	DEPTH	PRE-WET		TEST - 1" DROP		TIME
			START	STOP	START	STOP	
6/1/70	1	10 ft	11 11	11 13	11 13	11 16	3 min
	2	4 ft	11 18	11 23	11 23	11 25	12 min
	3	10 ft	11 22	11 35	11 35	11 40	5 min
	4	4 ft	11 30	11 35	11 36	11 45	9 min

SOIL AUGER FINDING _____
 TESTED BY SWY
 REMARKS _____

TRANSFER A TOW 21 12/12