

~~8-27-85~~
~~APPROVED~~
8-27-85
9:30 AM
AND LATE AM

W.D.I. - 9/19/85

8-27-85
Approved
S. Aul

PERMIT

SEWAGE DISPOSAL SYSTEM

MARYLAND STATE DEPARTMENT OF HEALTH

P 35729
A 26732
26723

HOWARD COUNTY
BUREAU OF ENVIRONMENTAL HEALTH
992-2330

05-374367

INDEXED

ELLICOTT CITY
DISTRICT 5th
DATE 7/2/85

Paul Schissler IS PERMITTED TO INSTALL ALTER

ADDRESS _____ PHONE 875-4197

SUBDIVISION Glenelg Manor II ROAD 12747 Folly Quarter LOT 9B, Section 2

PROPERTY OWNER Fred Weaver

ADDRESS _____

IF GARBAGE GRINDER IS USED INCREASE SEPTIC TANK CAPACITY BY 50% AND ABSORPTION AREA BY 22%.

GARBAGE GRINDER? YES NO

SEPTIC TANK CAPACITY 1250 GALLONS NUMBER OF BEDROOMS 4

TRENCHES - 180 sq. ft. per bedroom. Trench to be 2 feet wide. Inlet 4 feet below original grade. Bottom maximum depth 9 feet below original grade. Effective area begins at 4 feet below original grade. 5 feet of stone below distribution pipe. LOCATION: Start the first trench 165 feet from the 142.6' lot line and 25 feet from the 388.9' lot line. Run trench(s) along level ground toward the 311' lot line. NOTE: No trench to exceed 100 feet in length. If more than one trench used, a distribution box is required. Call for inspection of trench before and after gravel is installed. Provide 6" - 8" diameter cleanout and cap to grade or above on septic tank.

PLANS APPROVED BY C. Williams DATE 4/23/85

COVER NO WORK UNTIL INSPECTED AND APPROVED.

NEITHER THE HOWARD COUNTY COUNCIL NOR THE HEALTH DEPARTMENT IS RESPONSIBLE FOR THE SUCCESSFUL OPERATION OF ANY SYSTEM.

NOTE: IF TRENCH IS USED CALL FOR INSPECTION BEFORE AND AFTER PLACING GRAVEL IN TRENCH.

NOTE: NO DRY WELL SHALL EXCEED 15 FOOT IN DIAMETER. NO ABSORPTION TRENCH TO EXCEED 100 FEET IN LENGTH.

NOTE: ALL PIPE FROM HOUSE TO SEPTIC TANK MUST BE CAST IRON OR SCHEDULE 40 PVC OR ABS.

PERMIT VOID AFTER THREE YEARS.


NOTE: INSTALL STAND PIPE ON SEPTIC TANK AND DRY WELL. STAND PIPES MUST BE 6 INCHES IN DIAMETER CAST IRON, CONCRETE OR TERRA COTTA, OR PVC OR ABS ACCEPTED. IF TOP OF SEPTIC TANK IS DEEPER THAN 3 FEET MANHOLE TO GRADE REQUIRED.

***INSTALLER IS RESPONSIBLE FOR OBTAINING FINAL APPROVAL ON THIS PERMIT**

*CALL 992-2330 FOR INSPECTION OF SEPTIC SYSTEMS.

EH - 2-1082

A 26723

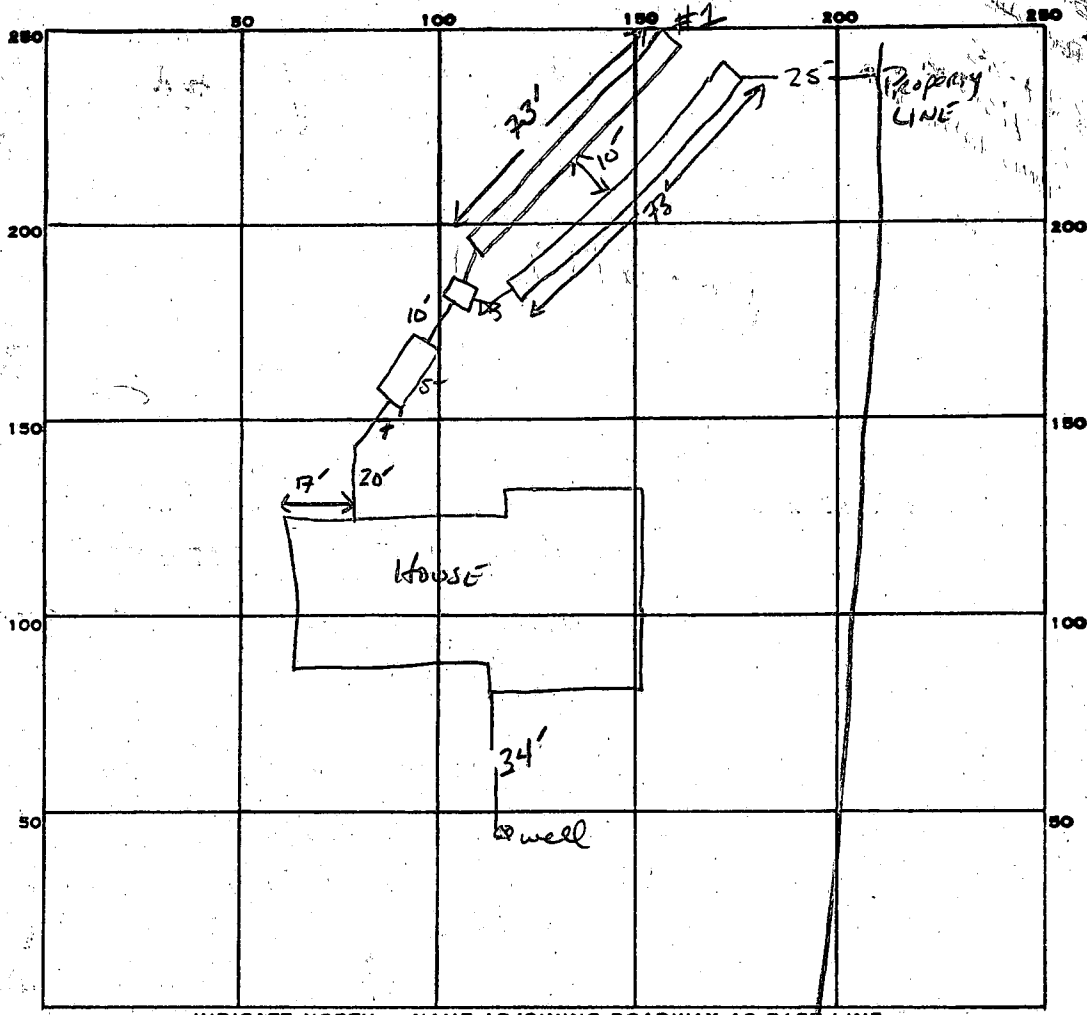

INDICATE NORTH. - NAME ADJOINING ROADWAY AS BASE LINE.

180
720
144 FE TRENCH
5720
5/12/85

PERMIT CARD

SEPTIC TANK, LEVEL 1500 GAL

CLEANOUTS ST

DISTRIBUTION BOX, LEVEL

TILE FIELD, DEPTH 9' 9' FT. TRENCH WIDTH 2 FT. INLET 4"

GRAVEL DEPTH 5' 5' IN TOTAL LENGTH 73' 73' FT. TOTAL 146 730

NUMBER OF TRENCHES 2 ONE SIDE WALL TOTAL BOTTOM AREA 730

SEEPAGE PITS, INSIDE DIAMETER _____ FT. DEPTH BELOW INLET _____ FT.

ABSORBENT AREA 730 SQ. FT.

REMARKS 8-26-85 OK TO ADD STONE TO TRENCH #1 ; OK TO COVER TRENCH #1 ; Dig #2 AND CALL FOR INSPECTION, S. Abel

DATE SYSTEM APPROVED 8-27-85 INSPECTOR S. Abel

APPLICATION

A 26723

P _____

SEWAGE DISPOSAL TESTING

STATE OF MARYLAND - DEPARTMENT OF HEALTH AND MENTAL HYGIENE

HOWARD COUNTY HEALTH DEPARTMENT
ENVIRONMENTAL HEALTH SERVICES
P. O. BOX 476, ELLICOTT CITY, MARYLAND 21043
TELEPHONE: 465-5000, EXT. 356

DISTRICT 5th

DATE 8/17/77

OKAM

TO: THE COUNTY HEALTH OFFICER
ELLICOTT CITY, MARYLAND

I, HEREBY, APPLY FOR THE NECESSARY TEST IN ORDER TO CONSTRUCT (OR RECONSTRUCT) A SEWAGE DISPOSAL SYSTEM.

PROPERTY OWNER Howard Associates Fred Weaver

10370 K

ADDRESS _____ PHONE Rhett Realty 465-4920

PROPERTY LOCATION:

SUBDIVISION Glenelg Manor - Section 2 LOT NO. 9B - Section 2

12747

ROAD AND DESCRIPTION Off Folly Quarter Rd.

SIZE OF LOT 40,000 square feet ± TYPE BLDG. 3 or 4

NUMBER OF BEDROOMS

IF NOT SINGLE RESIDENCE DESCRIBE N/A

THE SYSTEM INSTALLED UNDER THIS APPLICATION IS ACCEPTABLE ONLY UNTIL PUBLIC FACILITIES BECOME AVAILABLE.

SIGNATURE OF APPLICANT /s/ Dale Maisel

APPROVED BY [Signature] FOR DITCH DATE 2/15/83

(KIND OF SYSTEM)

REJECTED BY _____ FOR _____ DATE _____

(KIND OF SYSTEM)


HOLD PENDING FURTHER TESTS _____ DATE _____

REASONS FOR REJECTION OR HOLDING _____

BLDG. PERMIT SIGNED AND RETURNED [Signature]

Serial # 65233
SFD

THIS IS NOT A PERMIT

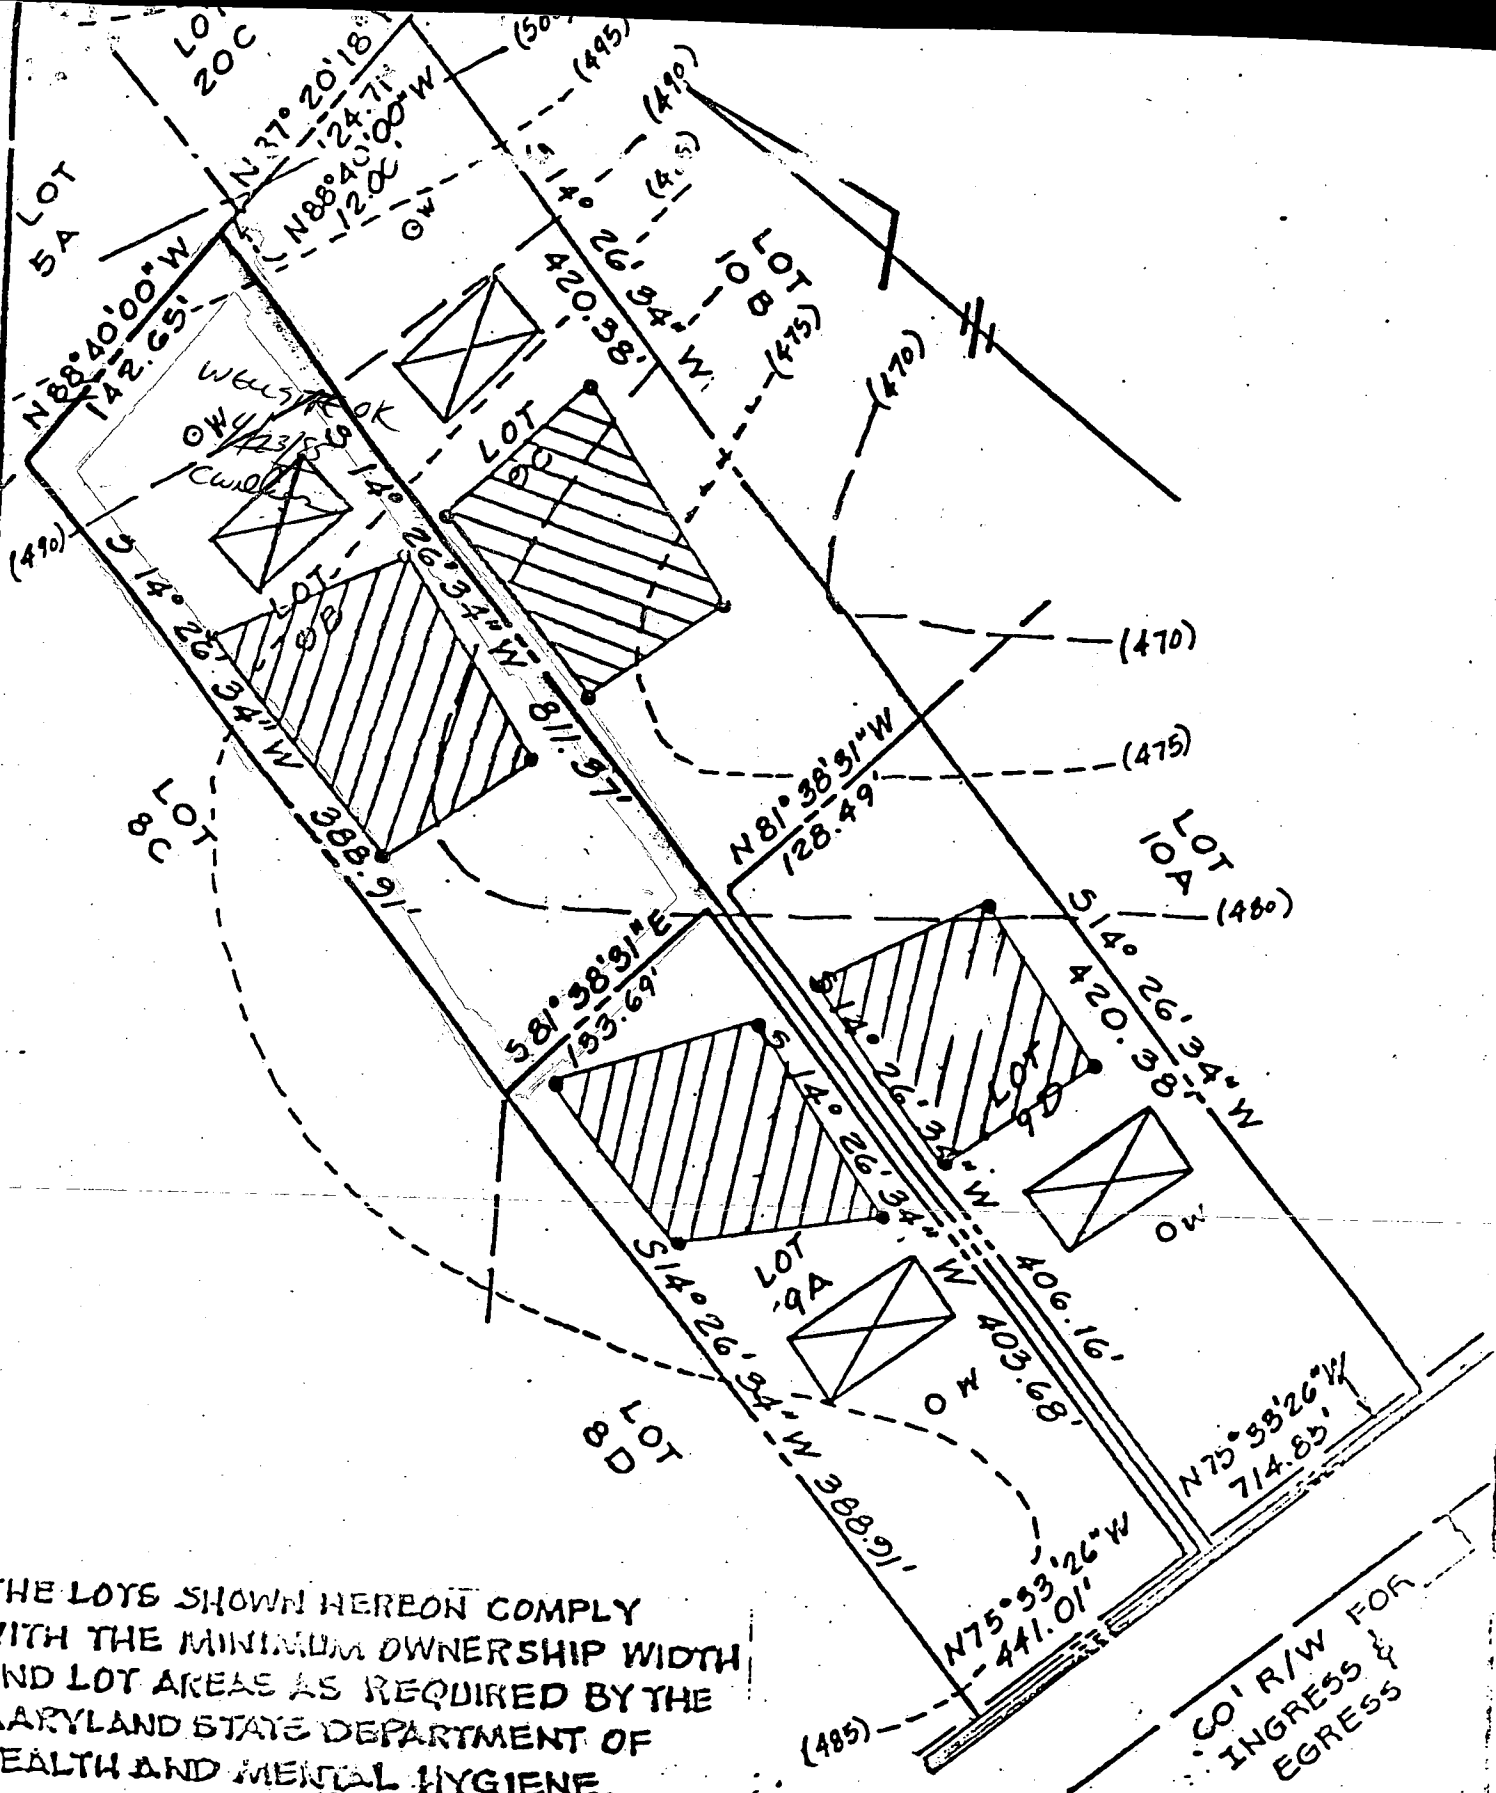

THE LOTS SHOWN HEREON COMPLY WITH THE MINIMUM OWNERSHIP WIDTH AND LOT AREAS AS REQUIRED BY THE MARYLAND STATE DEPARTMENT OF HEALTH AND MENTAL HYGIENE.

NOTE: PERCOLATION TEST HOLES SHOWN HEREON HAVE BEEN FIELD LOCATED.

APPROVED: FOR PRIVATE WATER AND PRIVATE SEWAGE SYSTEMS.
 HOWARD COUNTY HEALTH DEPARTMENT
Joyce Brydies 6-5-78
 COUNTY HEALTH OFFICER - DATE

C1 2267 SEQUENCE NO. (OEP USE ONLY)

STATE OF MARYLAND WELL COMPLETION REPORT

THIS REPORT MUST BE SUBMITTED WITHIN 45 DAYS AFTER WELL IS COMPLETED.

(THIS NUMBER IS TO BE PUNCHED IN COLS. 3-6 ON ALL CARDS)

COUNTY NUMBER A26723

DATE RECEIVED, DATE WELL COMPLETED, DEPTH OF WELL, PERMIT NO.

OWNER WEAVER FRED, STREET OR RFD FOLLY QUARTER RD, TOWN GLENELG, SUBDIVISION GLENELG MANOR II, SECTION, LOT 9B

WELL LOG table with columns: DESCRIPTION, FEET (FROM, TO), Check if water bearing. Includes entries for Top Soil, Sandy, Sand Stone, Mick A, etc.

GROUTING RECORD: WELL HAS BEEN GROUTED (Y), TYPE OF GROUTING MATERIAL: CEMENT (CM), BENTONITE CLAY (BC), NO. OF BAGS 13, NO. OF POUNDS 1300.

CASING RECORD: casing types (ST, CO, PL, OT), MAIN CASING TYPE (PL), Nominal diameter 60, Total depth 70.

OTHER CASING (if used) diameter, depth (feet) from to.

SCREEN RECORD: screen type or open hole (HO), insert appropriate code below.

DEPTH (nearest ft.) table with columns for depth intervals and slot size, diameter of screen.

CIRCLE APPROPRIATE LETTER: A WELL WAS ABANDONED AND SEALED WHEN THIS WELL WAS COMPLETED.

I HEREBY CERTIFY THAT THIS WELL HAS BEEN CONSTRUCTED IN ACCORDANCE WITH COMAR 10.17.13 "WELL CONSTRUCTION"


DRILLERS IDENT. NO. 273, DRILLERS SIGNATURE Ralph E. Maguire, SITE SUPERVISOR (sign. of driller or journeyman responsible for sitework if different from permittee)

GRAVEL PACK: IF WELL DRILLED WAS FLOWING WELL INSERT F IN BOX 68

OEP USE ONLY (NOT TO BE FILLED IN BY DRILLER): T, LOG INDICATOR, WQ, OTHER DATA


PUMPING TEST: HOURS PUMPED, PUMPING RATE, METHOD USED TO MEASURE PUMPING RATE (Bucket), WATER LEVEL, BEFORE PUMPING, WHEN PUMPING, TYPE OF PUMP USED (S submersible)

PUMP INSTALLED: DRILLER WILL INSTALL PUMP YES (NO), TYPE OF PUMP INSTALLED, CAPACITY: GALLONS PER MINUTE, PUMP HORSE POWER, PUMP COLUMN LENGTH, CASING HEIGHT (above/below LAND SURFACE)

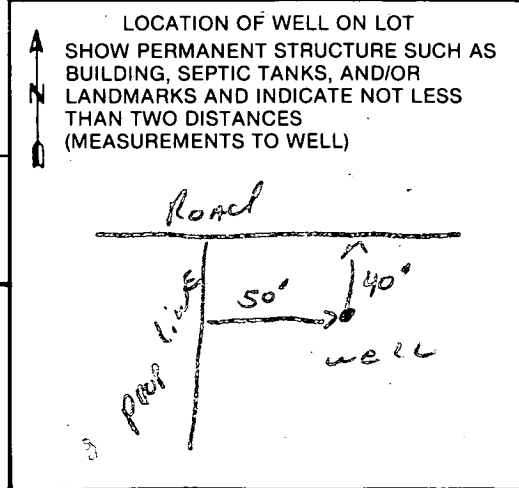

B.P.#
65233


6/19/85
Sheet of F.S.

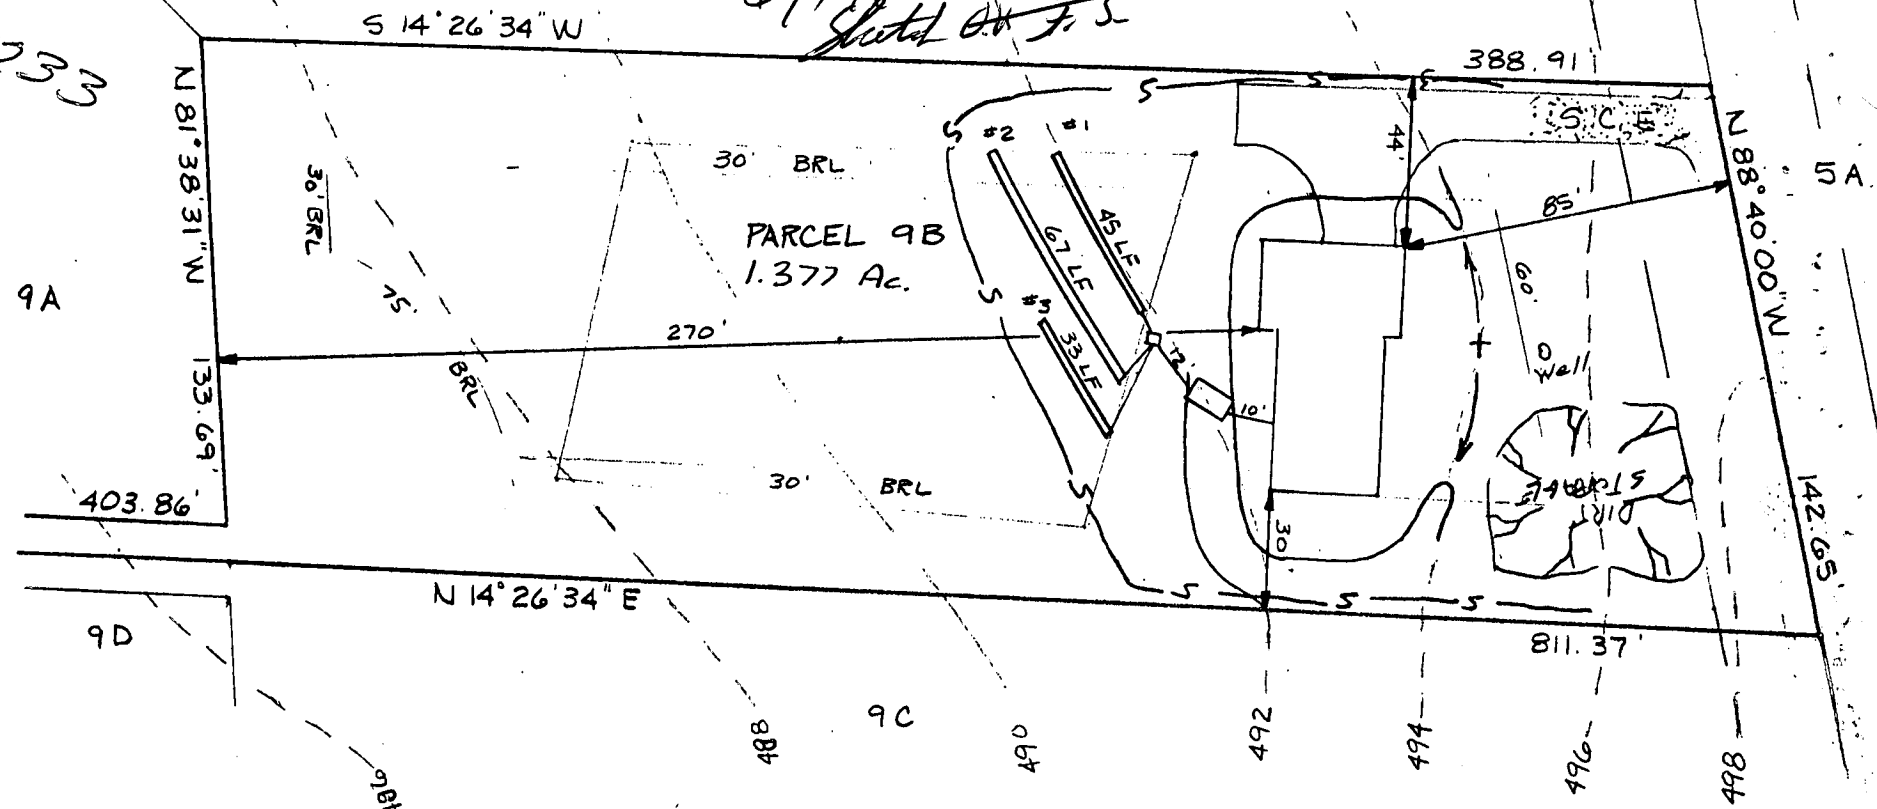

<u>HOUSE:</u>	
FIRST FLOOR	496.0
BASEMENT	487.0
INVERT	488.79
<u>SEPTIC TANK:</u>	
EXISTING GRADE	492.0
PROPOSED GRADE	493.0
INVERT IN	488.58
INVERT OUT	488.33
<u>DISTRIBUTION BOX:</u>	
EXISTING GRADE	492.0
INVERT IN	488.2
INVERT OUT	488.1

<u>TRENCH:</u>	# 1	# 2	# 3
EXISTING GRADE	492.0	491.8	491.5
INVERT	488.0	487.8	487.5
BOTTOM	483.0	482.8	482.5
STONE	5'	5'	5'
WIDTH	2'	2'	2'
LENTH	45'	67'	33'

I certify the above measurements
and elevations to be actual and true
for this property.

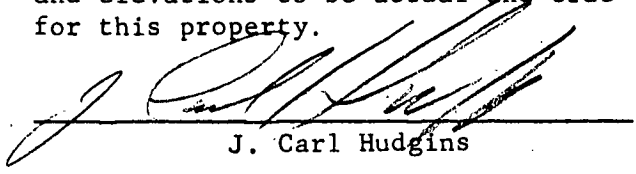
J. Carl Hudgins

PLOT PLAN
PARCEL 9B
TAX MAP 22 PARCEL 446
GLENELG MANOR II
5TH ELECTION DISTRICT
HOWARD COUNTY, MD.
SCALE 1"=50' DATE 5/24/85
DRAWN BY: RIK