

6/27/77
10:00am 7/13/77
6/27/77
7/14/77 app'd F.S.

PERMIT

P 26059

SEWAGE DISPOSAL SYSTEM

A _____

MARYLAND STATE DEPARTMENT OF HEALTH

HOWARD COUNTY

01-166107

ELLICOTT CITY

DISTRICT _____

INDEXED

DATE 6/9/77

William Ballantine

IS PERMITTED TO INSTALL _____ ALTER X

ADDRESS Dorsey Road, Baltimore, Md. PHONE _____

A SEWAGE DISPOSAL SYSTEM LOCATED AT _____

SUBDIVISION _____ ROAD 5966 Augustine Avenue LOT _____

PROPERTY OWNER Howard T. Fultz, Sr.

ADDRESS 7696 Dorsey Road, Balto., M.d. 21227

SPECIFICATIONS 3 bedrooms

DRAIN FIELD _____ DEPTH _____ FEET, BOTTOM AREA _____ SQ. FT.

SEEPAGE PITS _____ ABSORBENT SIDE-WALL AREA _____ SQ. FT.

SEPTIC TANK CAPACITY 1000 GALLONS

FOR GARBAGE GRINDER, INCREASE DISPOSAL AREA 22% & TANK CAPACITY 50%.

OTHER REPAIR-CALL FOR INSPECTION WHEN GROUND IS OPENED UP SO SANITARIAN CAN

RECOMMEND REPAIR.


2 trenches ~ 40' long approx 12" to 13" dia inlet
at 4' below grade ~ 2-2 1/2' gravel below dist. pipe

PLANS APPROVED BY Palmer F. Wine DATE 6/9/77

FILL SEPTIC TANK AND DISTRIBUTION BOX WITH WATER BEFORE CALLING FOR AN INSPECTION. COVER NO WORK UNTIL INSPECTED AND APPROVED.

NEITHER THE HOWARD COUNTY COMMISSIONERS NOR THE HEALTH DEPARTMENT IS RESPONSIBLE FOR THE SUCCESSFUL OPERATION OF ANY SYSTEM.

P 26059

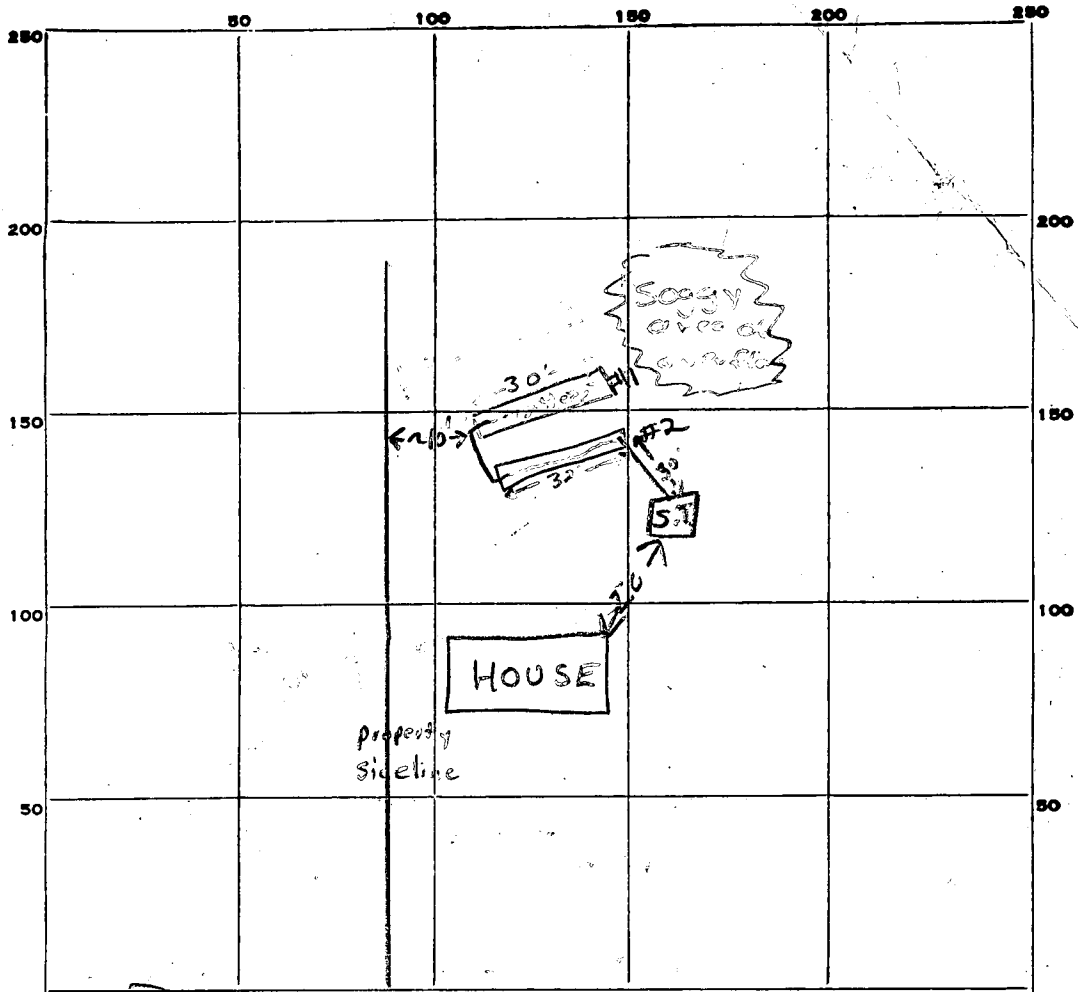

INDICATE NORTH. NAME ADJOINING ROADWAY AS BASE LINE.
 Dead End Augustine Ave

PERMIT CARD no verbal approval given

SEPTIC TANK, LEVEL ✓

S.T. | trenches
 CLEANOUTS top tank & cleanout n/a.

DISTRIBUTION BOX, LEVEL n.a.

TILE FIELD, DEPTH 12 FT. TRENCH WIDTH 2 FT.

GRAVEL DEPTH 2 IN. TOTAL LENGTH 62 FT.

NUMBER OF TRENCHES 2 1/2 SIDEWALL TOTAL BOTTOM AREA 496 #

SEEPAGE PITS, INSIDE DIAMETER — FT. DEPTH BELOW INLET ~8-9 FT.

ABSORBENT AREA ±496 SQ. FT.

REMARKS 6/21/77 - A ditch 20 ft long 12 ft deep filled with 8 ft rock dug & backhoed out stuck & part of ditch covered in. Continue work 60 ft of ditch 12 ft deep filled with 8 ft rock still needed R/T 7/13/77 Trench #2 dug & filled to gravel - out inspection of open hole; cover all pipe to gravel & pipe; before backfilling call for final inspection F.S.

DATE SYSTEM APPROVED 7/14/77

INSPECTOR F. Skinner

REGION _____

AREA _____ RATING _____

ACKNOWLEDGMENT AND CONTROLS	DATE

Howard County Department of Health
BUREAU OF ENVIRONMENTAL HEALTH

DISPOSITION	DATE

RECORD OF INVESTIGATION

LOCATION 5966 or 5972 Augustine Ave ZIP _____

OWNER OCCUPANT Fultz ADDRESS _____ PHONE _____

COMPLAINANT Mr/Mrs. Bennett ADDRESS 5958 Augustine Ave PHONE 410-796-4481

(FWD FROM Don So @ UTILITIES)
REASON FOR INVESTIGATION Strong sewage odor coming from direction of properties 5966 or 5972, observed mostly in evenings; utilities staff reports that odor not confirmed CODES _____

RECEIVED BY M.R. DATE 7/16/99 ASSIGNED TO M.R. DATE 7/16

DATE OF INVESTIGATION 7/20/99 TIME 2:15 WEATHER warm, muggy

REPORT 7/20/99 MET COMPLAINANT @ SITE; NO ODORS OBS'D; NO ONE HOME @ SUSPECT PROPERTIES; NO DISCHARGES OBS'D (MR)

8/3/99 NO DISCHARGE OR ODOR OBS'D IN REAR YARD OR WOODS @ FAR REAR (AS SUGGESTED BY NEIGHBOR); RE-INSP NEC DURING A.M. (MR)

DATE SUBMITTED _____ SANITARIAN _____

REGION _____

AREA _____ RATING _____

ACKNOWLEDGMENT AND CONTROLS	DATE

Howard County Department of Health
BUREAU OF ENVIRONMENTAL HEALTH

01-116127
RECORD OF INVESTIGATION

DISPOSITION	DATE

LOCATION 5966 or 5972 Augustine Ave ZIP _____

OWNER OCCUPANT Fultz ADDRESS _____ PHONE _____

COMPLAINANT Mr/Mrs. Bennett ADDRESS 5958 Augustine Ave PHONE 410-796-4481

(FWD FROM Don So @ UTILITIES)
REASON FOR INVESTIGATION Strong sewage odor coming from direction of properties 5966 or 5972, observed mostly in evenings; utilities staff reports that odor not confirmed CODES _____

RECEIVED BY M.R. DATE 7/16/99 ASSIGNED TO M.R. DATE 7/16

DATE OF INVESTIGATION 7/20/99 TIME 2:15 WEATHER warm, muggy

REPORT 7/20/99 MET COMPLAINANT @ SITE; NO ODORS OBS'D; NO ONE HOME @ SUSPECT PROPERTIES; NO DISCHARGES OBS'D (M.R.)

8/3/99 NO DISCHARGE OR ODOR OBS'D IN REAR YARD OR WOODS @ FAR REAR (AS SUGGESTED BY NEIGHBOR); RE-INSP NEC DURING A.M. (M.R.)

P. b. 11/5

Pub. w/s

DATE SUBMITTED _____ SANITARIAN _____