

6/27/77  
ground will be opened  
after lunch

Recall  
7/27/77  
R.H.  
VED  
P 26066  
A \_\_\_\_\_

# PERMIT

SEWAGE DISPOSAL SYSTEM

MARYLAND STATE DEPARTMENT OF HEALTH

HOWARD COUNTY

01-167677

ELLICOTT CITY

DISTRICT 6th

**INDEXED**

DATE 6/9/77

George B. Haker

IS PERMITTED TO INSTALL \_\_\_\_\_ ALTER

ADDRESS 6091 Old Montgomery Road, Ellicott City, Md.

PHONE 796-4380

A SEWAGE DISPOSAL SYSTEM LOCATED AT \_\_\_\_\_

SUBDIVISION \_\_\_\_\_

ROAD 8091 Old Montgomery Rd.

LOT \_\_\_\_\_

PROPERTY OWNER George B. Haker

(PERC TEST APPLICATION  
UNDER NAME OF G. HAKER)

ADDRESS same as above

SPECIFICATIONS 3 bedrooms

DRAIN FIELD \_\_\_\_\_ DEPTH \_\_\_\_\_ FEET, BOTTOM AREA \_\_\_\_\_ SQ. FT.

SEEPAGE PITS \_\_\_\_\_ ABSORBENT SIDE-WALL AREA \_\_\_\_\_ SQ. FT.

SEPTIC TANK CAPACITY 1000 GALLONS

FOR GARBAGE GRINDER, INCREASE DISPOSAL AREA 22% & TANK CAPACITY 50%.

OTHER REPAIR-CALL FOR INSPECTION WHEN GROUND IS OPENED UP SO SANITARIAN CAN

RECOMMEND THE REPAIR.


PLANS APPROVED BY Palmer F. Wine

DATE 6/9/77

FILL SEPTIC TANK AND DISTRIBUTION BOX WITH WATER BEFORE CALLING FOR AN INSPECTION. COVER NO WORK UNTIL INSPECTED AND APPROVED.

NEITHER THE HOWARD COUNTY COMMISSIONERS NOR THE HEALTH DEPARTMENT IS RESPONSIBLE FOR THE SUCCESSFUL OPERATION OF ANY SYSTEM.

26066

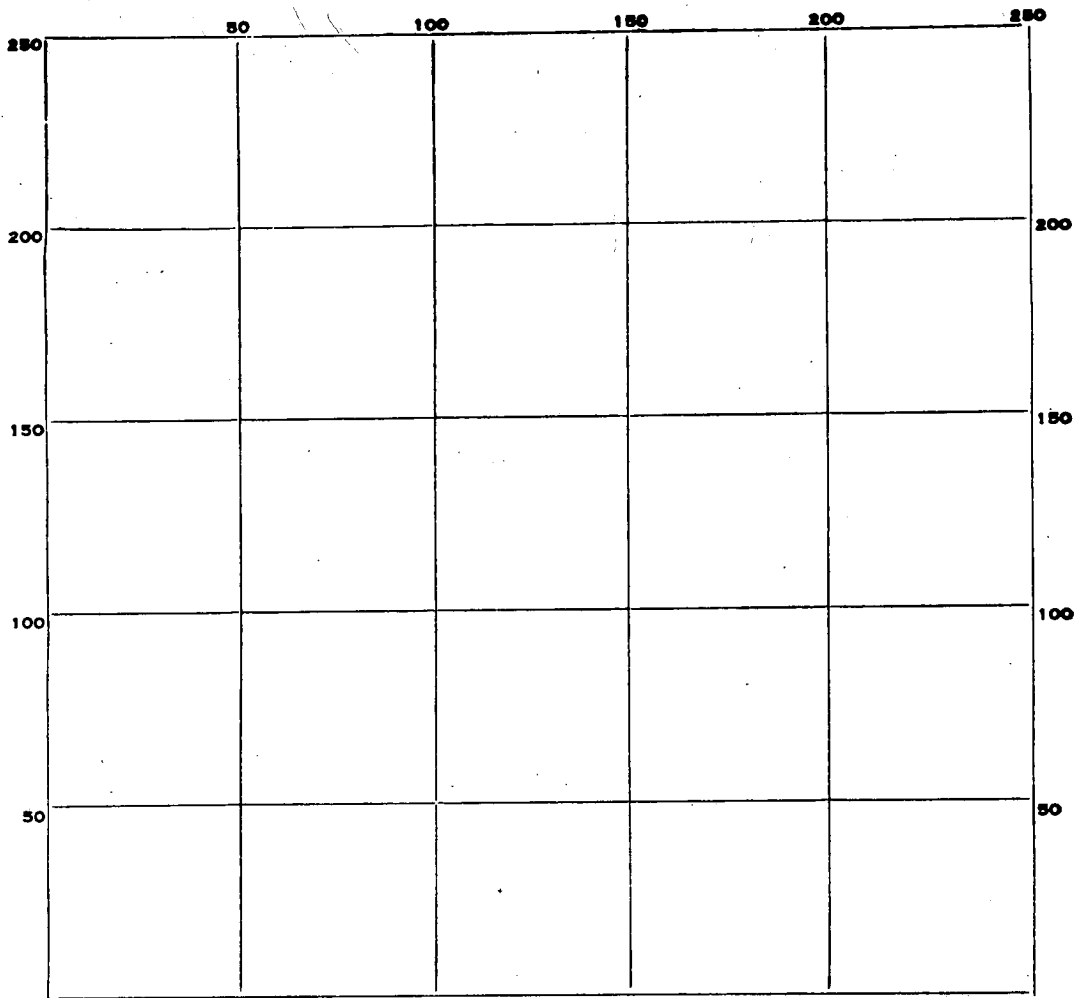

INDICATE NORTH. - NAME ADJOINING ROADWAY AS BASE LINE.

PERMIT CARD \_\_\_\_\_

SEPTIC TANK, LEVEL \_\_\_\_\_

CLEANOUTS \_\_\_\_\_

DISTRIBUTION BOX, LEVEL \_\_\_\_\_

TILE FIELD, DEPTH \_\_\_\_\_ FT. TRENCH WIDTH \_\_\_\_\_ FT.

GRAVEL DEPTH \_\_\_\_\_ IN. TOTAL LENGTH \_\_\_\_\_ FT.

NUMBER OF TRENCHES \_\_\_\_\_ TOTAL BOTTOM AREA \_\_\_\_\_

SEEPAGE PITS, INSIDE DIAMETER \_\_\_\_\_ FT. DEPTH BELOW INLET \_\_\_\_\_ FT.

ABSORBENT AREA \_\_\_\_\_ SQ. FT.

REMARKS 6/27/77 Dry Well Full Not caved in. Advised  
 Repair JOB. in 1/2 hr. Haker is going to enter Cleanout  
 & put mound over D.W. to see if water level in DW  
 goes down. Inspection of Mound not needed. Recheck in  
 30 days to see if D.W. still Full R/W

1/1/78 System OK today But DW almost  
 full may need work in future

DATE SYSTEM APPROVED \_\_\_\_\_

INSPECTOR \_\_\_\_\_

1/1/78

*[Signature]*