

6/13/77

PERMIT

P 26176

A Repair

SEWAGE DISPOSAL SYSTEM

MARYLAND STATE DEPARTMENT OF HEALTH

HOWARD COUNTY

ELLICOTT CITY

DISTRICT 3rd

INDEXED

DATE 6/23/77

Mario Mannarelli IS PERMITTED TO INSTALL ALTER X

ADDRESS Summit Circle, Ellicott City, Md. PHONE 465-6878

A SEWAGE DISPOSAL SYSTEM LOCATED AT

SUBDIVISION Woodmark ROAD 12249 Pointer Hill Court LOT 19, Blk. B, Sec. 2

PROPERTY OWNER Mr. & Mrs. Charles Lancelotta

ADDRESS 12249 Pointer Hill Court, Ellicott City, Maryland 21043 988-9148

SPECIFICATIONS

DRAIN FIELD DEPTH FEET, BOTTOM AREA SQ. FT.

SEEPAGE PITS ABSORBENT SIDE-WALL AREA SQ. FT.

SEPTIC TANK CAPACITY GALLONS

FOR GARBAGE GRINDER, INCREASE DISPOSAL AREA 22% & TANK CAPACITY 50%.


OTHER REPAIR - Call for inspection when ground is opened up and Sanitarian will recommend repair system.

PLANS APPROVED BY Donald W. Monaghan DATE 6/23/77

FILL SEPTIC TANK AND DISTRIBUTION BOX WITH WATER BEFORE CALLING FOR AN INSPECTION. COVER NO WORK UNTIL INSPECTED AND APPROVED.

NEITHER THE HOWARD COUNTY COMMISSIONERS NOR THE HEALTH DEPARTMENT IS RESPONSIBLE FOR THE SUCCESSFUL OPERATION OF ANY SYSTEM.

P 26176

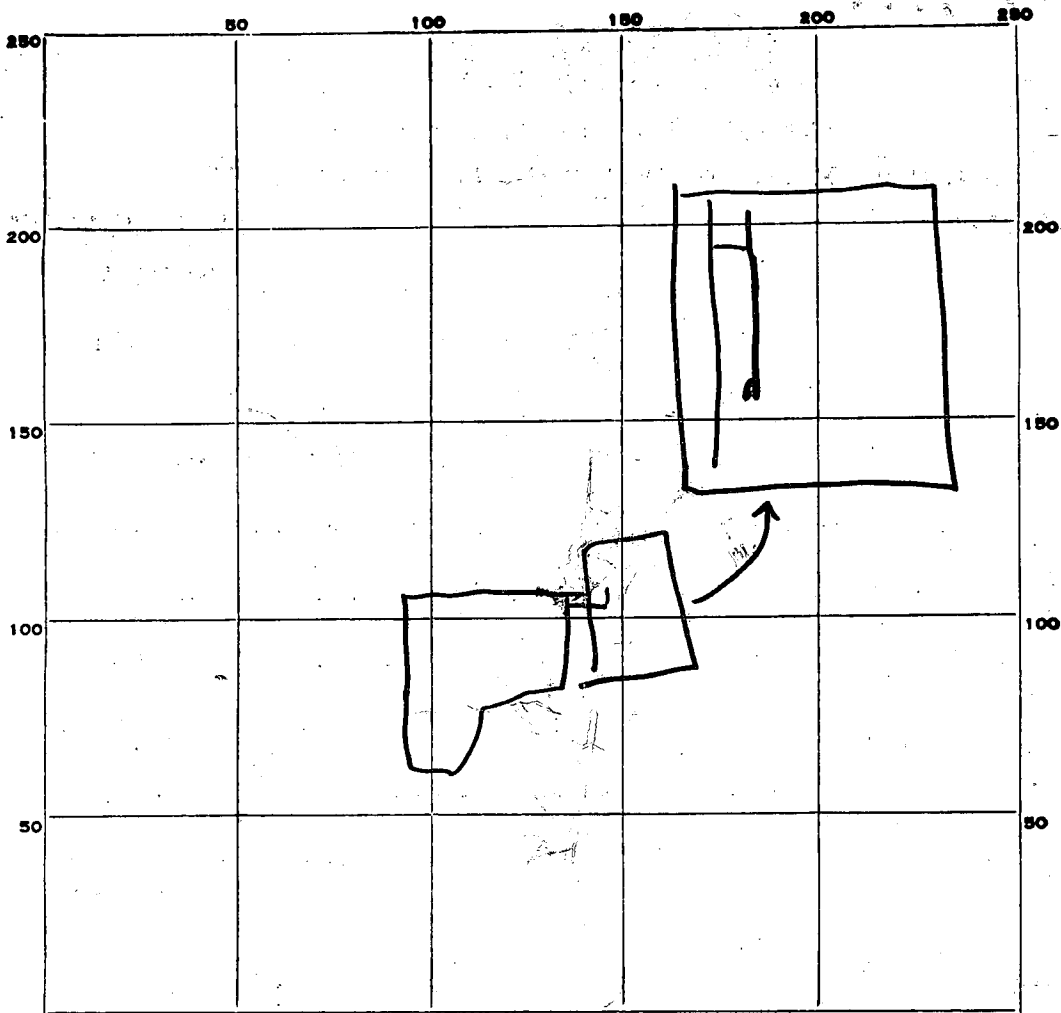

INDICATE NORTH. - NAME ADJOINING ROADWAY AS BASE LINE.

PERMIT CARD _____

SEPTIC TANK, LEVEL _____

CLEANOUTS _____

DISTRIBUTION BOX, LEVEL _____

TILE FIELD, DEPTH _____ FT. TRENCH WIDTH _____ FT.

GRAVEL DEPTH _____ IN. TOTAL LENGTH _____ FT.

NUMBER OF TRENCHES _____ TOTAL BOTTOM AREA _____

SEEPAGE PITS, INSIDE DIAMETER _____ FT. DEPTH BELOW INLET _____ FT.

ABSORBENT AREA _____ SQ. FT.

REMARKS _____

See attached sheet for drawing

DATE SYSTEM APPROVED *July 17 77*

INSPECTOR *[Signature]*

APPLICATION

HOWARD COUNTY

PERMIT APPLICATION

DEPARTMENT OF PUBLIC WORKS
BUREAU OF INSPECTIONS & PERMITS
COUNTY OFFICE BUILDING, ELLICOTT CITY, MARYLAND 21043

SERIAL NUMBER

32230

PERMIT NUMBER

DATE ISSUED

BUILDING ADDRESS (HOUSE NO., STREET, TOWN OR AREA)

12249 POINTER HILL CT.
ELLICOTT CITY, MD 21043
(WOODMARK)

LOT NO. (OR TAX MAP & PARCEL NO.)

19

BLOCK NO.

12

LIBER

FOLIO

SUB DIVISION

Woodmark

ZONE

R-40

ZONE MAP

HC-22

ELEC. DIST.

3

CENSUS TR.

6030

OWNER'S NAME AND ADDRESS

CHARLES "PATRICIA" LANCELOTTA
12249 POINTER HILL CT.
ELLICOTT CITY, MD. 21043

PHONE NO.

988-9140

OCCUPANT'S NAME AND ADDRESS

Same as above

PHONE NO.

ARCHITECT OR ENGINEER'S NAME AND ADDRESS

Plans drawn by owner

PHONE NO.

CONTRACTOR'S NAME AND ADDRESS

MINNARELLI & SONS INC.
SUMMIT CIRCLE
ELLICOTT CITY, MD. 21043 - 4656878

PHONE NO.

INTENDED USE OF STRUCTURE (BE SPECIFIC)

ADDITION TO HOME - 2 bed rooms +
bath + basement

EST. CONSTRUCTION COST

\$14,500.00

LICENSE NUMBER

2046

PERMIT FEE

QUALIFIED INSPECTOR OF CONSTRUCTION

SEAL

Application is hereby made for a permit to (INDICATE ONE)
ERECT USE ALTER EXTEND RAZE MOVE the (INDICATE ONE)
PERMANENT TEMPORARY structure described.

DESCRIPTION OF WORK

2 bedrooms, full bath and
unfurnished basement

SIZE OF BLDG.

FRONT

DEPTH

HEIGHT

TYPE OF BLDG.

AREA

VOLUME

ROOF

B. ROOMS

ROOMS

BATHS

FIREPLACES

FOOTINGS

FOUNDATION

S. WALLS

UTILITIES

WATER/WELL

SEWER/SEPTIC

GAS

ELECTRICITY

TYPE OF HEAT

AC

I have carefully examined and read this application and know the same is true and correct, and that in doing this work, all provisions of Howard County Ordinances and the State Laws of Maryland will be complied with, whether specified or not; and I will notify the Bureau of Inspections, and Permits twenty-four hours in advance when I am ready for the inspections called for elsewhere in this application; and that no work will be covered up until such inspections have been completed with.

Charles J. Lancelotta M.D.
M.D.

SIGNATURE

5/19/77

TITLE

DATE

FOR OFFICE USE ONLY

DISTANCE IN FEET FROM R/W LINE TO FRONT BUILDING LINE 50'

SIDE YARD 10'

(DISTANCE IN FEET FROM SIDE BLDG. LINE TO SIDE PROPERTY LINE)

DISTANCE IN FEET FROM SIDE STREET R/W LINE

TO SIDE BUILDING LINE 40'

DISTANCE IN FEET, REAR YD. REQUIRING SET

BACK 50' (CORNER LOT ONLY)

CONDITIONS (IF ANY)

Checks payable to DIRECTOR OF FINANCE OF HOWARD COUNTY

FOR OFFICE USE ONLY

FUNCTION	DATE	SIGNATURE APPROVAL
ZONING/PLANNING	6/21/77	C.E. Mann
SHA		
ROADS & STREETS		
BUILDING OFFICIAL		
WATER & SEWER		N/A
HEALTH DEPT.	6-23-77	Rev. Monaghan
FIRE PROTECTION		
STORM WATER MGM.	6/22/77	R.C. Williams

APPROVED

DATE

IMPORTANT: PLEASE SHOW ZIP CODES AND AREA CODES WHEREVER REQUIRED.

