

6/27/77

05-342538

# PERMIT

P 26218

A \_\_\_\_\_

SEWAGE DISPOSAL SYSTEM

MARYLAND STATE DEPARTMENT OF HEALTH

HOWARD COUNTY

ELLICOTT CITY

DISTRICT \_\_\_\_\_

## INDEXED

DATE 6/27/77

Jack Fyock IS PERMITTED TO INSTALL  ALTER

ADDRESS Triadelphia Road, Glenelg, Md. PHONE \_\_\_\_\_

A SEWAGE DISPOSAL-SYSTEM LOCATED AT \_\_\_\_\_

SUBDIVISION \_\_\_\_\_ ROAD 5325 Greenbridge Road LOT \_\_\_\_\_

PROPERTY OWNER Ray Bateman

ADDRESS Greenbridge Road Dayton to Greenbridge Road, cross dirt Rd., 2nd driveway on left

SPECIFICATIONS cross Tri. Mill Rd. onto dirt road (Green Bridge cont'd), 2nd driveway on left

DRAIN FIELD \_\_\_\_\_ DEPTH \_\_\_\_\_ FEET, BOTTOM AREA \_\_\_\_\_ SQ. FT.

SEEPAGE PITS \_\_\_\_\_ ABSORBENT SIDE-WALL AREA \_\_\_\_\_ SQ. FT.

SEPTIC TANK CAPACITY \_\_\_\_\_ GALLONS

FOR GARBAGE GRINDER, INCREASE DISPOSAL AREA 22% & TANK CAPACITY 50%.

OTHER REPAIR-CALL FOR INSPECTION WHEN GROUND IS OPENED UP SO SANITARIAN CAN

RECOMMEND REPAIR.


PLANS APPROVED BY Palmer F. Wine DATE 6/27/77

FILL SEPTIC TANK AND DISTRIBUTION BOX WITH WATER BEFORE CALLING FOR AN INSPECTION. COVER NO WORK UNTIL INSPECTED AND APPROVED.

NEITHER THE HOWARD COUNTY COMMISSIONERS NOR THE HEALTH DEPARTMENT IS RESPONSIBLE FOR THE SUCCESSFUL OPERATION OF ANY SYSTEM.

BLDG. PERMIT SIGNED AND RETURNED 12/2/85  
Serial # 67978  
addition - fm. man

26218

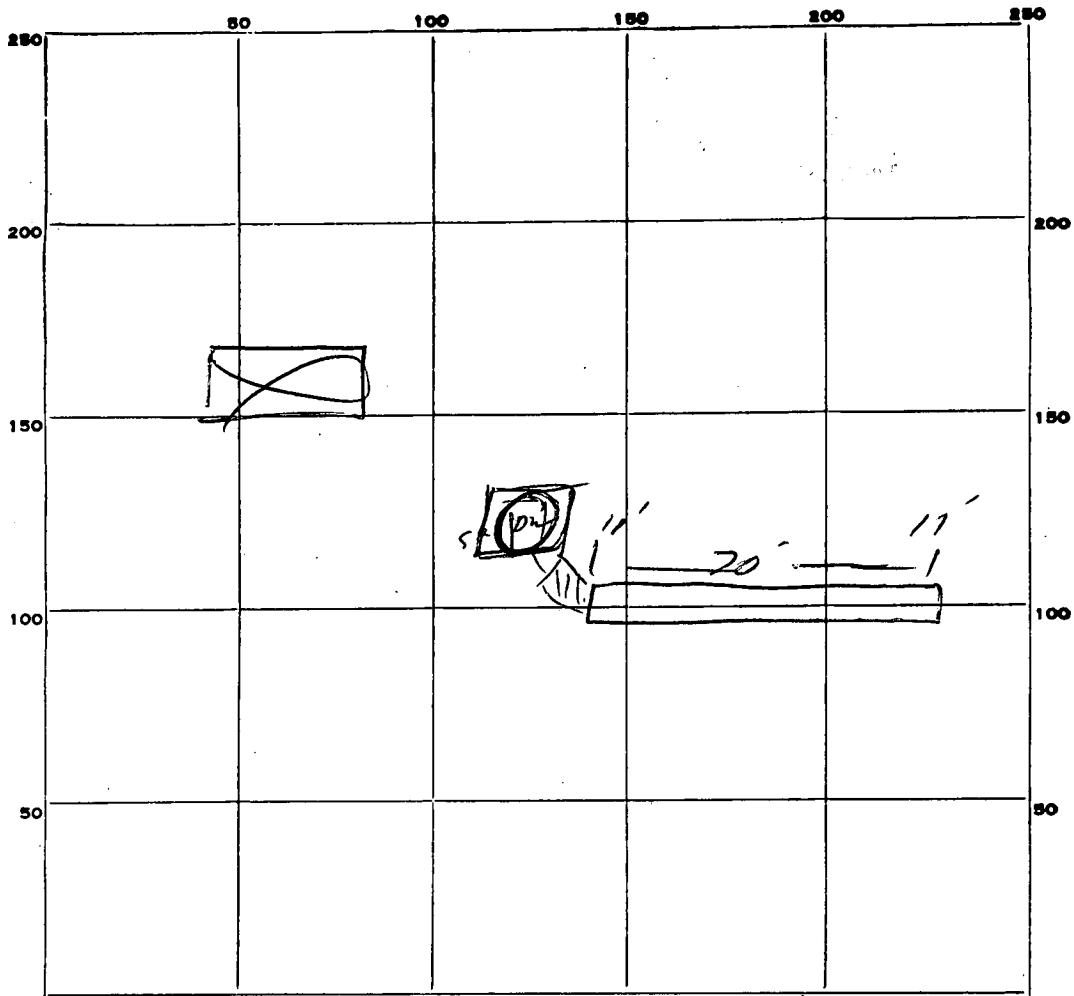

INDICATE NORTH. - NAME ADJOINING ROADWAY AS BASE LINE.  
 ← Greenbridge Dr.

PERMIT CARD \_\_\_\_\_

SEPTIC TANK, LEVEL \_\_\_\_\_

CLEANOUTS \_\_\_\_\_

DISTRIBUTION BOX, LEVEL \_\_\_\_\_

TILE FIELD, DEPTH 11 FT. TRENCH WIDTH 2 FT.

GRAVEL DEPTH 9 IN. TOTAL LENGTH 70 FT.

NUMBER OF TRENCHES 1 TOTAL <sup>sidewall</sup> BOTTOM AREA 560  $\phi$

SEEPAGE PITS, INSIDE DIAMETER \_\_\_\_\_ FT. DEPTH BELOW INLET \_\_\_\_\_ FT.

ABSORBENT AREA \_\_\_\_\_ SQ. FT.


REMARKS 27 Jan 77 looks OK for 4.B.R. R.M.

DATE SYSTEM APPROVED 27 Jan 77 INSPECTOR R.M. [Signature]

Will be underground  
but owner indicated  
spot (45' on diag  
from corner of proposed  
extension)

11/26/85  
Septic system OK (recently  
repaired)  
S.S. & well well not  
imposed on new  
proposed addition

ISSUE		BY & DATE		REVISIONS		DESCRIPTION		CHECK		APPROVED & DATE	

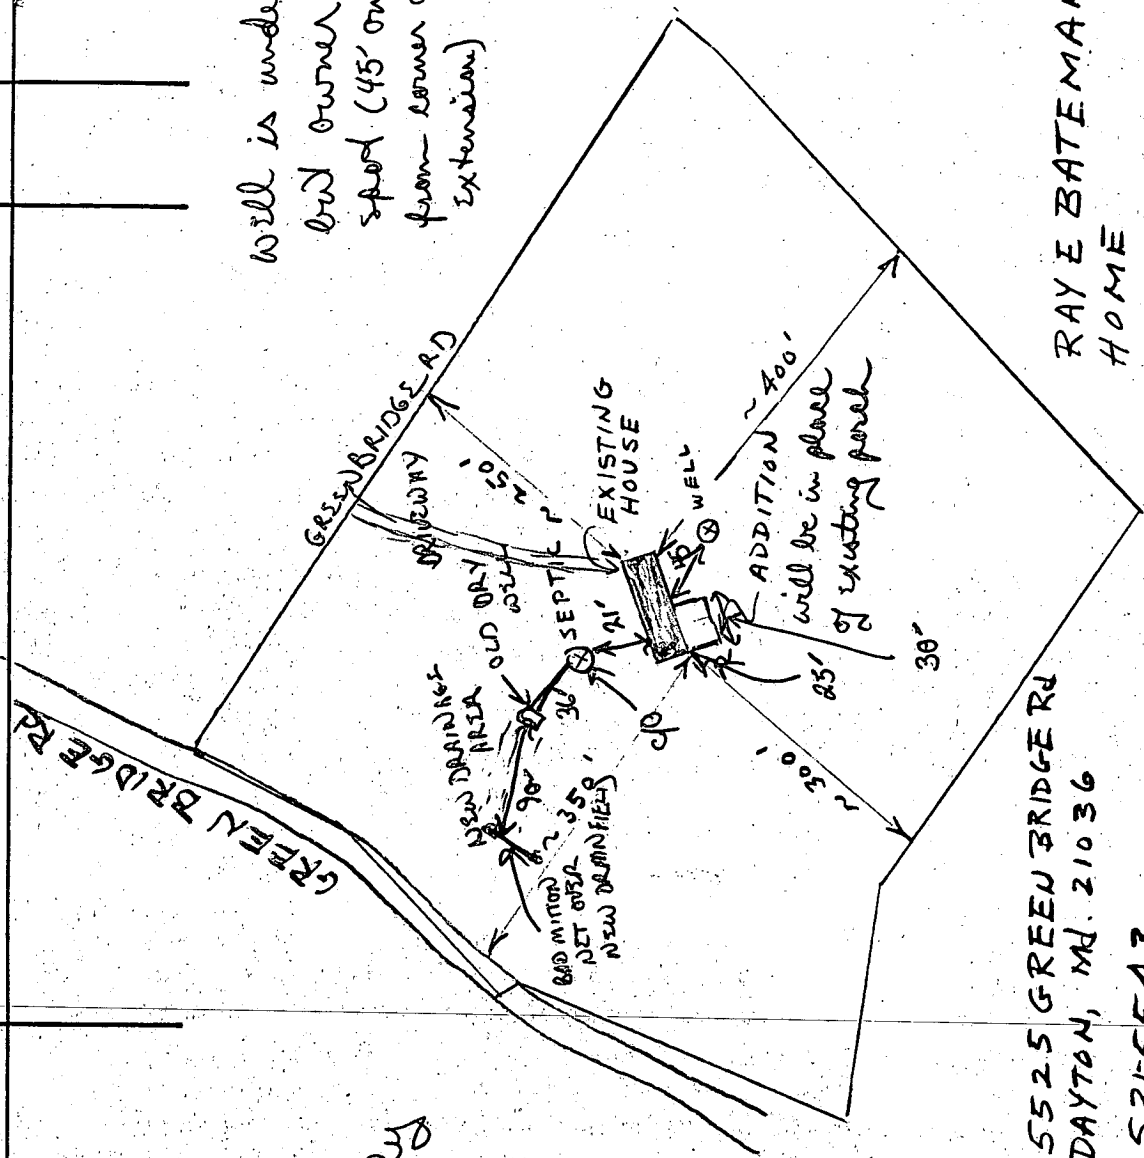

DWG SIZE	PART OR IDENTIFYING NUMBER	CIRCUIT SYMBOL OR ZONE	NOMENCLATURE OR DESCRIPTION	STOCK SIZE	MATERIAL AND/OR MATERIAL SPECIFICATION	MFG CODE	ISSUE REV

LIST OF MATERIAL