

7/1/77 a.m. please - appeal S.F.S.
7/1/77
10:30 to 12:00
4/9/77 a.m.
plans

25228

PERMIT

SEWAGE DISPOSAL SYSTEM

A Repair

MARYLAND STATE DEPARTMENT OF HEALTH

HOWARD COUNTY

01-175955

ELLICOTT CITY

DISTRICT 1st

INDEXED

DATE 6/27/77

Cecil Crenshaw

IS PERMITTED TO INSTALL ALTER X

ADDRESS Waterloo Road, Ellicott City, Md.

PHONE 465-4772

A SEWAGE DISPOSAL SYSTEM LOCATED AT _____

SUBDIVISION _____ ROAD 6079 Old Lawyers Hill Rd LOT _____

PROPERTY OWNER Robert Carter

ADDRESS 6079 Old Lawyers Hill Road, Elkridge, Md.

Phone: 796-4358

SPECIFICATIONS

DRAIN FIELD _____ DEPTH _____ FEET, BOTTOM AREA _____ SQ. FT.

SEEPAGE PITS _____ ABSORBENT SIDE-WALL AREA _____ SQ. FT.

SEPTIC TANK CAPACITY _____ GALLONS

FOR GARBAGE GRINDER, INCREASE DISPOSAL AREA 22% & TANK CAPACITY 50%.

OTHER Repair - Call for inspection when ground is opened up and Sanitarian will
recommend repair system.

**BUILDING PERMIT SIGNED
AND RETURNED**

8-1000-800149700-UG PROPOSED TANK


PLANS APPROVED BY Frank Skinner

DATE 6/27/77

FILL SEPTIC TANK AND DISTRIBUTION BOX WITH WATER BEFORE CALLING FOR AN INSPECTION. COVER NO WORK UNTIL INSPECTED AND APPROVED.

NEITHER THE HOWARD COUNTY COMMISSIONERS NOR THE HEALTH DEPARTMENT IS RESPONSIBLE FOR THE SUCCESSFUL OPERATION OF ANY SYSTEM.

26228

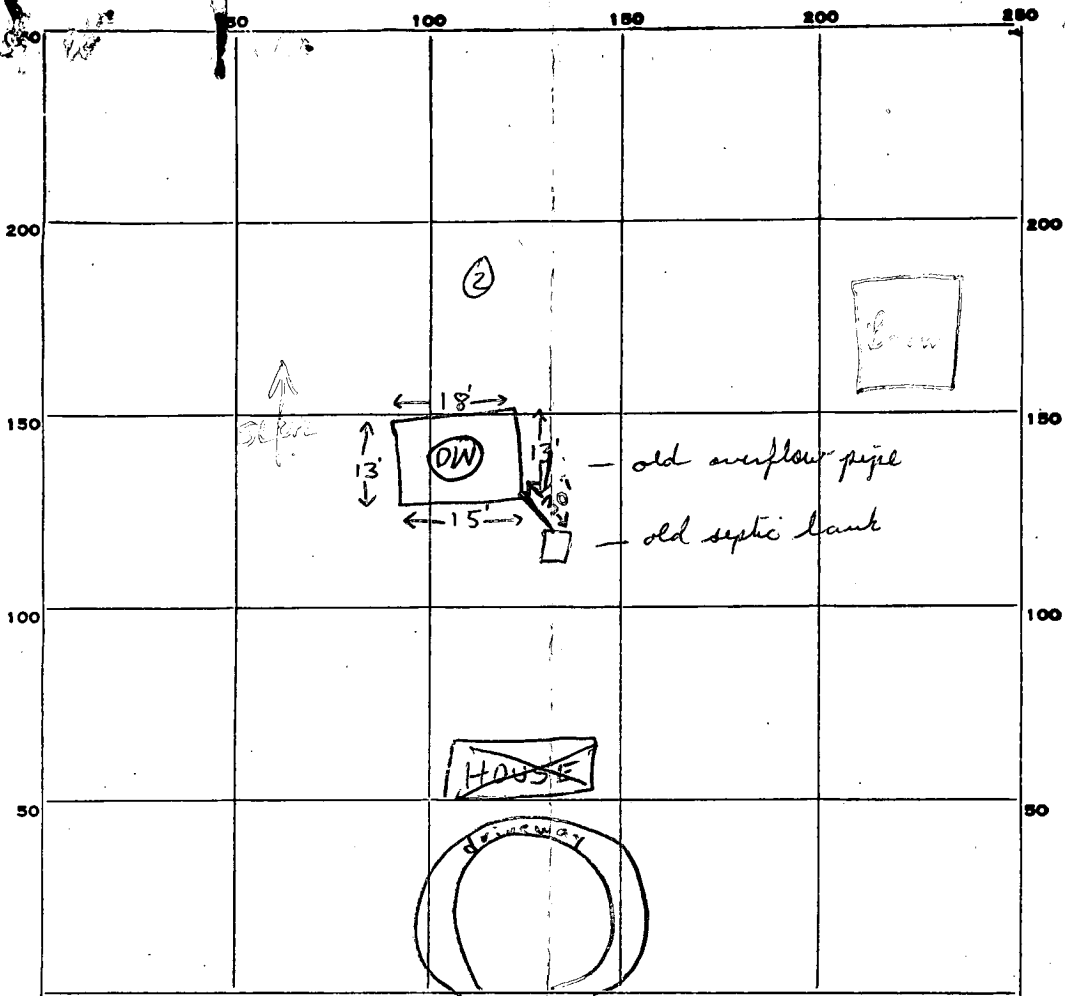

INDICATE NORTH. - NAME ADJOINING ROADWAY AS BASE LINE.

Old Lawyers Hill Rd

PERMIT CARD Signed W.S.C. F.S.

S.T.	D.W.
<input checked="" type="checkbox"/>	<input checked="" type="checkbox"/>

SEPTIC TANK, LEVEL existing

CLEANOUTS

DISTRIBUTION BOX, LEVEL n.a.

TILE FIELD, DEPTH _____ FT. TRENCH WIDTH _____ FT.

GRAVEL DEPTH _____ IN. TOTAL LENGTH OF TRENCHES _____ FT.

NUMBER OF TRENCHES _____ TOTAL BOTTOM AREA _____

SEEPAGE PITS, ^{OUTSIDE PERIMETER} INSIDE DIAMETER 59 FT. DEPTH BELOW INLET ~13 FT.

ABSORBENT AREA ± 767 SQ. FT.

REMARKS 7/7/77 Drywell dug to ~17 or 18' deep. soil is clayey sandy loam 0-7' sandy loam below. depth O.K. inlet will be ~3-4'. Old overflow pipe to be removed & all lines from house tied into septic tank. if septic tank is collapsed a new tank into be installed F.S.

7/11/77 Old overflow pipe removed; new cleanout put on septic tank; o.g. to cover all work F.S.

DATE SYSTEM APPROVED 7/11/77

INSPECTOR F. Skinner

APPLICATION

PERMIT APPLICATION

DEPARTMENT OF PUBLIC WORKS
BUREAU OF INSPECTIONS & PERMITS
COUNTY OFFICE BUILDING, ELLICOTT CITY, MARYLAND 21043

PERMIT NUMBER

DATE ISSUED

BUILDING ADDRESS (HOUSE NO., STREET, TOWN OR AREA)

6079 Old Lawyers Hill Road
Ellicott City

LOT NO. (OR TAX MAP & PARCEL NO.)	Block 16	BLOCK NO.	LIBER	FOLIO
6079 Old Lawyers Hill Rd	21	160	599	
SUB-DIVISION	ZONE	ZONE MAP	ELEC. DIST.	CENSUS TR.
	R-20	HC32	1	6012

OWNER'S NAME AND ADDRESS
Robert Carter
6079 Old Lawyers Hill Rd.
PHONE NO. 796-4358

OCCUPANT'S NAME AND ADDRESS
Robert Carter
6079 Old Lawyers Hill Rd.
PHONE NO. 796-4358

ARCHITECT OR ENGINEER'S NAME AND ADDRESS
M.T. Nichols
8530 C Town + Country Blvd
PHONE NO. 461-9512

CONTRACTOR'S NAME AND ADDRESS
M.T. Nichols
8530 C Town + Country Blvd.
PHONE NO. 461-9512

INTENDED USE OF STRUCTURE (BE SPECIFIC)
Addition Porchroom + Bedroom

EST. CONSTRUCTION COST	LICENSE NUMBER	PERMIT FEE
125,000		

N/A FOR OFFICE USE ONLY

DISTANCE IN FEET FROM R/W LINE TO FRONT BUILDING LINE 50'
SIDE YARD 20'
(DISTANCE IN FEET FROM SIDE BLDG. LINE TO SIDE PROPERTY LINE)
DISTANCE IN FEET FROM SIDE STREET R/W LINE
TO SIDE BUILDING LINE
DISTANCE IN FEET, REAR YD. REQUIRING SET,
BACK 50' (CORNER LOT ONLY)
CONDITIONS (IF ANY)

Checks payable to DIRECTOR OF FINANCE OF HOWARD COUNTY

CAUTION
No construction before permit conditions have been issued and approved and the notice is published in the law.
Use and occupancy permit must be applied for two weeks before it will be issued.

IMPORTANT: PLEASE SHOW ZIP CODES AND AREA CODES WHEREVER REQUIRED.

6/27/77 Visited property, spoke to Mr. Carter evidence of recent overflow noted a 100' behind house. Advised Mr. Carter to get repair as soon as possible if he wants his building permit F.S.

previous owner Richard Patterson 11/1/77 Carter work is granted

7/13/77 O.K. to approve B.P. 12/77 settlement F.S.

QUALIFIED INSPECTOR OF CONSTRUCTION SEAL
Application is hereby made for a permit to (INDICATE ONE) ERECT USE ALTER EXTEND RAZE MOVE the (INDICATE ONE) PERMANENT TEMPORARY structure described.

DESCRIPTION OF WORK
Two Story Addition Framed

SIZE OF BLDG.	FRONT	DEPTH	HEIGHT
20' x 25' behind house right rear	25'	20'	2.5'

TYPE OF BLDG.	AREA	VOLUME	ROOF
B. ROOMS ROOMS BATHS FIREPLACES	500 sq ft		

FOOTINGS	FOUNDATION	S. WALLS
20" wide 9" thick	12" x 16"	

UTILITIES			
WATER/WELL	SEWER/SEPTIC	GAS	ELECTRICITY
			AC

I have carefully examined and read this application and know the same is true and correct, and that in doing this work, all provisions of Howard County Ordinances and the State Laws of Maryland will be complied with, whether specified or not; and I will notify the Bureau of Inspections, and Permits twenty-four hours in advance when I am ready for the inspections called for elsewhere in this application; and that no work will be covered up until such inspections have been completed with.

M. T. Nichols
Builder
SIGNATURE
June 2, 1977
DATE

System to be a 15 x 15 DW 13 deep w/ 9 ft of
stone below invert. in vicinity of uphill hole
which is 10 ft below and 5 to the left of the
existing overflow pipe of original system
RAB 7-5-77

Pool

Public H₂O

800149700 - LP Tank Location
OK: Plan to scale

SITE SURVEY

NAME: Bonnie Ballinger ADDRESS: 6079 Old Lawyers Hill rd ACCOUNT #: _____
DATE: 7/26/04 DONE BY: Peere

- WELL
- PUBLIC WATER
- PUBLIC SEWER
- DELIVERY ACCESS
- LANDMARKS/OBSTACLES
- PROPERTY LINE SETBACKS
- IGNITION SOURCE SETBACKS
- NEW/EXISTING CONSTRUCTION
- DIRECTIONAL COMPASS

Existing House
County Worker
Scale - ~~1/4" = 10'~~
40

