

SEPTIC SYSTEM TO BE
INSTALLED FIRST BEFORE
BUILDING PERMIT CAN BE
SIGNED.

PERMIT

File

7/15/77 Partial c.s.
P-26485
A-21495 c.S.
7/15/77 4th for call
19/14/77 Partial
DATE 10/27/77
Stop allowed
c.S.

SEWAGE DISPOSAL SYSTEM
MARYLAND STATE DEPARTMENT OF HEALTH

7/25/77
11/14/77 P.M.

HOWARD COUNTY

ELLCOTT CITY

INDEXED
INDEXED

DISTRICT 4th

Tom Harris

IS PERMITTED TO INSTALL X ALTER

ADDRESS Box 6 Monkton, Md.

BUDG. PERMIT SIGNED

A SEWAGE DISPOSAL SYSTEM LOCATED AT

AND RETURNED 4/10/78

Serial # B-101 09881
C.S.

SUBDIVISION (Forsythe Heights)

ROAD OFF Monticello Drive 107' 00"

PROPERTY OWNER Thomas G. Oyster

~~Thomas G. Oyster~~ COVER

ADDRESS 2480 Beech Drive, Monkton, Md.

SPECIFICATIONS 8 bedrooms

DRAIN FIELD DEPTH FEET, BOTTOM AREA SQ. FT.

SEEPAGE FITS ABSORBENT SIDE-WALL AREA SQ. FT.

SEPTIC TANK CAPACITY 1000 GALLONS

B.P. # 57887

FOR GARBAGE GRINDER, INCREASE DISPOSAL AREA 25% & TANK CAPACITY 50%

OTHER DRY WELL & TRENCH - Dry well to have 200 square feet absorbent sidewall area

Inlet to be 4 ft. and a maximum depth of 9 ft. Locate the dry well 20 ft. from right of way and 150 ft. from left (262-15) line

TRENCH TO BE 45 FT. LONG FOR A TOTAL SIDEWALL AREA OF 275 SQUARE FT. Inlet at 4 ft. and a maximum depth of 9 ft.

Distribution box 2 ft. from dry well then trench. Trenches to run parallel to right of way towards lot.

NOTE: CALL FOR INSPECTION BEFORE GRAVEL IS INSTALLED.

NOTE: ALL PIPE FROM HOUSE TO DISPOSAL AREA MUST BE CAST IRON. PERMIT VOID AFTER THREE YEARS.

PLANS APPROVED BY D.J. O'Neill

DATE 6/16/75

NOTE: INSTALL STAND PIPE ON SEPTIC TANK AND DRY WELL. STAND PIPES MUST BE 6 INCHES

FILL SEPTIC TANK AND DISTRIBUTION BOX WITH WATER BEFORE CALLING FOR AN INSPECTION. COVER NO WORK UNTIL INSPECTED AND APPROVED.


INCHES IN DIAMETER. CAST IRON, CONCRETE OR TERRA COTTA ACCEPTED.

NEITHER THE HOWARD COUNTY COMMISSIONERS NOR THE HEALTH DEPARTMENT IS RESPONSIBLE FOR THE SUCCESSFUL OPERATION OF ANY SYSTEM.

11/14/77 Checked - copy of septic tank & 3 other plans - construction in line approved Mr. Harris present
left yellow sign on card - ok to backfill
final approved given. C.S.
BUDG. PERMIT SIGNED
AND RETURNED 3/10/78
Serial # 24015 Bidura

26485

P-26485

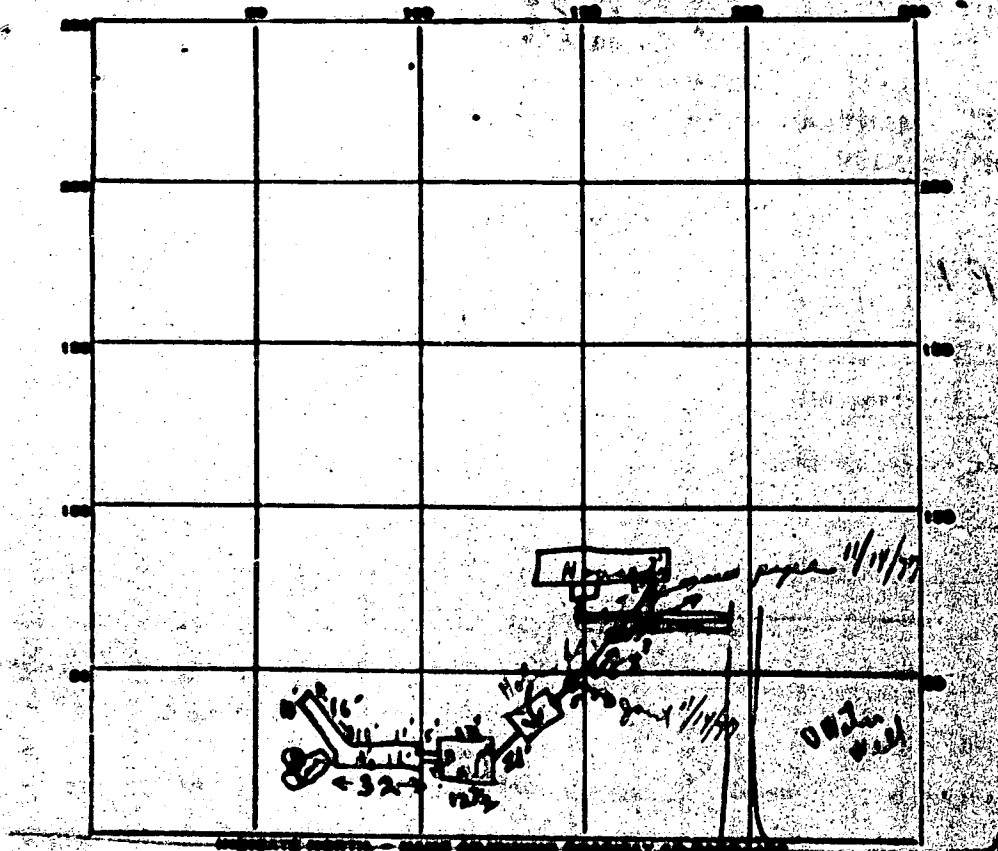

Pl 77
 M. L. L. called

PERMIT CARD Not over 10' No. R/N
 SEPTIC TANK LEVEL OK CLEANOUTS S.T. | R.W.
 DISTRIBUTION BOX LEVEL U/A Yes Yes

Trench DEPTH 10'-11' FT. TRENCH WIDTH — FT.
 GRAVEL DEPTH 36' - 21' TOTAL LENGTH 48' FT. 20 1/2' in trench
 NUMBER OF TRENCHES 1 TOTAL BOTTOM AREA —
 SEEPAGE FITS. INSIDE DIAMETER 4 1/2 FT. DEPTH BELOW INLET 5 FT. 220'
 ABSORBENT AREA 504 SQ. FT.

REMARKS 7/25/77 ① No house, water well in the date, trench only ok for gravel, no pipe in this date.
 ② 1' depth of dry well
 } ok to cover trench of system leak, cost was checked C.B.S.
no pipe - from septic tank towards house C.B.S.
Partial outpour 11/11/77 ① water tank filled
time to inspect 11/11/77 cost left c. 80

DATE SYSTEM APPROVED 11/11/77 INSPECTOR C.B.S.

