

PERMIT

SEWAGE DISPOSAL SYSTEM

MARYLAND STATE DEPARTMENT OF HEALTH

HOWARD COUNTY

01-173502

ELLICOTT CITY

DISTRICT 1st

P 26510

A35265

INDEXED

DATE 7/29/77

Roy C. Vest, Jr.

IS PERMITTED TO INSTALL ALTER X

ADDRESS Poplar Avenue, Halethorpe, Md. 21227

PHONE 242-0318

A SEWAGE DISPOSAL SYSTEM LOCATED AT

SUBDIVISION

ROAD

⁶²⁹¹
~~6299~~ Rockburn Hill
Elkridge, Md.

LOT

PROPERTY OWNER

Wilbur L. Medairy, Jr.

ADDRESS 5534 Levering Avenue, Elkridge, Md. 21227

Phone: 796-⁰⁹³⁷~~4328~~

SPECIFICATIONS

DRAIN FIELD _____ DEPTH _____ FEET, BOTTOM AREA _____ SQ. FT.

SEEPAGE PITS _____ ABSORBENT SIDE-WALL AREA _____ SQ. FT.

SEPTIC TANK CAPACITY _____ GALLONS

BLDG. PERMIT SIGNED
AND RETURNED 9/15/77

FOR GARBAGE GRINDER, INCREASE DISPOSAL AREA 22% & TANK CAPACITY 50%. Serial No. 32836

OTHER REPAIR - Call for inspection when ground is opened up and Sanitarian will

recommend repair system. 1000gal. septic tank and a 15'x15'x(13'deep) drywell with inlet no deeper than 3 1/2' below original grade. Place the drywell ~25' to the left of the rear of existing house. Call for inspection before covering any work.

PLANS APPROVED BY Palmer F. Wine

DATE 7/29/77


FILL SEPTIC TANK AND DISTRIBUTION BOX WITH WATER BEFORE CALLING FOR AN INSPECTION. COVER NO WORK UNTIL INSPECTED AND APPROVED.

NEITHER THE HOWARD COUNTY COMMISSIONERS NOR THE HEALTH DEPARTMENT IS RESPONSIBLE FOR THE SUCCESSFUL OPERATION OF ANY SYSTEM.

BLDG. PERMIT SIGNED
AND RETURNED 8/13/84
Serial # 60576
Addition Bedroom

BLDG. PERMIT SIGNED
AND RETURNED 4/25/78
Serial No. 35265
Pool permit

P 26510

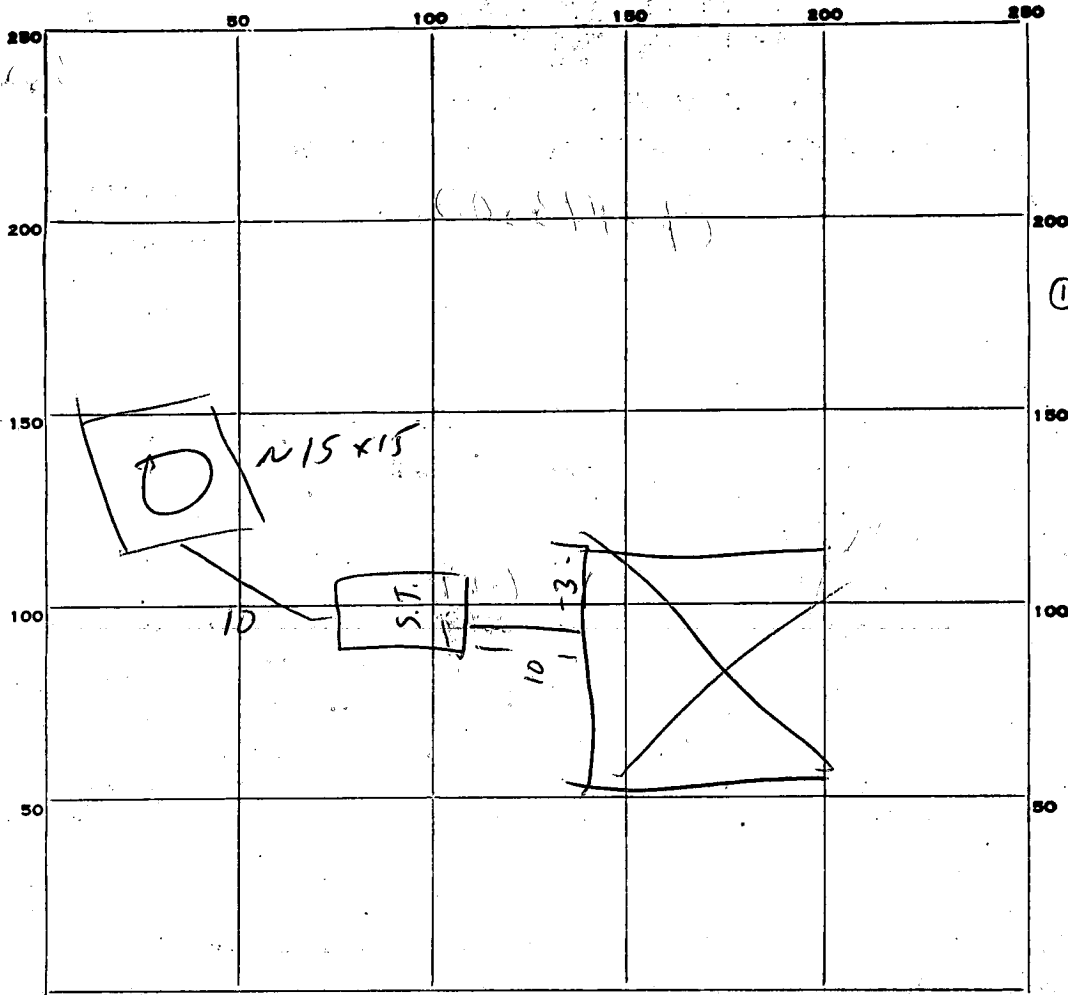

INDICATE NORTH. — NAME ADJOINING ROADWAY AS BASE LINE.

PERMIT CARD _____

SEPTIC TANK, LEVEL _____

CLEANOUTS _____

DISTRIBUTION BOX, LEVEL _____

TILE FIELD, DEPTH _____ FT. TRENCH WIDTH _____ FT.

GRAVEL DEPTH _____ IN. TOTAL LENGTH _____ FT.

NUMBER OF TRENCHES _____ TOTAL BOTTOM AREA _____


SEEPAGE PITS, INSIDE DIAMETER Perimeter 60 FT. DEPTH BELOW INLET 10 FT.

ABSORBENT AREA 600 SQ. FT.

REMARKS _____

- make cleanout plugs for cleanouts
- re-seal pipe to S.T.

DATE SYSTEM APPROVED 14 Sept 77 INSPECTOR R M [signature]


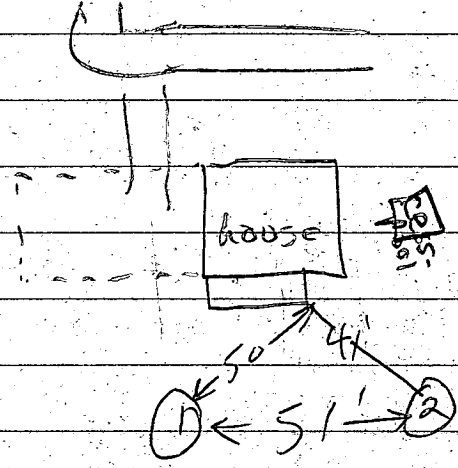


- ① 3' dry hole clay to 7' below
- ② 14' 207 210 212 1' (11 min)

360

~~29255~~

$$\begin{array}{r} 19 \\ 137 \\ \hline 24 \\ 16 \\ \hline 24 \end{array}$$

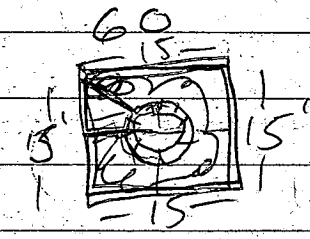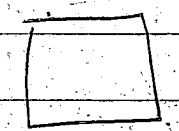

15x15x13
 3/11
 2 min.

HOWARD COUNTY HEALTH DEPARTMENT
 Division of Environmental Health
 3450 Court House Drive
 Ellicott City, Maryland
 Tel: 465-5000, Ext. 356

35265

DATE: 4/11/78

- TO:
- MD. STATE DEPT. OF HEALTH
 - COUNTY EXECUTIVE
 - DEPT. OF PUBLIC WORKS
 - BUREAU OF WATER & SEWERS
 - OTHERS: ① D.W.M. after below done
 - BOARD OF EDUCATION
 - OFFICE OF PLANNING & ZONING
 - DIVISION OF LAND DEVELOPMENT
 - BUILDING ENGINEER
 - BUREAU OF LICENSES, INSPECTION & PERMITS

RE: 6291 Rockbass Hill - Ellicott City, Md

- The above referenced:
- Final Plat
 - Preliminary Plat
 - Site Development Plan
 - Building Plans
 - Other: Pool

- IS:
- Approved
 - Disapproved
 - Approved, if public water and sewerage are provided.
 - Approved, provided State Health Department notifies the Health Officer that he can sign the plat or bldg. permit.
 - May the Health Officer sign the above referenced plat?

COMMENTS: 4/11/78 Others: (P) Hold { - Needs vacuum breaker ^{on outlet} ^{included} falling pool _{for overflow of septic.}
 c.B.D. of work. (Also check in field if not already done)


- Preliminary plat needs revising.
- Final plat needs revising.
- Request that Engineer come to this office for conference.
- Submit completed Food Establishment check list.
- Percolation tests not performed.
- State Subdivision Regulations not complied with.
- Submit complete plans and specifications.
- See attached Regulations or literature.

OTHER COMMENTS: 4/11/78 Hold (P)
 c.B.D.

Signed: _____



District - 01 Account Number - 173510

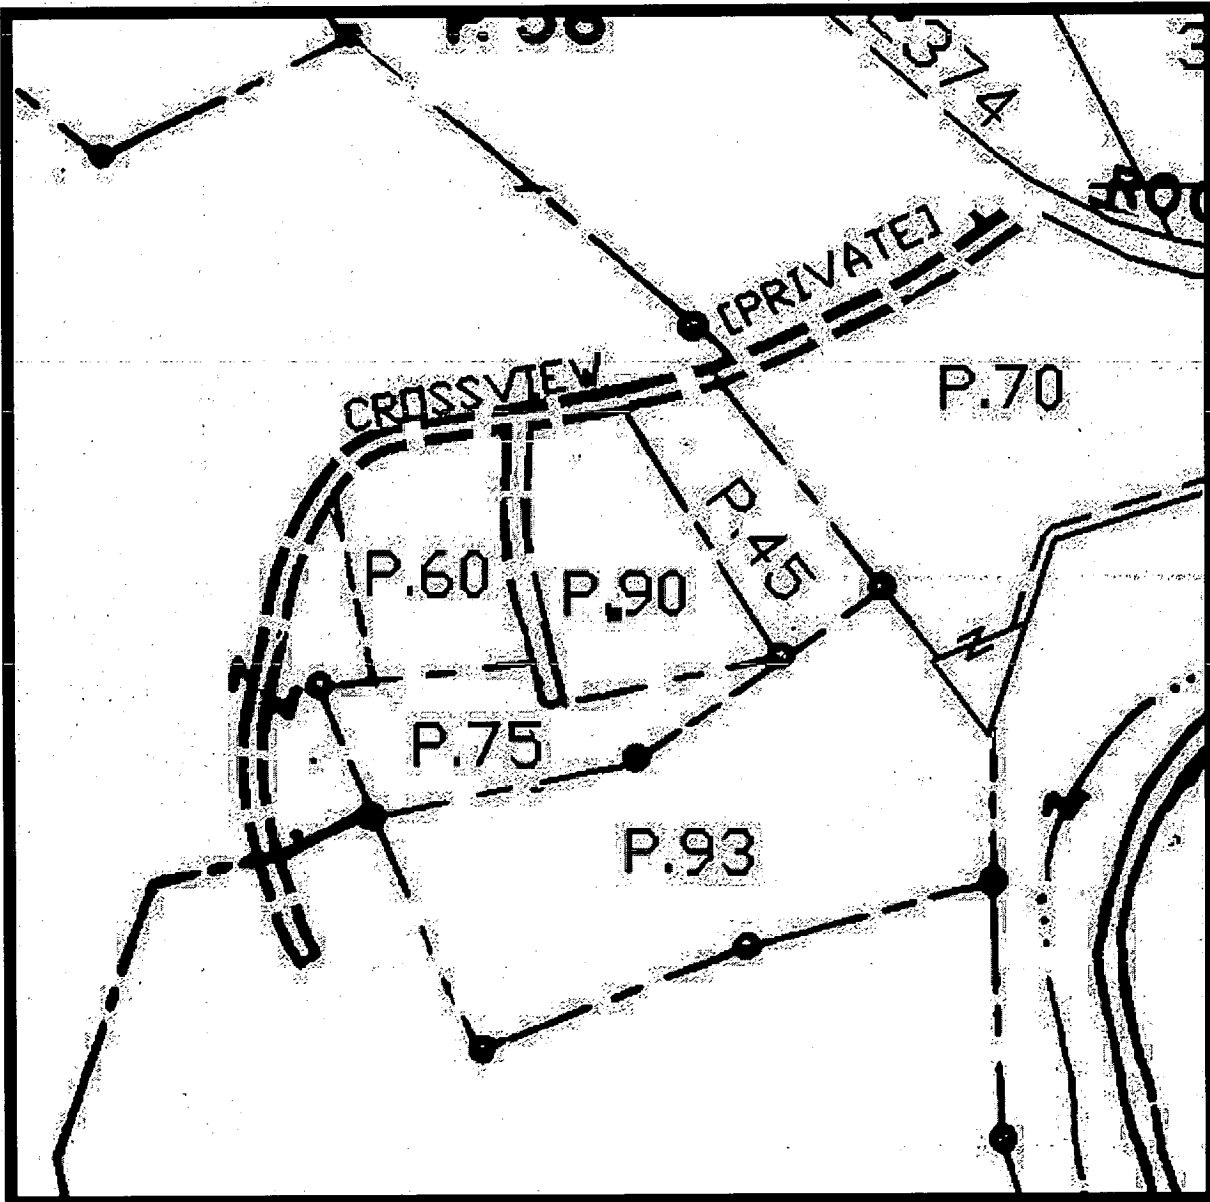

Property maps provided courtesy of the Maryland Department of Planning ©2001 - 2002.
For more information on electronic mapping applications, visit the Maryland Department of Planning
web site at www.mdp.state.md.us/webcom/index.html

DRILLER: REMOVE COPY AND RETAIN FOR YOUR RECORDS. RETURN COUNTY COPY TO COUNTY ENVIRONMENTAL AGENCY. SUBMIT COPY TO OWNER. RETURN ALL OTHER PARTS TO DEPARTMENT OF ENVIRONMENT, 2500 BROENING HIGHWAY, BALTIMORE, MARYLAND 21224.

C1 3862	SEQUENCE NO. (MDE USE ONLY)	STATE OF MARYLAND	THIS REPORT MUST BE SUBMITTED WITHIN 45 DAYS AFTER WELL IS COMPLETED.
1 2 3 6 (THIS NUMBER IS TO BE PUNCHED IN COLS. 3-6 ON ALL CARDS)		WELL COMPLETION REPORT	COUNTY NUMBER P519616
ST/CO USE ONLY DATE Received MM DD YY 8 13		DATE WELL COMPLETED MM DD YY 11/20/03	Depth of Well 300 (TO NEAREST FOOT)
OWNER MEDIARY PETE		PERMIT NO. FROM "PERMIT TO DRILL WELL" HD-94-3827	28 29 30 31 32 33 34 35 36 37
STREET OR RFD ROCKBURN HILL		TOWN ELKRIDGE	
SUBDIVISION _____		SECTION _____	LOT _____
WELL LOG Not required for driven wells		GROUTING RECORD WELL HAS BEEN GROUTED (Circle Appropriate Box) Y N	
STATE THE KIND OF FORMATIONS PENETRATED, THEIR COLOR, DEPTH, THICKNESS AND IF WATER BEARING		TYPE OF GROUTING MATERIAL (Circle one) CEMENT CM BENTONITE CLAY BC	
DESCRIPTION (Use additional sheets if needed)	FEET FROM TO check if water-bearing	CEMENT CM NO. OF BAGS 14 NO. OF POUNDS 1700 BENTONITE CLAY BC	
Top Soil 0 2 Brown Shale 2 15 Gray slate 15 70 Brown slate 70 71 Gray slate 71 200 Gray Granite 200 300		GALLONS OF WATER 84 DEPTH OF GROUT SEAL (to nearest foot) 38 from 0 TOP ft. to 38 BOTTOM ft.	
		CASING RECORD casing types insert appropriate code below ST STEEL CO CONCRETE PL PLASTIC OT OTHER	
		MAIN CASING TYPE ST Nominal diameter top (main) casing (nearest inch)! 6 Total depth of main casing (nearest foot) 40 60 61 63 64 66 70	
		OTHER CASING (if used) diameter inch depth (feet) from to	
		SCREEN RECORD screen-type or open hole insert appropriate code below ST STEEL BR BRASS HO OPEN HOLE PL PLASTIC OT OTHER	
NUMBER OF UNSUCCESSFUL WELLS: 0		C.2 DEPTH (nearest ft.) 110 38 300	
WELL HYDROFRACTURED Y N		E A C H S R E E N 8 9 11 15 17 21 23 24 26 30 32 36 38 39 41 45 47 51	
CIRCLE APPROPRIATE LETTER A A WELL WAS ABANDONED AND SEALED WHEN THIS WELL WAS COMPLETED E ELECTRIC LOG OBTAINED P TEST WELL CONVERTED TO PRODUCTION WELL		CASING HEIGHT (circle appropriate box and enter casing height) + above } LAND SURFACE - below } 2 (nearest foot)	
I HEREBY CERTIFY THAT THIS WELL HAS BEEN CONSTRUCTED IN ACCORDANCE WITH COMAR 26.04.04 "WELL CONSTRUCTION" AND IN CONFORMANCE WITH ALL CONDITIONS STATED IN THE ABOVE CAPTIONED PERMIT, AND THAT THE INFORMATION PRESENTED HEREIN IS ACCURATE AND COMPLETE TO THE BEST OF MY KNOWLEDGE.		LOCATION OF WELL ON LOT SHOW PERMANENT STRUCTURE SUCH AS BUILDING, SEPTIC TANKS, AND /OR LANDMARKS AND INDICATE NOT LESS THAN TWO DISTANCES (MEASUREMENTS TO WELL)	
DRILLERS LIC. NO. MW0040 George F. Johnston DRILLERS SIGNATURE (MUST MATCH SIGNATURE ON APPLICATION)		GRAVEL PACK IF WELL DRILLED WAS FLOWING WELL INSERT F IN BOX 68 68	
LIC. NO. 33 D 0 3 8 Bruce Simpson		MDE USE ONLY (NOT TO BE FILLED IN BY DRILLER) T (E.R.O.S.) W.O.	
SITE SUPERVISOR (sign. of driller or journeyman responsible for sitework if different from permittee)		TELESCOPE CASING LOG INDICATOR OTHER DATA	

B 1 0719

SEQUENCE NO. (MDE USE ONLY)

STATE OF MARYLAND APPLICATION FOR PERMIT TO DRILL WELL

STATE PERMIT NUMBER

HO - 94 - 3827

519616 please type

fill in this form completely

Date Received (ARA) 10-14-03

OWNER INFORMATION 9566

B 3

LOCATION OF WELL

8 MM DD YY 13

MEDIARY PETE

15 Last Name Owner First Name 34

6299 ROCKBURN HILL RD

36 Street or RFD 55

ELKRIDGE, MD 21075

57 Town 70 State 72 Zip 76

Howard

8 COUNTY

23 SUBDIVISION

SECTION 44 46 LOT 48 50

Elkridge

52 NEAREST TOWN

MILES FROM TOWN (enter 0 if in town) 73 76-77 78

DRILLER INFORMATION

George F. Easterday M W D 646

Driller's Name 76 License No. 81

L. Franklin Easterday, Inc.

Firm Name

9265 Brown Church Rd., MT. Airy, Md. 21771


Address

George F. Easterday 10/9/03

Signature Date

B 4

DIRECTION OF WELL FROM TOWN (CIRCLE BOX)

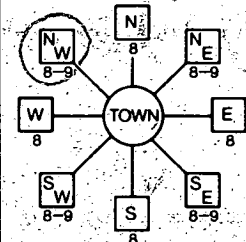

Rockburn Hill Rd

11 NEAR WHAT ROAD 30

ON WHICH SIDE OF ROAD (CIRCLE APPROPRIATE BOX)



34 50 37 DISTANCE FROM ROAD Ft

TAX MAP 32 BLK 20 PARCEL 905

B 2

WELL INFORMATION

APPROX. PUMPING RATE (GAL. PER MIN.) 5

AVERAGE DAILY QUANTITY NEEDED (GAL. PER DAY) 500

USE FOR WATER (CIRCLE APPROPRIATE BOX)

- Domestic Potable Supply & Residential Irrigation (circled)
Farming Livestock Watering & Agricultural Irrigation
Industrial Commercial, Dewatering
Public Water Supply Well
Test, Observation, Monitoring
Geo-Thermal

NOT TO BE FILLED IN BY DRILLER HEALTH DEPARTMENT APPROVAL

Howard P519616

COUNTY NAME COUNTY NO.

STATE SIGNATURE INSERT S.

DATE ISSUED 10/24/03

CO SIGNATURE EXP. DATE 10/24/04

NORTH GRID 507 000 EAST GRID 877 000

APPROXIMATE DEPTH OF WELL 300 FEET

APPROXIMATE DIAMETER OF WELL 6 INCH

METHOD OF DRILLING (circle one)

BORED (or Augered) JETTED Jetted & DRIVEN

AIR ROTARY AIR-PERCussion ROTARY (Hydraulic Rotary)

CABLE REVerse-ROtary Drive POINT

REPLACEMENT OR DEEPEMED WELLS (CIRCLE APPROPRIATE BOX)

- This well will not replace an existing well (circled)
This well will replace a well that will be abandoned and sealed
This well will replace a well that will be used as a standby contact local approving authority for policy on standby wells
This well will deepen an existing well

PERMIT NUMBER OF WELL TO BE REPLACED OR DEEPEMED (IF AVAILABLE) 41

Not to be filled in by driller (MDE OR COUNTY USE ONLY)

APPROP. PERMIT NUMBER G
PERMIT No. HO - 94 - 3827

SHOW MAJOR FEATURES OF BOX & LOCATE WELL WITH AN X


SOURCES OF DRILLING WATER

- 1. wells
2.
3.

WRITE THE BOX NUMBER FROM THE MAP HERE

E 500 6
870 7

DRAW A SKETCH BELOW SHOWING LOCATION OF WELL IN RELATION TO NEARBY TOWNS AND ROADS AND GIVE DISTANCE FROM WELL TO NEAREST ROAD JUNCTION: 17 G 4

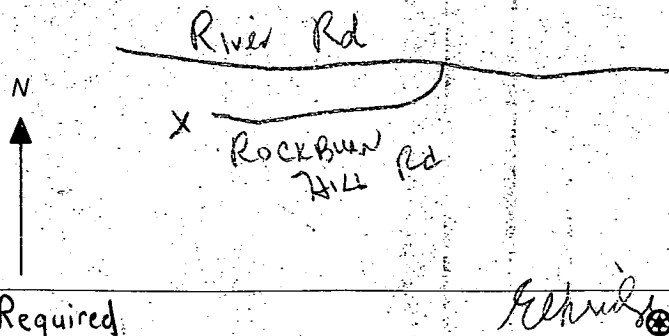


SPECIAL CONDITIONS


Yield Test Required

REPORT OF ADDRESSES
 FROM WELL DRILLER DOES NOT MATCH
 ADDRESSES FROM TAX RECORDS (AS SHOWN)
 MR 10/14/03

10/22/03
 Site Visit


PROP. WELL OK 

UTTER ROAD

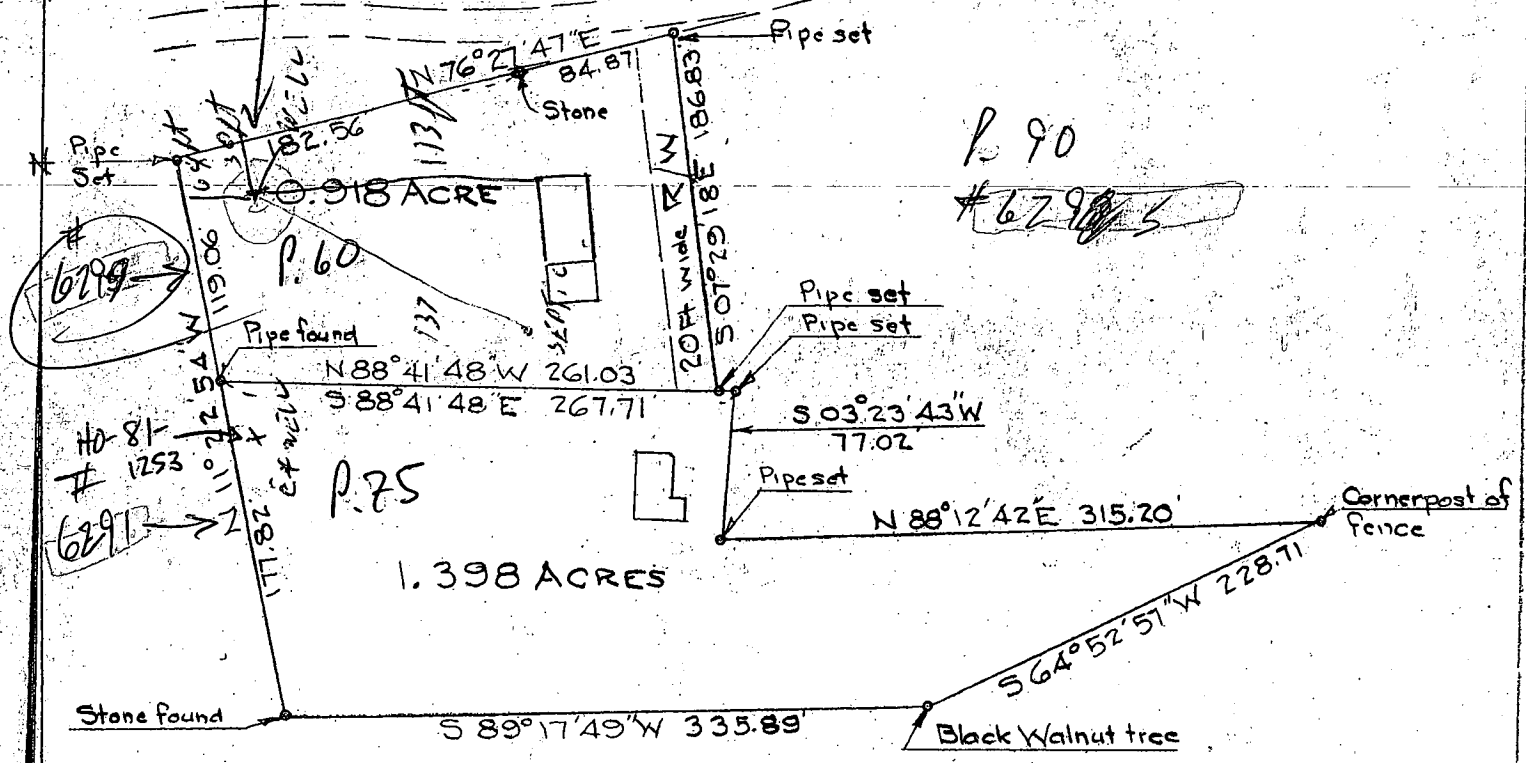


PLAT OF SURVEY
 FOR
 VIRGINIA MEDAIRY
 FIRST ELEC. DIST. HOWARD CO.
 ELKRIDGE, MARYLAND.
 SCALE: 1 IN. = 100 FT. MARCH 4, 1977

- 30
- 64
- 137
- 117

Ho-81-1253


258
 58
 2001

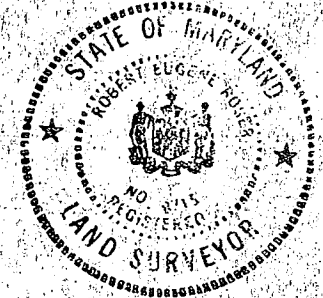

NOTE: HE IS
 CURRENTLY CONNECTED TO
 MOTHER'S WELL ON ADJACENT
 LOT

Robert E. Holes
 A-4059