

6/9/78  
1:30 p.m.

# PERMIT

P 28147  
A 27924

SEWAGE DISPOSAL SYSTEM

MARYLAND STATE DEPARTMENT OF HEALTH\*

HOWARD COUNTY

ELLICOTT CITY

DISTRICT 2nd

INDEXED

DATE 6/5/78

Thompson's Plumbing & Heating IS PERMITTED TO INSTALL \_\_\_\_\_ ALTER X

ADDRESS Ellicott City, Md. PHONE \_\_\_\_\_

SUBDIVISION Frank Peach Property ROAD Church Rd. & Park Drive LOT 1

PROPERTY OWNER Frank Peach

ADDRESS \_\_\_\_\_

SPECIFICATIONS 2 bedrooms

SEPTIC TANK CAPACITY 1000 GALLONS

DRAIN FIELD \_\_\_\_\_ DEPTH \_\_\_\_\_ FEET, BOTTOM AREA \_\_\_\_\_ SQ. FT.

DEEP TRENCH \_\_\_\_\_ DEPTH \_\_\_\_\_ FEET, BOTTOM AREA \_\_\_\_\_ SQ. FT.

SEEPAGE PITS \_\_\_\_\_ ABSORBENT SIDE-WALL AREA \_\_\_\_\_ SQ. FT.

INLET PIPE \_\_\_\_\_ FT. BELOW ORIGINAL GRADE. MAXIMUM DEPTH \_\_\_\_\_ FT. BELOW ORIGINAL GRADE

EFFECTIVE DEPTH AT \_\_\_\_\_ FT. BELOW ORIGINAL GRADE.

LOCATE DISPOSAL AREA \_\_\_\_\_ FT. FROM \_\_\_\_\_ LOT LINE AND \_\_\_\_\_ FT. FROM \_\_\_\_\_ LOT LINE AS SEEN WHEN FACING LOT FROM

REPAIR-CALL FOR INSPECTION WHEN GROUND IS OPENED UP SO SANITARIAN CAN RECOMMEND

REPAIR. 6/9/78 T.S.O. : 1000 gal. S.T., 5' earth buffer, 50' trench, max depth 9', 6' of stone, invert at 3' (shallow as possible)

PLANS APPROVED BY Thomas S. Ogle DATE 6/5/78

COVER NO WORK UNTIL INSPECTED AND APPROVED.

NEITHER THE HOWARD COUNTY COUNCIL NOR THE HEALTH DEPARTMENT IS RESPONSIBLE FOR THE SUCCESSFUL OPERATION OF ANY SYSTEM.

NOTE: IF TRENCH IS USED CALL FOR INSPECTION BEFORE PLACING GRAVEL IN TRENCH.

NOTE: NO DRY WELL SHALL EXCEED 15 FOOT IN DIAMETER.

NOTE: ALL PIPE FROM HOUSE TO DISPOSAL AREA MUST BE CAST IRON.


PERMIT VOID AFTER THREE YEARS.

NOTE: INSTALL STAND PIPE ON SEPTIC TANK AND DRY WELL. STAND PIPES MUST BE 6 INCHES IN DIAMETER. CAST IRON, CONCRETE OR TERRA COTTA ACCEPTED.

BLDG. PERMIT SIGNED  
AND RETURNED 7/28/88  
Serial # 20269  
addition to house

A 27924

\*INSTALLER IS RESPONSIBLE FOR OBTAINING FINAL APPROVAL ON THIS PERMIT.

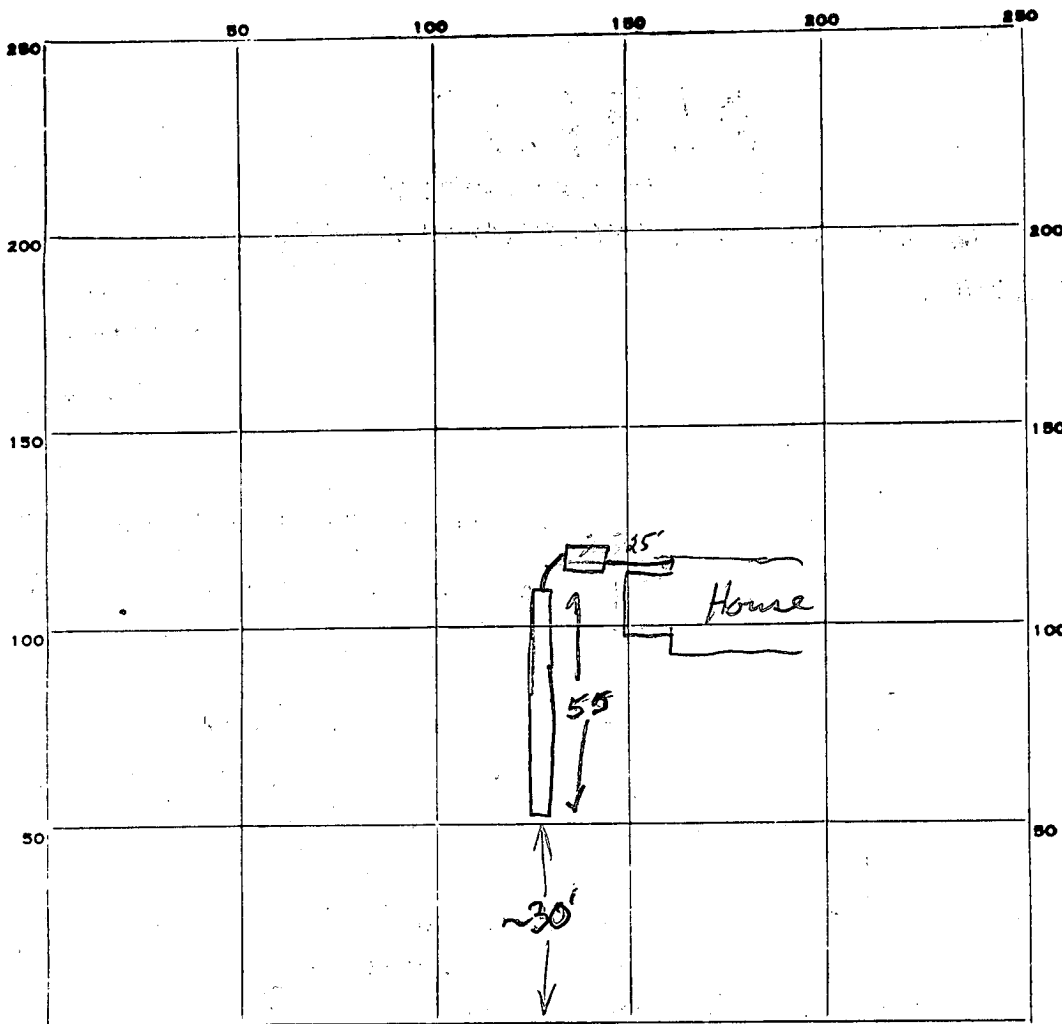

INDICATE NORTH. - NAME ADJOINING ROADWAY AS BASE LINE.

*Church Rd.*

PERMIT CARD

SEPTIC TANK, LEVEL

CLEANOUTS ST

DISTRIBUTION BOX, LEVEL \_\_\_\_\_

TILE FIELD, DEPTH 9 FT. TRENCH WIDTH 2 FT.

GRAVEL DEPTH 6 <sup>ft.</sup> IN. TOTAL LENGTH 55 FT.

NUMBER OF TRENCHES 1 TOTAL BOTTOM AREA 330

SEEPAGE PITS, INSIDE DIAMETER \_\_\_\_\_ FT. DEPTH BELOW INLET \_\_\_\_\_ FT.


ABSORBENT AREA \_\_\_\_\_ SQ. FT.

REMARKS 6/9/78 ESO, OK to gravel trench

DATE SYSTEM APPROVED 6/21/78

INSPECTOR T. S. DeJ

A27924

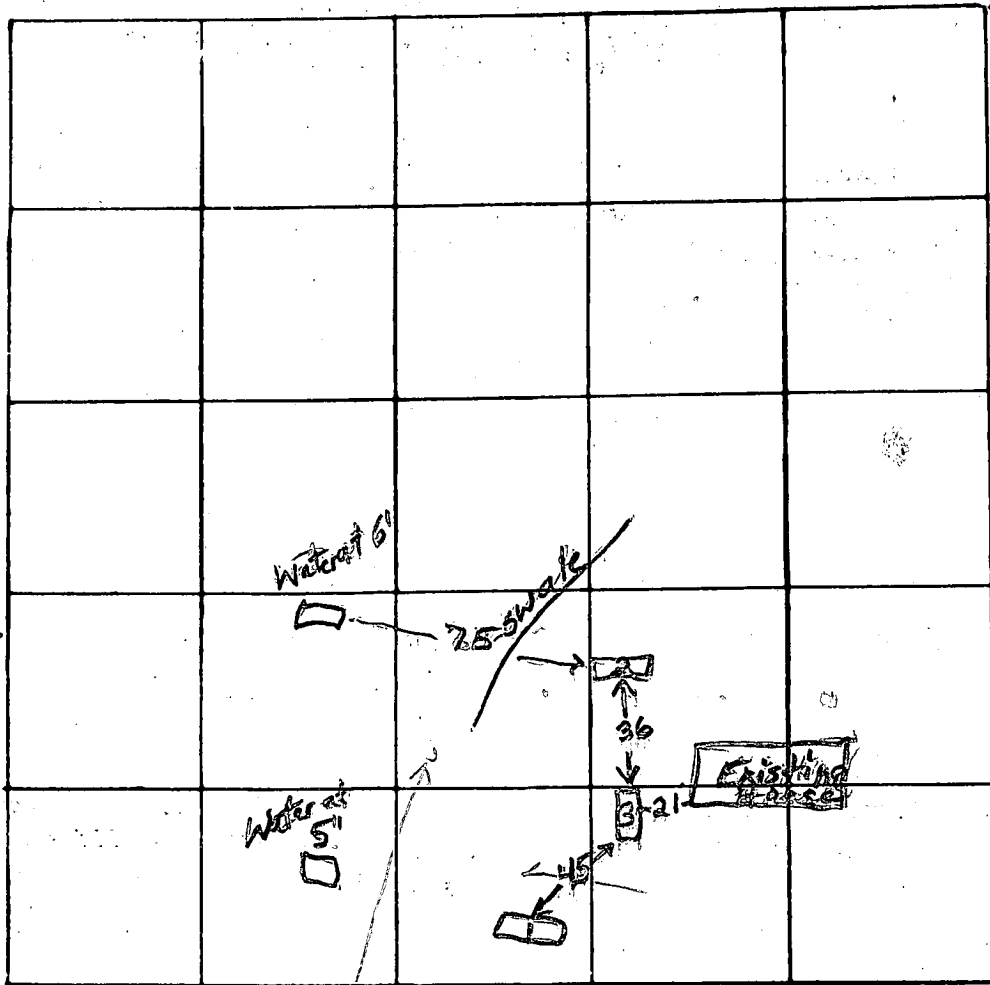

Park 50  
6  
22  
6  

---

132  
132  

---

264

INDICATE NORTH. NAME ADJOINING ROADWAY AS BASE LINE

Church Lane

DATE	TEST NO.	DEPTH	PRE-WET		TEST - 1" DROP		TIME
			START	STOP	START	STOP	
5/5/78	1s	3 1/2	0939	1010	1st inch not out		
	1d	8 1/2	0939	0944	0944	0947	3
	2s	3 1/2	1003	1038	1st inch not out		
	2d	7	1004			1013	3-4 1/2 min. avg
	3s	3 1/2	1024	1030	1030	1046	16
	3d	11'	1022	1052	1st inch not out		
	3d2	8	1107	1110	1110	1119	9

nearest Road  
down Corn 3  
Near side 1. road

X  
X  
9 total

REMARKS \_\_\_\_\_

TYPE OF SOIL \_\_\_\_\_


TESTED BY Tom Oyle ALSO PRESENT: Dave Thompson

**JAMES M. BEATTY & SONS, INC.**

3129 GREENWAY DRIVE  
ELLICOTT CITY, MD. 21043

301-461-3287  
301-465-2298

Access Strip  
LINWOOD CHILDRENS FARM INC.

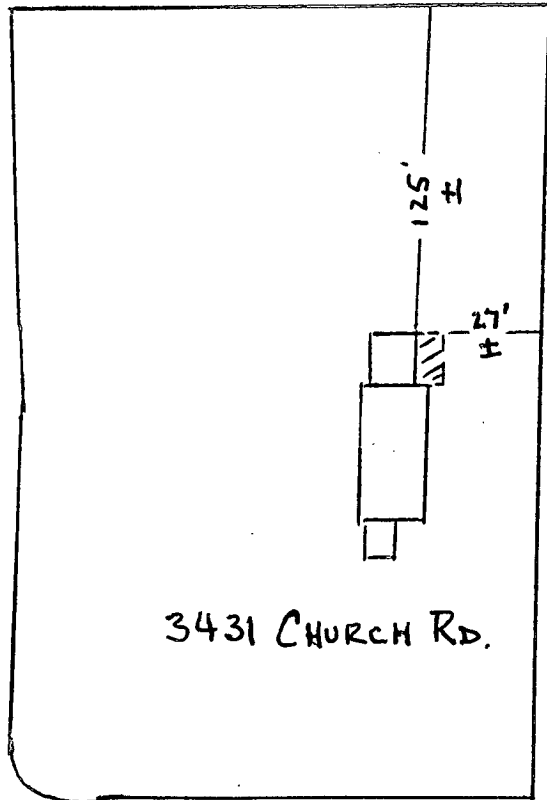

3431 CHURCH RD.

PARK DRIVE

CHURCH ROAD

7/28/88  
OK TO SIGN  
RIT