

6/19/78
T.S.P. m.

PERMIT

P 28146
A 27926

SEWAGE DISPOSAL SYSTEM

MARYLAND STATE DEPARTMENT OF HEALTH*

HOWARD COUNTY

02-266437

ELLICOTT CITY

DISTRICT 2nd

DATE 6/5/78

INDEXED

Thompson's Plumbing & Heating IS PERMITTED TO INSTALL ALTER X

ADDRESS _____ PHONE _____

SUBDIVISION Frank Peach Property ROAD 8390 Church Rd. & Park Drive LOT 03

PROPERTY OWNER Frank Peach

ADDRESS _____

SPECIFICATIONS 2 or 3 bedrooms

SEPTIC TANK CAPACITY 1000 GALLONS

DRAIN FIELD _____ DEPTH _____ FEET, BOTTOM AREA _____ SQ. FT.

DEEP TRENCH _____ DEPTH _____ FEET, BOTTOM AREA _____ SQ. FT.

SEEPAGE PITS _____ ABSORBENT SIDE-WALL AREA _____ SQ. FT.

INLET PIPE _____ FT. BELOW ORIGINAL GRADE. MAXIMUM DEPTH _____ FT. BELOW ORIGINAL GRADE

EFFECTIVE DEPTH AT _____ FT. BELOW ORIGINAL GRADE.

LOCATE DISPOSAL AREA _____ FT. FROM _____ LOT LINE AND _____ FT. FROM _____ LOT LINE AS SEEN WHEN FACING LOT FROM

REPAIR-CALL FOR INSPECTION WHEN GROUND IS OPENED UP SO SANITARIAN CAN RECOMMEND

REPAIR. 60' trench, max depth 89", invert 4". have pipe entering trench as shallow as possible.

PLANS APPROVED BY T.S. Ogle DATE 6/5/78

COVER NO WORK UNTIL INSPECTED AND APPROVED.

NEITHER THE HOWARD COUNTY COUNCIL NOR THE HEALTH DEPARTMENT IS RESPONSIBLE FOR THE SUCCESSFUL OPERATION OF ANY SYSTEM.

NOTE: IF TRENCH IS USED CALL FOR INSPECTION BEFORE PLACING GRAVEL IN TRENCH.

NOTE: NO DRY WELL SHALL EXCEED 15 FOOT IN DIAMETER.

NOTE: ALL PIPE FROM HOUSE TO DISPOSAL AREA MUST BE CAST IRON.


PERMIT VOID AFTER THREE YEARS.

NOTE: INSTALL STAND PIPE ON SEPTIC TANK AND DRY WELL. STAND PIPES MUST BE 6 INCHES IN DIAMETER. CAST IRON, CONCRETE OR TERRAZO ACCEPTED.

BUDG. PERMIT SIGNED AND RETURNED 6/14/78
Serial # 23306
Stay additional

A 27926

*INSTALLER IS RESPONSIBLE FOR OBTAINING FINAL APPROVAL ON THIS PERMIT.

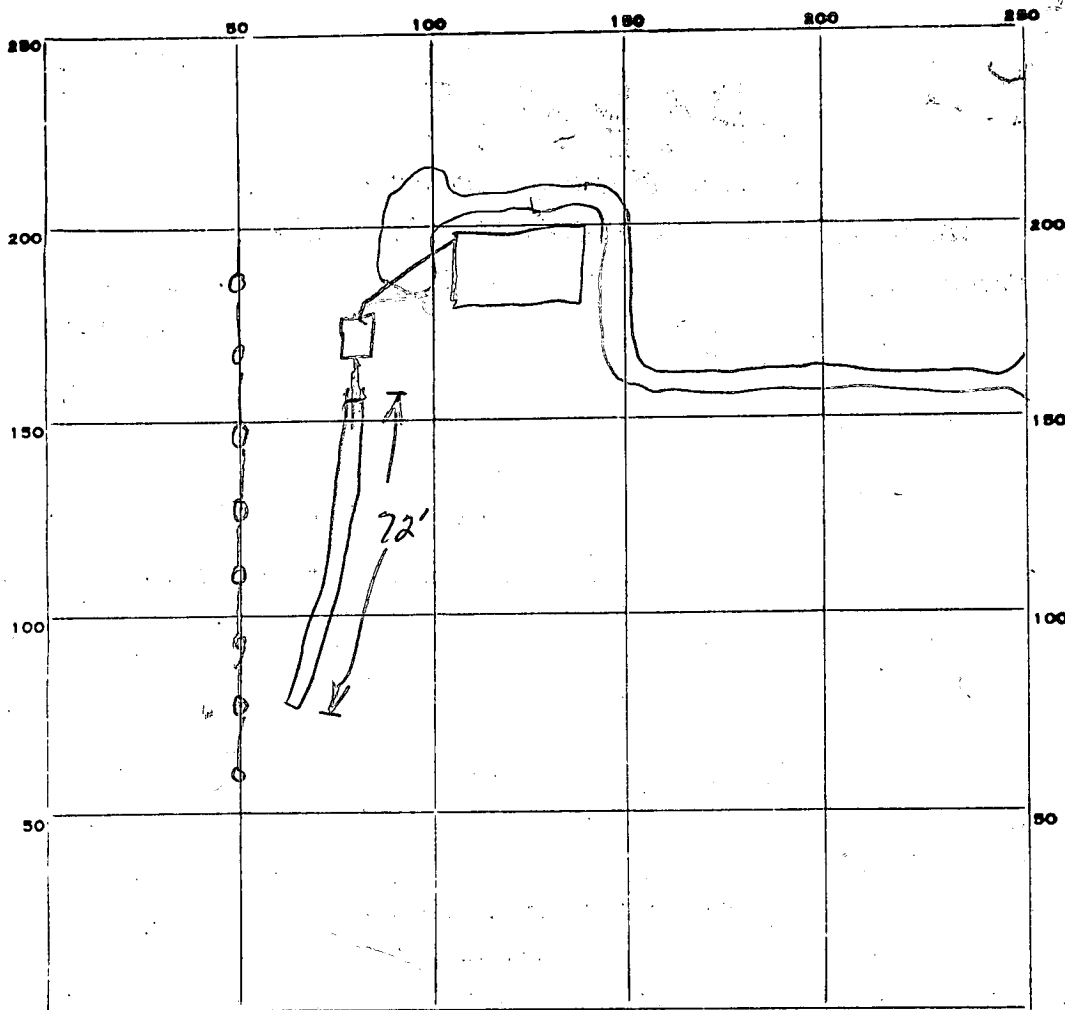

INDICATE NORTH. - NAME ADJOINING ROADWAY AS BASE LINE.

Church Rd.


Park Dr

PERMIT CARD _____
 SEPTIC TANK, LEVEL _____ CLEANOUTS 5T _____
 DISTRIBUTION BOX, LEVEL _____
 TILE FIELD, DEPTH 9 FT. TRENCH WIDTH 2 FT.
 GRAVEL DEPTH 5 ^{ft.}/_{in.} TOTAL LENGTH 72' FT.
 NUMBER OF TRENCHES 1 TOTAL BOTTOM AREA 360
 SEEPAGE PITS, INSIDE DIAMETER _____ FT. DEPTH BELOW INLET _____ FT.
 ABSORBENT AREA _____ SQ. FT.

REMARKS 6/9/78 TSO: OK to gravel trench.
6/21/78 TSO: OK to backfill trench & tank.
Call for final when construction made to house.
Done TSO.

DATE SYSTEM APPROVED 6/21/78 INSPECTOR T. S. O'Connell

Repair Permit for Lot #3. OK TSO 6/22/78

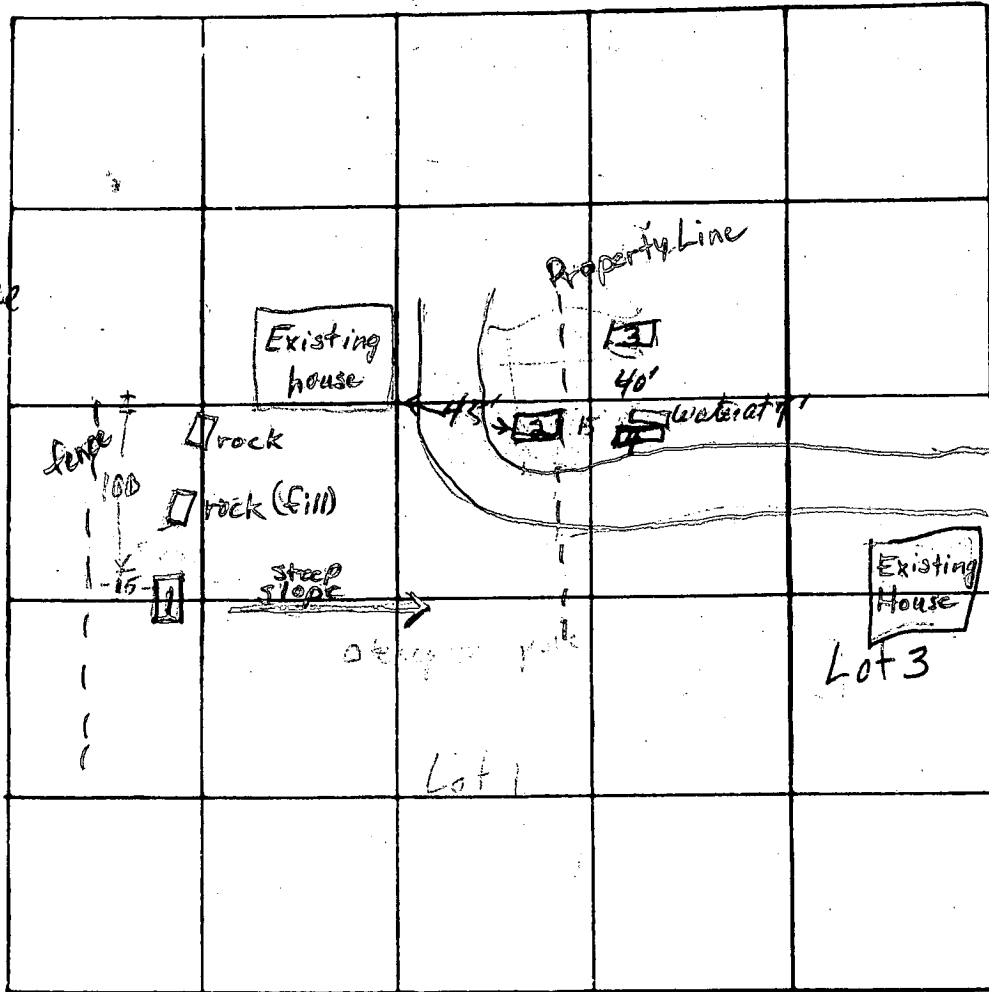

A27926

Park

INDICATE NORTH - NAME ADJOINING ROADWAY AS BASE LINE
Church

DATE	TEST NO.	DEPTH	PRE-WET		TEST - 1" DROP		TIME
			START	STOP	START	STOP	
7/5/78	1s	4	1133	1140	1140	1145	5
	1d	10	1131	1138	1138	1145	7
	2s	3	1200	1203	1203	1207	4
	2d	11	1158	1215	No Movement		
	2d ₂	7	1226	1227	1227	1230	3
	3s	3	1305	1313	1313	1328	15
	3d	4 1/2	1306	1307	1307	1319	12
	4s	3	1342	shelf caved in			
	4d	6 1/2	1339	1343	1343	1346	3
	4s ₂	3	1345	1349	1349	1356	7

REMARKS _____

TYPE OF SOIL _____

TESTED BY _____ ALSO PRESENT: _____

20x20'
2' 5"
3' stone
inlet 2'
max depth 5
20x40
1 1/2' stone
3/2

20
40
26
800

20
20
400

120
K

27
15
135
27
105

32
M


BP 23274

2/7/89

Called Public Sewer Nat yet
applied trust petition
by be included in
metropolitan District
Trust

2/9/89 - Jo Ann Davis 9922400

talked to Gary
Sud went to site to meet
Field Inspector today

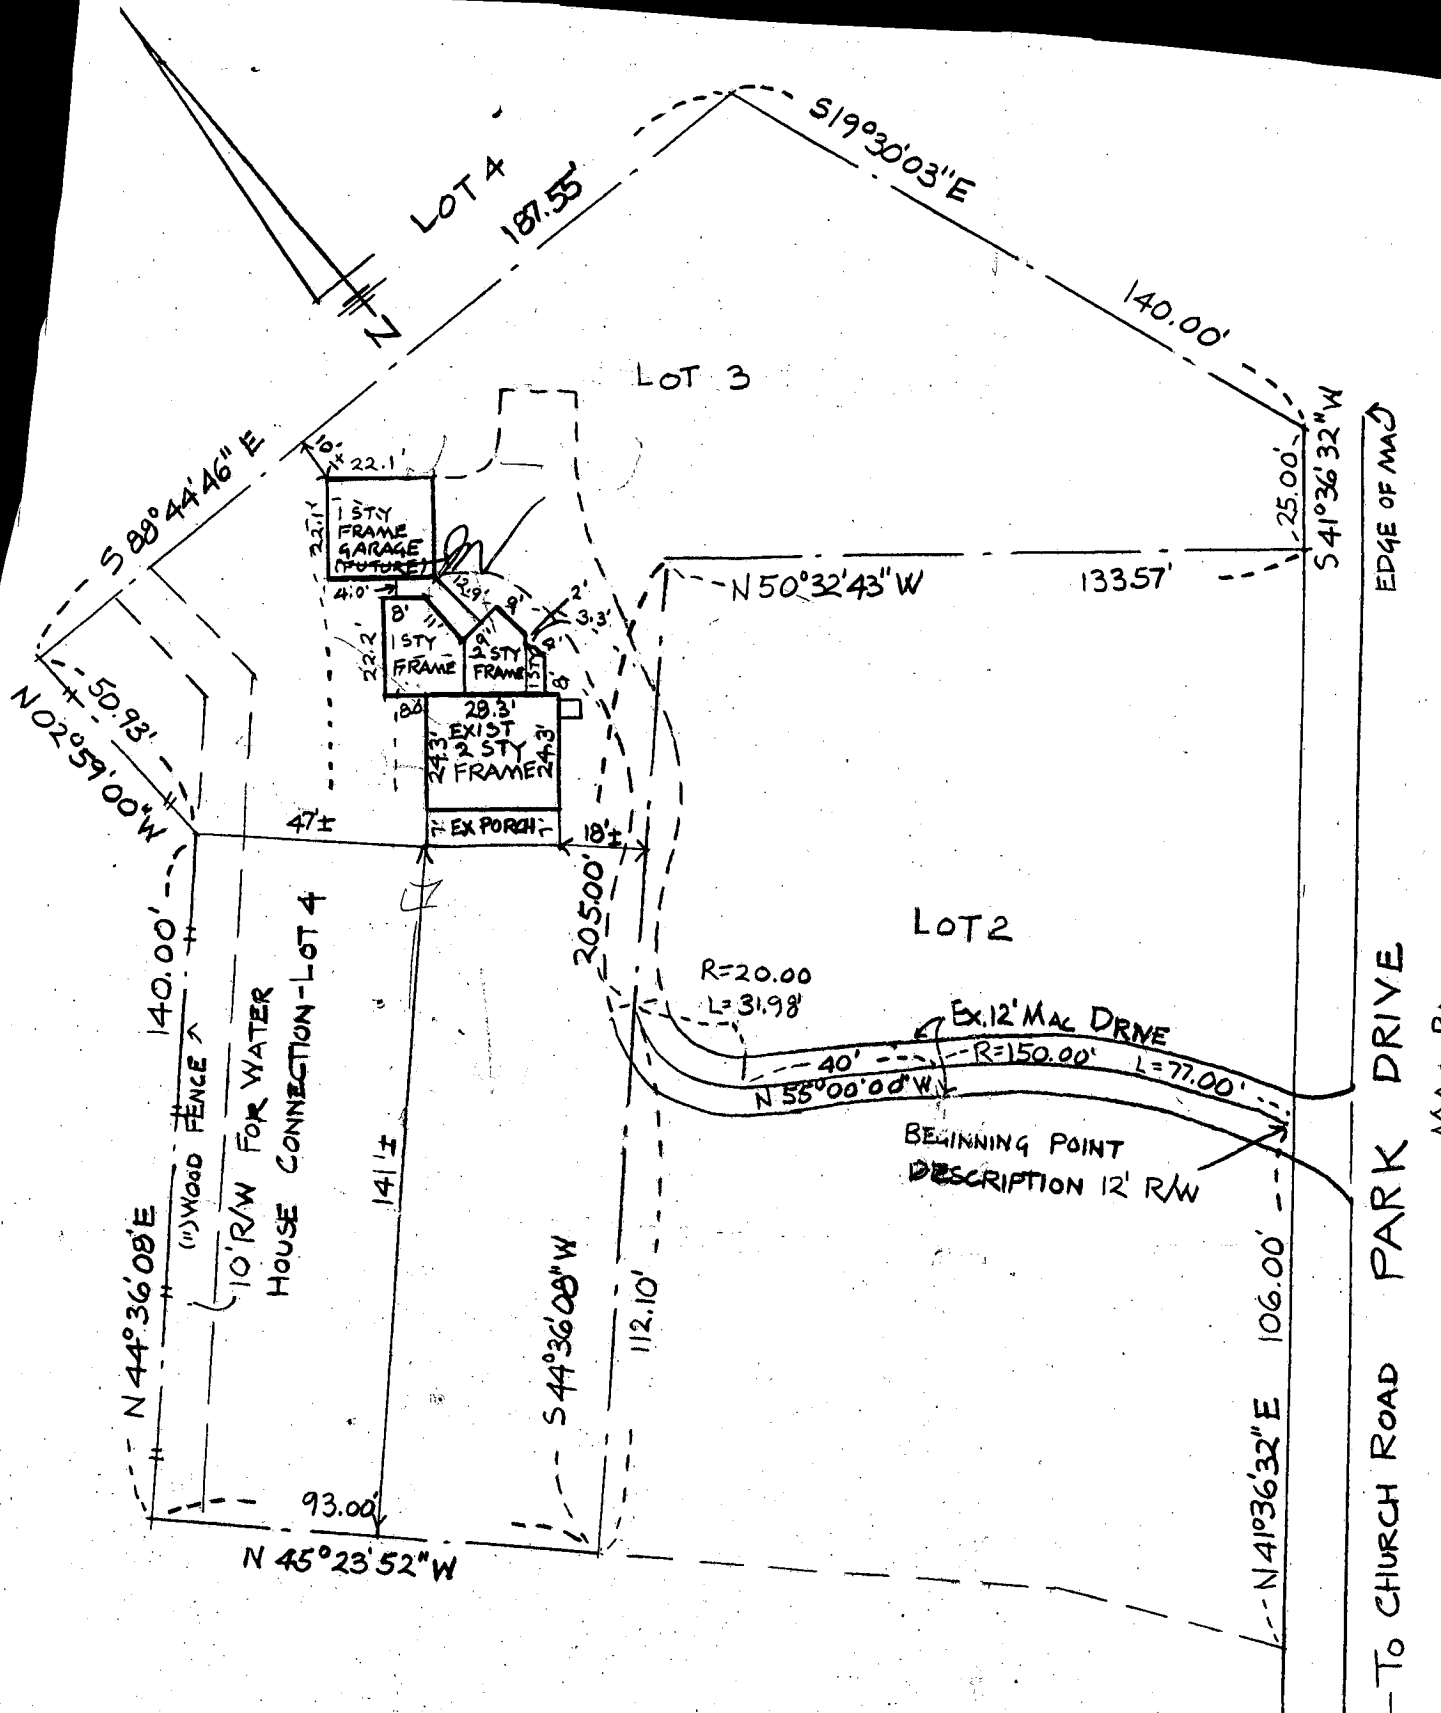

PLOT PLAN

SCALE 1" = 40'

#8390 CHURCH ROAD

HOWARD CO. PLAT CMP#4134
FILE 5566

2/24/89

VISITED SITE
CITY WATER
NO PROBLEM
OK TO SIGN

RH

← TO CHURCH ROAD PARK DRIVE
MAC PAVING
EDGE OF MAC