

~~10/26/77~~
~~10/28/77~~
10/28/77
a.m. & p.m. if possible

10/31/77
P.C.O. c.s.d.
P 27105
A Repair
D.F.C. 0
c.s.d.

PERMIT File

SEWAGE DISPOSAL SYSTEM

MARYLAND STATE DEPARTMENT OF HEALTH

HOWARD COUNTY

03-295514

ELLICOTT CITY

DISTRICT _____

DATE 10/26/77

INDEXED

Mr. Brittingham

IS PERMITTED TO INSTALL _____ ALTER X

ADDRESS Ellicott City, Md.

PHONE _____

A SEWAGE DISPOSAL SYSTEM LOCATED AT _____

SUBDIVISION Burntwoods

ROAD 13994 Burntwoods Road

LOT 2D

PROPERTY OWNER Mrs. Scrivnor

ADDRESS same as above

SPECIFICATIONS

DRAIN FIELD _____ DEPTH _____ FEET, BOTTOM AREA _____ SQ. FT.

SEEPAGE PITS _____ ABSORBENT SIDE-WALL AREA _____ SQ. FT.

SEPTIC TANK CAPACITY _____ GALLONS

FOR GARBAGE GRINDER, INCREASE DISPOSAL AREA 22% & TANK CAPACITY 50%.

OTHER REPAIR-CALL FOR INSPECTION WHEN GROUND IS OPENED UP SO SANITARIAN CAN

RECOMMEND REPAIR.

60' Turned 6' stone - Keep 75' away
From neighbors well, 10' From prop line and ex system 10/24
10/26/77


PLANS APPROVED BY Palmer F. Wine

DATE 10/26/77

FILL SEPTIC TANK AND DISTRIBUTION BOX WITH WATER BEFORE CALLING FOR AN INSPECTION. COVER NO WORK UNTIL INSPECTED AND APPROVED.

NEITHER THE HOWARD COUNTY COMMISSIONERS NOR THE HEALTH DEPARTMENT IS RESPONSIBLE FOR THE SUCCESSFUL OPERATION OF ANY SYSTEM.

P 27105

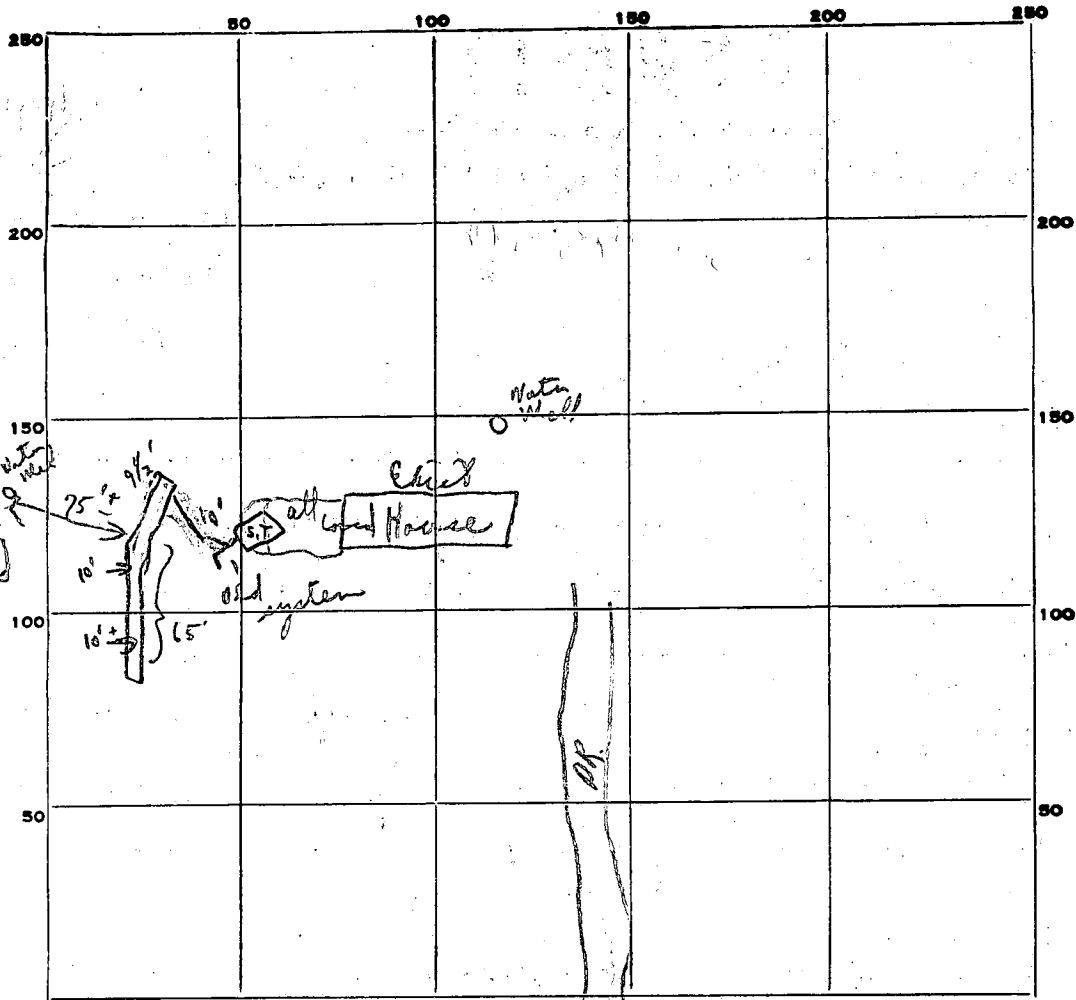

INDICATE NORTH. - NAME ADJOINING ROADWAY AS BASE LINE.

PERMIT CARD Not seen

SEPTIC TANK, LEVEL N/A CLEANOUTS ST O.W. OK / N/A

DISTRIBUTION BOX, LEVEL N/A

TILE FIELD, DEPTH 9 1/2 - 10 1/4 FT. TRENCH WIDTH FT.

GRAVEL DEPTH 6' - 6 1/2' IN. TOTAL LENGTH 65' FT.

NUMBER OF TRENCHES 1 TOTAL BOTTOM AREA

SEEPAGE PITS, INSIDE DIAMETER FT. DEPTH BELOW INLET FT.

ABSORBENT AREA 390 + SQ. FT.

REMARKS 10/31/77 OK for gravel; saw 10' cast iron + cement
c/Iron to old system + new pipes. ok to cover to trench
OK gravel + pipes on to 2-2 1/2' from surface. c.B.A.

DATE SYSTEM APPROVED 10/31/77 INSPECTOR C. B. [Signature]