

4/17/77
11/8/77

PERMIT

Approved
11/13/78
(ex post facto)
T.S.D.

P 27207
A

SEWAGE DISPOSAL SYSTEM

MARYLAND STATE DEPARTMENT OF HEALTH

HOWARD COUNTY

05-365058

ELLICOTT CITY

INDEXED

DISTRICT 5TH

DATE 11/10/77

~~Patrick J. Rogan~~ Howard Edwards IS PERMITTED TO INSTALL ALTER X

ADDRESS 6706 Mink Hollow Road, Highland, Md. 20777 PHONE 596-5391

A SEWAGE DISPOSAL SYSTEM LOCATED AT _____

SUBDIVISION Green Hill Manor ROAD 6706 Mink Hollow Road LOT 12, blk A

PROPERTY OWNER Patrick J. Rogan

ADDRESS same as above

SPECIFICATIONS

DRAIN FIELD _____ DEPTH _____ FEET, BOTTOM AREA _____ SQ. FT.

SEEPAGE PITS _____ ABSORBENT SIDE-WALL AREA _____ SQ. FT.

SEPTIC TANK CAPACITY _____ GALLONS

FOR GARBAGE GRINDER, INCREASE DISPOSAL AREA 22% & TANK CAPACITY 50%.


OTHER REPAIR - Call for inspection when ground is opened up and Sanitarian will recommend repair system.

PLANS APPROVED BY Palmer F. Wine DATE 11/10/77

FILL SEPTIC TANK AND DISTRIBUTION BOX WITH WATER BEFORE CALLING FOR AN INSPECTION. COVER NO WORK UNTIL INSPECTED AND APPROVED.

NEITHER THE HOWARD COUNTY COMMISSIONERS NOR THE HEALTH DEPARTMENT IS RESPONSIBLE FOR THE SUCCESSFUL OPERATION OF ANY SYSTEM.

27207

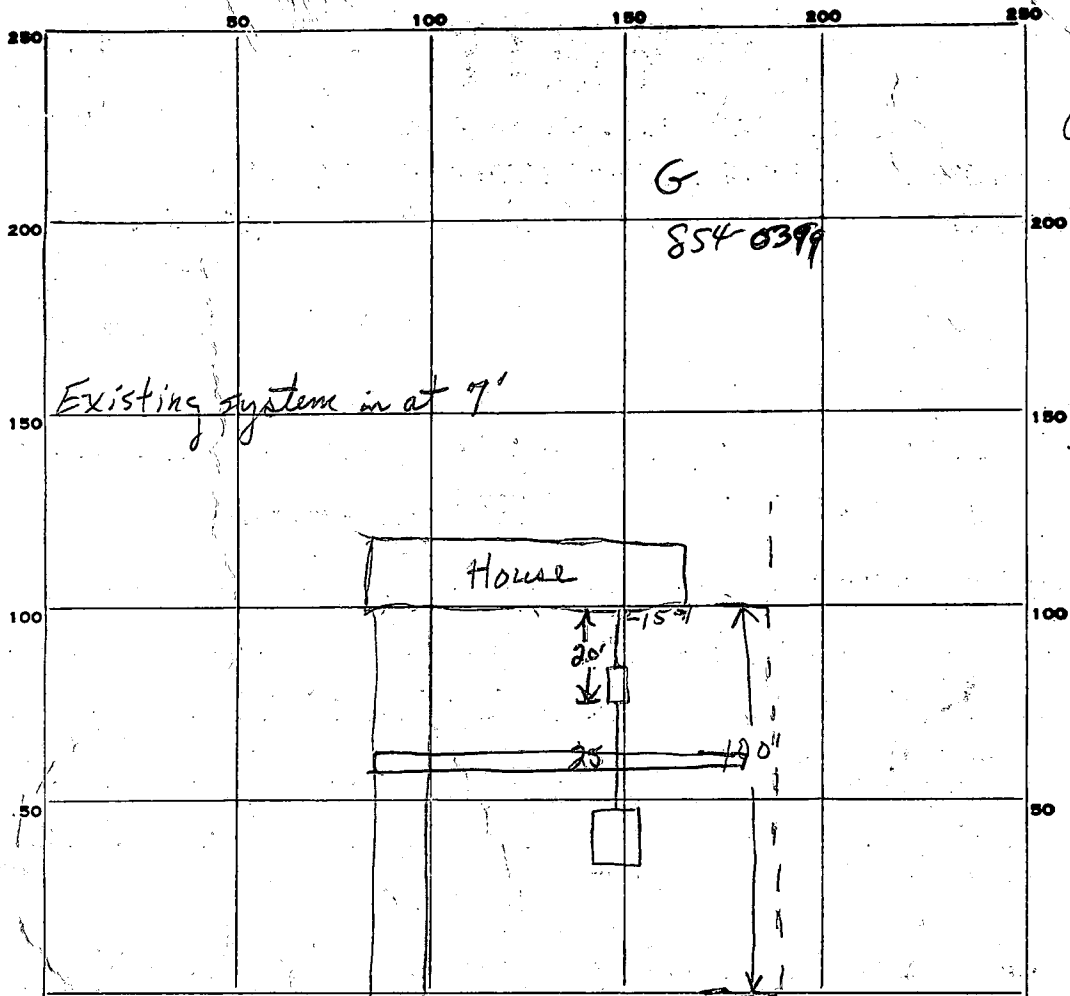

Green Hill Manor
Lot 12

G
854 0399

Existing system in at 7'

INDICATE NORTH. - NAME ADJOINING ROADWAY AS BASE LINE.
Mink Hollow Road

PERMIT CARD _____

SEPTIC TANK, LEVEL _____ CLEANOUTS _____

DISTRIBUTION BOX, LEVEL _____

TILE FIELD, DEPTH _____ FT. TRENCH WIDTH _____ FT.

GRAVEL DEPTH 3' IN. TOTAL LENGTH 81 FT. ← o'Neill?

NUMBER OF TRENCHES 1 TOTAL BOTTOM AREA 567

SEEPAGE PITS, INSIDE DIAMETER _____ FT. DEPTH BELOW INLET _____ FT.

ABSORBENT AREA _____ SQ. FT.

REMARKS Trench 75' between ST & DW, parallel to house;
T/C w/ Howard Edwards: take trench to 14' if possible & call
for trench insp.

DATE SYSTEM APPROVED 1/13/78 INSPECTOR T.S. O'Jp