

4/25/78  
4/15/78

File

P 27713  
A Repair

# PERMIT

SEWAGE DISPOSAL SYSTEM

MARYLAND STATE DEPARTMENT OF HEALTH\*

HOWARD COUNTY

05-373778

ELLCOTT CITY

DISTRICT \_\_\_\_\_

INDEXED

DATE 3/27/78

William Sterling IS PERMITTED TO INSTALL ALTER

ADDRESS 13760 Nichols Drive, Clarksville, Md. PHONE 286-3473

SUBDIVISION \_\_\_\_\_ ROAD 13760 Nichols Drive LOT \_\_\_\_\_

PROPERTY OWNER William & Geneva Sterling

ADDRESS same as above

SPECIFICATIONS 2 bedrooms

SEPTIC TANK CAPACITY 1000 GALLONS

DRAIN FIELD \_\_\_\_\_ DEPTH \_\_\_\_\_ FEET. BOTTOM AREA \_\_\_\_\_ SQ. FT.

DEEP TRENCH \_\_\_\_\_ DEPTH \_\_\_\_\_ FEET. BOTTOM AREA \_\_\_\_\_ SQ. FT.

SEEPAGE PITS \_\_\_\_\_ ABSORBENT SIDE-WALL AREA \_\_\_\_\_ SQ. FT.

INLET PIPE \_\_\_\_\_ FT. BELOW ORIGINAL GRADE. MAXIMUM DEPTH \_\_\_\_\_ FT. BELOW ORIGINAL GRADE

EFFECTIVE DEPTH AT \_\_\_\_\_ FT. BELOW ORIGINAL GRADE.

LOCATE DISPOSAL AREA \_\_\_\_\_ FT. FROM \_\_\_\_\_ LOT LINE AND \_\_\_\_\_ FT. FROM \_\_\_\_\_ LOT LINE AS SEEN WHEN FACING LOT FROM

BLDG. PERMIT SIGNED  
AND RETURNED 4/3/78  
Serial No. 35088  
Addition to house

REPAIR-CALL FOR INSPECTION WHEN GROUND IS OPENED UP SO SANITARIAN CAN RECOMMEND

REPAIR. (Need to inspect cast iron from house to septic tank) P.W.M. + C.B.A.

PLANS APPROVED BY Palmer F. Wine DATE 3/27/78

COVER NO WORK UNTIL INSPECTED AND APPROVED.

NEITHER THE HOWARD COUNTY COUNCIL NOR THE HEALTH DEPARTMENT IS RESPONSIBLE FOR THE SUCCESSFUL OPERATION OF ANY SYSTEM.

NOTE: IF TRENCH IS USED CALL FOR INSPECTION BEFORE PLACING GRAVEL IN TRENCH.

NOTE: NO DRY WELL SHALL EXCEED 15 FOOT IN DIAMETER.


NOTE: ALL PIPE FROM HOUSE TO DISPOSAL AREA MUST BE CAST IRON.

PERMIT VOID AFTER THREE YEARS.

NOTE: INSTALL STAND PIPE ON SEPTIC TANK AND DRY WELL. STAND PIPES MUST BE 6 INCHES IN DIAMETER. CAST IRON, CONCRETE OR TERRA COTTA ACCEPTED.

\*INSTALLER IS RESPONSIBLE FOR OBTAINING FINAL APPROVAL ON THIS PERMIT.

P27713

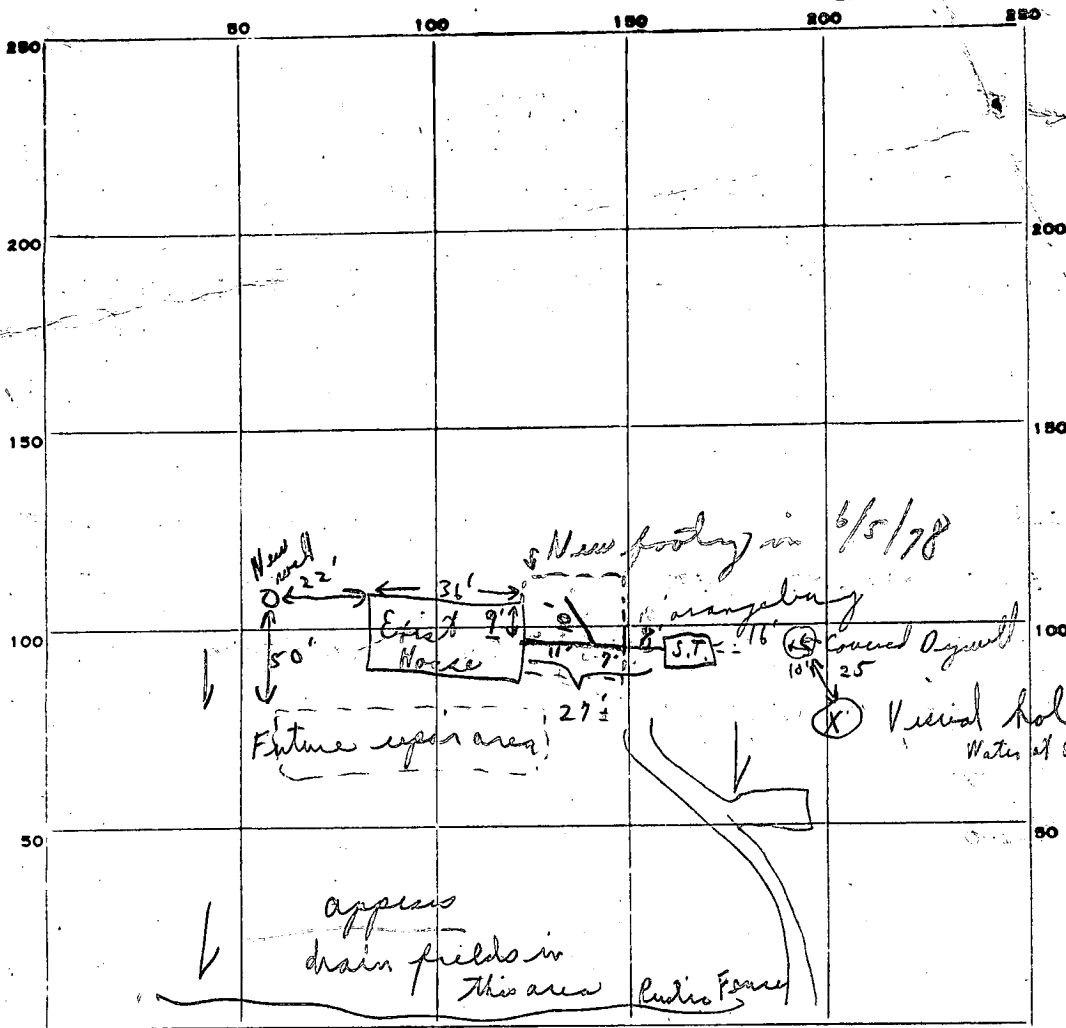

Quarry  
 ← Property Line →

sandy loam  
 to  
 Hole 11' originally  
 Water 5 1/2' of grade  
 4/25/78  
 Mr. Sterling

INDICATE NORTH - NAME ADJOINING ROADWAY AS BASE LINE.

PERMIT CARD \_\_\_\_\_ (ye 6/5/78) \_\_\_\_\_

SEPTIC TANK, LEVEL \_\_\_\_\_ N/A \_\_\_\_\_ CLEANOUTS \_\_\_\_\_ N/A N/A \_\_\_\_\_

DISTRIBUTION BOX, LEVEL \_\_\_\_\_

TILE FIELD, DEPTH \_\_\_\_\_ FT. TRENCH WIDTH \_\_\_\_\_ FT.

GRAVEL DEPTH \_\_\_\_\_ IN. TOTAL LENGTH \_\_\_\_\_ FT.

NUMBER OF TRENCHES \_\_\_\_\_ TOTAL BOTTOM AREA \_\_\_\_\_

SEEPAGE PITS, INSIDE DIAMETER \_\_\_\_\_ FT. DEPTH BELOW INLET \_\_\_\_\_ FT.

ABSORBENT AREA \_\_\_\_\_ SQ. FT.

REMARKS ① Saw cast iron pipe at house; ② Orangelburg at + from septic tank closest to house; ③ 11' Recommend replace pipe from house to tanks with all cast iron, hold for Mr. Monaghan - he agrees call + explain ok to put addition on - if replaces, pipes with cast iron. 6/5/78 all cast iron from house to septic tanks 6/5/78 pipes above footing & term of check. closer

DATE SYSTEM APPROVED \_\_\_\_\_ 6/5/78 \_\_\_\_\_ INSPECTOR C. B. Stricker

Division of Environmental Health

3450 Court House Drive

Ellicott City, Maryland

Tel: 465-5000, Ext. 356

DATE:

3/20/78; 3/22/78 see below (3/23/78 see back)

TO:

- MD. STATE DEPT. OF HEALTH
- COUNTY EXECUTIVE
- DEPT. OF PUBLIC WORKS
- BUREAU OF WATER & SEWERS
- OTHERS: ① D.W.M.
- BOARD OF EDUCATION
- OFFICE OF PLANNING & ZONING
- DIVISION OF LAND DEVELOPMENT
- BUILDING ENGINEER
- BUREAU OF LICENSES, INSPECTION & PERMITS

RE: Nichols D-13760 (House addition)

- The above referenced:
- Final Plat
  - Preliminary Plat
  - Site Development Plan
  - Building Plans
  - Other:

SI:

- Approved
- Disapproved
- Approved, if public water and sewerage are provided.
- Approved, provided State Health Department notifies the Health Officer that he can sign the plat or bldg. permit.
- May the Health Officer sign the above referenced plat?

COMMENTS:

Others: { on hold } for your review & see field sheet notes. reassessments - please

- Preliminary plat needs revising.
- Final plat needs revising.
- Request that Engineer come to this office for conference.
- Submit completed Food Establishment check list.
- Percolation tests not performed.
- State Subdivision Regulations not complied with.
- Submit complete plans and specifications.
- See attached Regulations or literature.

OTHER COMMENTS:

3/20/78 Referred to Mr. Monaghan - see above

① comments; ② house plans; ③ field sheet. If any questions or anything not clear - I shall be glad to answer any questions - E.C.A.

3/22/78 300 sq ft. <sup>additional</sup> trench <sup>in</sup> other needed for <sup>area</sup> per F.P. + D.W.M. + E.B.D. **Signed:**

Permit to be released - subject to above being completed after over

3/22/78 release of permit per F.F. + D.W.M.

C.B.D. - Called - home in A.M. of Sterling - busy.

3/22/78 Called in P.M. Busy - discussed further with Mr.

Frommelt's Note - need to have repair permit - visual hole  
(\*) + we shall recommend trench depth + length after  
seeing soil. C.B.D.

3/23/78 Called in A.M. - <sup>twice</sup> rang for a long time - busy - hold  
& call as soon as possible. C.B.D.

Called P.M. daughter

Tena - home

Called 593-9600 Jenny Sterling

Spoke to Mrs Sterling - relayed info. that  
they would need a permit for repair. She  
is to have her husband call us.

Husband called - explained to husband about the security  
of a permit for repair (addition to system to  
compensate for new rooms)

He is to come in for permit when he picks  
up Bldg Permit. Hold for permit  
pick up.

3/27/78 Permit taken out per P 27713 A Repair  
seen 4/3/78. C.B.D.

4/3/78 Referred to D.W.M. for his approval.  
C.B.D.

Field sheet

On Hold ↓ see below

(C.B.D.)  
3/14/78

FILE Septic System inspection DATE REPORTED 3-13-78

PROPERTY OWNER Mr. Starling

P.O. ADDRESS 13760 Nichols Dr. TELEPHONE \_\_\_\_\_

DIRECTIONS TO PROPERTY off Brighton Dam Rd. opp. quarry, 1<sup>st</sup> house on left

INFORMANT owner home till 2<sup>PM</sup> this week

for addition to house

3/15/78 - No record of septic system in our files /hs

CONDITION FOUND 3/14/78 see other side; owner showed sanitation where septic system was located. No copy of system with this inquiry. (No apparent overflow.)

all clean out, covered this date.

No overflow noted ✓ hold for drawing from owner. }  
ACTION TAKEN Mr. Starling home! }  
check ✓

3/20/78 Referred drawing & plans to Mr. Monaghan to decide on future action - please note a bath is to be in new addition Mr. Monaghan.  
C.B.D.

FINAL DISPOSITION \_\_\_\_\_

Brighton Dam Road

Steep


New  
Water  
Well


House

of the  
C.B.W. apparently  
the area

all covered at time  
of inspection

Nichols Dr.

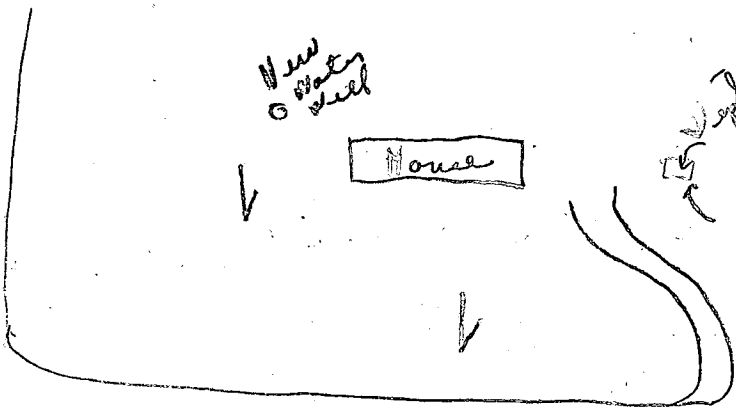

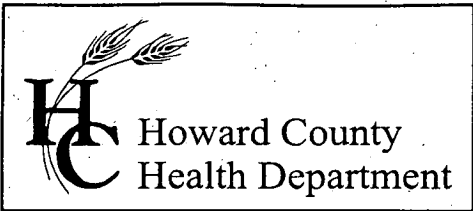

3525 H Ellicott Mills Drive, Ellicott City, MD 21043  
 (410) 313-2640 Fax (410) 313-2648  
 TDD (410) 313-2323 Toll Free 1-866-313-6300  
 website: www.hchealth.org

Penny E. Borenstein, M.D., M.P.H., Health Officer

**PUBLIC INFORMATION ACT REQUEST**

<b>Property Information:</b>		County # <u>HOWARD</u>
Current Owner's Name	<u>13760 NICHOLS LA</u> Property Address	
	<u>CLARKSVILLE MD</u>	
Subdivision	Lot #	
All Prior Owner's Name's (if requested or known)	Tax Map	Parcel #

**Requested Records:** (Please check appropriate items)

- COMPLETE LOT FILE
- SEPTIC CONSTRUCTION PLAN
- WELL & SEPTIC LOCATION
- OTHER (specify) \_\_\_\_\_
- PERCOLATION TEST APP (includes test notes)
- WELL COMPLETION REPORT
- WELL SAMPLING RESULTS

**Pick-up OR**  
 **MAIL RECORDS to NAME** \_\_\_\_\_  
**ADDRESS** \_\_\_\_\_  
**CITY, ST, ZIP** \_\_\_\_\_

I understand that I will be charged \$ .60 per page copied. If staff time in record retrieval takes more than two (2) hours, then a fee of \$25.00 per hour after two (2) hours will be assessed. Also, I do understand that I will not be able to request any proprietary information enclosed in the file and all copies larger than 11"x17" may best be provided by the proprietor of the document. I also realize that it may take up to thirty (30) days to process this request.

ROBERT A. RIDOLFI  
 Applicant Name (please print)  
[Signature]  
 Applicant Signature

301-854-0124  
 Applicant Phone Number  
6-8-04  
 Date

_____ Date Received	<b>FOR OFFICE USE ONLY</b>	_____ # of Copies Made
_____ No Record Found	_____ Date Completed	_____ Staff Initials
	_____ Preparation Time	