

Approved
6/9/79
T.S.D.

P. 27763

PERMIT

A REPAIR

SEWAGE DISPOSAL SYSTEM

MARYLAND STATE DEPARTMENT OF HEALTH*

HOWARD COUNTY

ELLICOTT CITY

INDEXED

DISTRICT _____

06-432050

DATE 4/5/78

Mr. Coneil Donald Parlette IS PERMITTED TO INSTALL _____ ALTER X

ADDRESS Berger Road, Columbia, Md. PHONE _____

SUBDIVISION _____ ROAD 9212 Berger Road LOT _____

PROPERTY OWNER Mr. Phillip Thompson

ADDRESS 9212 Berger Road, Columbia, Md.

SPECIFICATIONS 5 bedrooms

SEPTIC TANK CAPACITY 1500 GALLONS

DRAIN FIELD _____ DEPTH _____ FEET. BOTTOM AREA _____ SQ. FT.

DEEP TRENCH _____ DEPTH _____ FEET. BOTTOM AREA _____ SQ. FT.

SEEPAGE PITS _____ ABSORBENT SIDE-WALL AREA _____ SQ. FT.

INLET PIPE _____ FT. BELOW ORIGINAL GRADE. MAXIMUM DEPTH _____ FT. BELOW ORIGINAL GRADE

EFFECTIVE DEPTH AT _____ FT. BELOW ORIGINAL GRADE.

LOCATE DISPOSAL AREA _____ FT. FROM _____ LOT LINE AND _____ FT. FROM _____ LOT LINE AS SEEN WHEN FACING LOT FROM

REPAIR-CALL FOR INSPECTION WHEN GROUND IS OPENED UP SO SANITARIAN CAN RECOMMEND

REPAIR. Soil & Groundwater conditions unsuitable for any repair. Recommend sealed holding tank w/ app. alarm device.

PLANS APPROVED BY Palmer F. Wine DATE 4/5/78

COVER NO WORK UNTIL INSPECTED AND APPROVED.

NEITHER THE HOWARD COUNTY COUNCIL NOR THE HEALTH DEPARTMENT IS RESPONSIBLE FOR THE SUCCESSFUL OPERATION OF ANY SYSTEM.

NOTE: IF TRENCH IS USED CALL FOR INSPECTION BEFORE PLACING GRAVEL IN TRENCH.

NOTE: NO DRY WELL SHALL EXCEED 15 FOOT IN DIAMETER.

NOTE: ALL PIPE FROM HOUSE TO DISPOSAL AREA MUST BE CAST IRON.


PERMIT VOID AFTER THREE YEARS.

NOTE: INSTALL STAND PIPE ON SEPTIC TANK AND DRY WELL. STAND PIPES MUST BE 6 INCHES IN DIAMETER. CAST IRON, CONCRETE OR TERRA COTTA ACCEPTED.

*INSTALLER IS RESPONSIBLE FOR OBTAINING FINAL APPROVAL ON THIS PERMIT.

P 27763

Snowden River Parkway

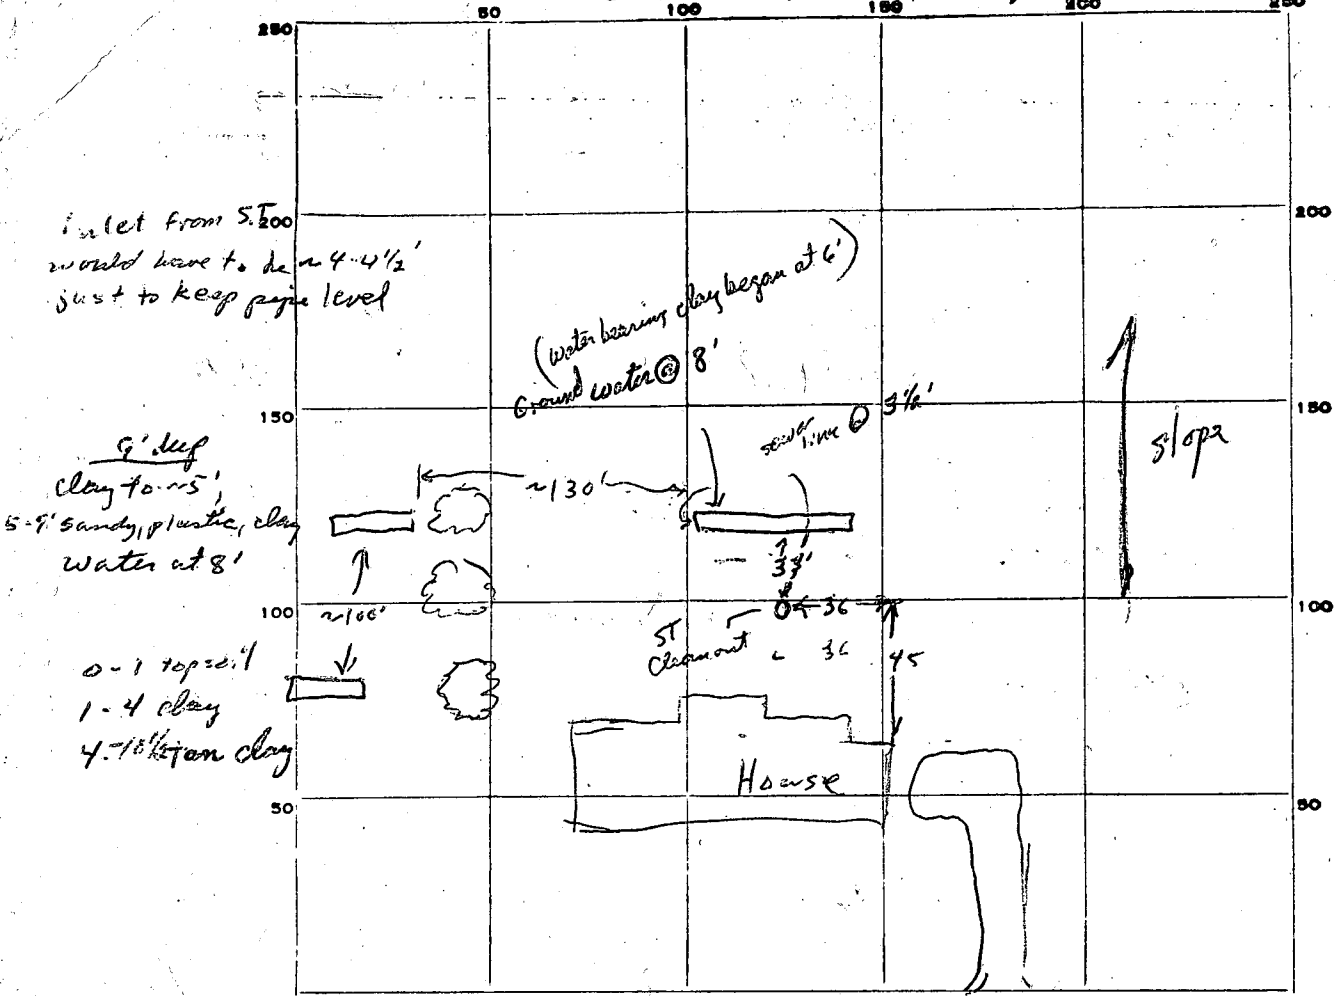

INDICATE NORTH. - NAME ADJOINING ROADWAY AS BASE LINE.

Berger Rd.

PERMIT CARD

SEPTIC TANK, LEVEL _____ CLEANOUTS

DISTRIBUTION BOX, LEVEL _____

TILE FIELD, DEPTH _____ FT. TRENCH WIDTH _____ FT.

GRAVEL DEPTH _____ IN. TOTAL LENGTH _____ FT.

NUMBER OF TRENCHES _____ TOTAL BOTTOM AREA _____

SEEPAGE PITS, INSIDE DIAMETER _____ FT. DEPTH BELOW INLET _____ FT.

ABSORBENT AREA _____ SQ. FT.

REMARKS 5/24/78 T.S.O.: 2,000 gallon sealed tank w/ cleanout installed & connected. OK to cover tank. Final approval held until alarm device installed.

6/7/78: Thomson spoke w/ DWM. Granted variance for alarm device since he has basement office w/ bathroom & would be 1st to know if tank not pumped.

DATE SYSTEM APPROVED 6/9/78 INSPECTOR T.S.Ogle