

app 10-11-78
29

8/18/78

PERMIT

P 27771
A _____

SEWAGE DISPOSAL SYSTEM

MARYLAND STATE DEPARTMENT OF HEALTH*

HOWARD COUNTY

ELLCOTT CITY

DISTRICT 2nd

INDEXED

DATE 4/7/78

Higgers, Inc.

Howard Associates

IS PERMITTED TO INSTALL _____ ALTER

ADDRESS Suite 118, Teachers Building, Columbia, Md. 21044 PHONE 730-7733

SUBDIVISION _____ ROAD 10194 Baltimore National LOT _____
Pike

PROPERTY OWNER Howard Associates (Tenant - Mrs. Duvall)

ADDRESS same as above

SPECIFICATIONS

SEPTIC TANK CAPACITY _____ GALLONS

DRAIN FIELD _____ DEPTH _____ FEET, BOTTOM AREA _____ SQ. FT.

DEEP TRENCH _____ DEPTH _____ FEET, BOTTOM AREA _____ SQ. FT.

SEEPAGE PITS _____ ABSORBENT SIDE-WALL AREA _____ SQ. FT.

INLET PIPE _____ FT. BELOW ORIGINAL GRADE. MAXIMUM DEPTH _____ FT. BELOW ORIGINAL GRADE

EFFECTIVE DEPTH AT _____ FT. BELOW ORIGINAL GRADE.

LOCATE DISPOSAL AREA _____ FT. FROM _____ LOT LINE AND _____ FT. FROM _____ LOT LINE AS SEEN WHEN
FACING LOT FROM

REPAIR - CALL FOR AN APPOINTMENT WHEN GROUND IS OPENED UP AND SANITARIAN WILL

RECOMMEND REPAIR SYSTEM.

- floor drain to be taken off septic tank

8-18-78

Trench 100' long - 11 1/2' deep - 8' stone trench to come off

SW - follow contour of ground & be inspected before gravel is installed

PLANS APPROVED BY Palmer F. Wine DATE 4/7/78

COVER NO WORK UNTIL INSPECTED AND APPROVED.

Wash machines to go thru tank. floor drain not to be used.

NEITHER THE HOWARD COUNTY COUNCIL NOR THE HEALTH DEPARTMENT IS RESPONSIBLE FOR THE SUCCESSFUL OPERATION OF ANY SYSTEM.

NOTE: IF TRENCH IS USED CALL FOR INSPECTION BEFORE PLACING GRAVEL IN TRENCH.

NOTE: NO DRY WELL SHALL EXCEED 15 FOOT IN DIAMETER.


NOTE: ALL PIPE FROM HOUSE TO DISPOSAL AREA MUST BE CAST IRON.

PERMIT VOID AFTER THREE YEARS.

NOTE: INSTALL STAND PIPE ON SEPTIC TANK AND DRY WELL. STAND PIPES MUST BE 6 INCHES IN DIAMETER. CAST IRON, CONCRETE OR TERRA
COTTA ACCEPTED.

*INSTALLER IS RESPONSIBLE FOR OBTAINING FINAL APPROVAL ON THIS PERMIT.

P 27771

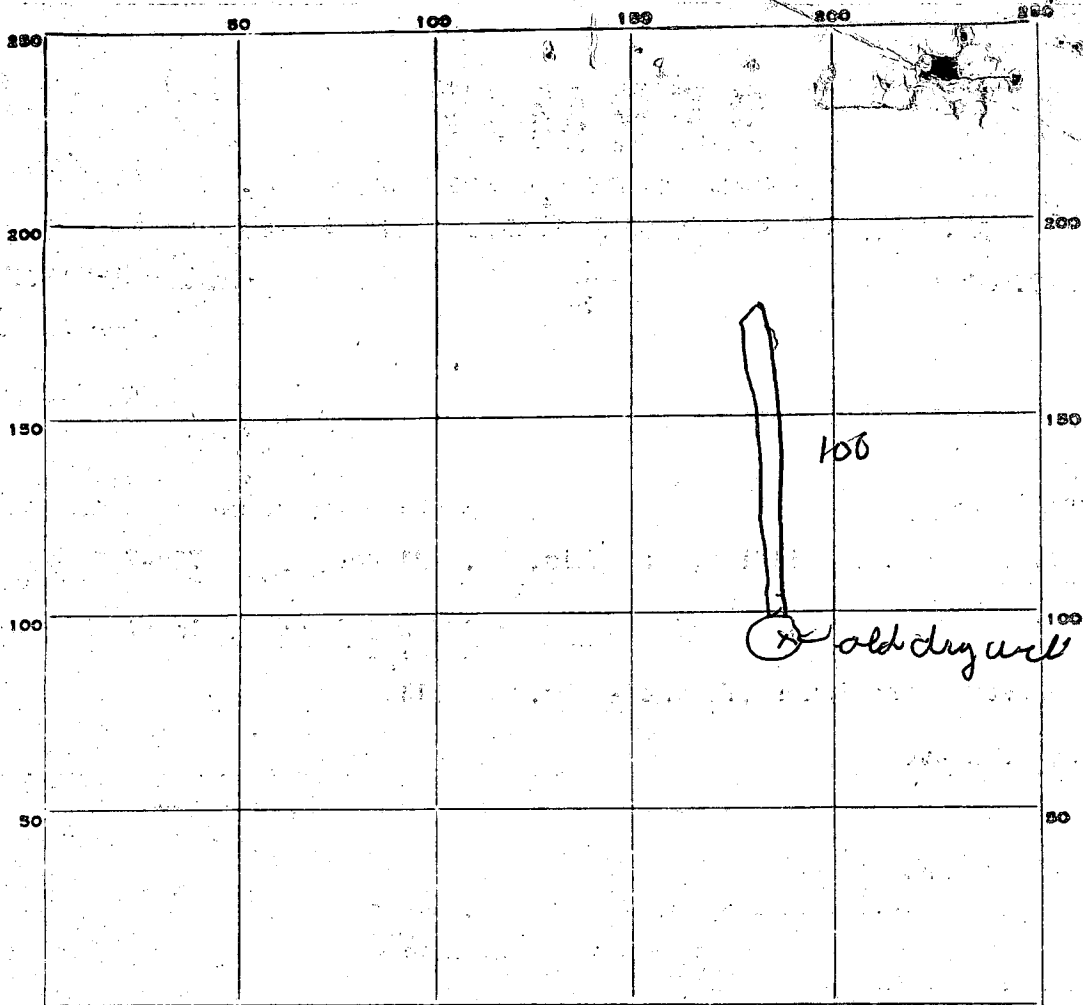

INDICATE NORTH. - NAME ADJOINING ROADWAY AS BASE LINE.

PERMIT CARD NP

SEPTIC TANK, LEVEL NA CLEANOUTS NA

DISTRIBUTION BOX, LEVEL _____

TILE FIELD, DEPTH 11 FT. TRENCH WIDTH 2 FT.

GRAVEL DEPTH 7 IN. TOTAL LENGTH 100 FT.

NUMBER OF TRENCHES 1 TOTAL BOTTOM AREA 200

SEEPAGE PITS, INSIDE DIAMETER _____ FT. DEPTH BELOW INLET _____ FT.

ABSORBENT AREA 700 SQ. FT. in trench

8-28-78
REMARKS gravel to extend 4' below grade - OK to gravel trench

Flood drain & wash machine into separate pit

DATE SYSTEM APPROVED 10/11/78 INSPECTOR Wm. Managhan

August 2, 1978

Mr. Joel Abramson
Suite 105
Clark Building
Columbia, Md. 21044

RE: Howard Associates property
10194 Baltimore National Pike
Ellicott City, Md.

Dear Mr. Abramson:

Section 12.104 of the Howard County Code states: "The Board of Health, the County Health Officer, Sanitarian or his representative, shall take cognizance of all conditions dangerous to health and may on their own initiative institute an investigation."

On April 5, 1978, Mr. Donald Monaghan of this department sent you a letter ordering repair of the septic system located at 10194 Baltimore National Pike.

A permit to repair the system was obtained on April 7, 1978. No repairs have been instituted. The health hazard has not been abated, under the terms of the letter of April 5, 1978, which stated in part "have the system repaired and inspected and approved by the Health Department."

You must have the repair completed within ten (10) days of receipt of this letter, or apply to the Executive Secretary of the Board of Health for a hearing within ten (10) days from the date of this notice. If you do not apply for a hearing within the prescribed time and if you do not comply with this directive, a summons will be issued directing you to appear before the District Court of Howard County for a trial.

A copy of the Howard County Code is available for you to see at the Howard County Health Department.

Very truly yours,

David J. O'Neill,
Sanitarian

DJO'N:ds