

8/4/78

~~8/3/78~~

~~afternoon please~~

PERMIT

SEWAGE DISPOSAL SYSTEM

MARYLAND STATE DEPARTMENT OF HEALTH*

P 27845

A Repair

HOWARD COUNTY

04-36711

ELLICOTT CITY

DISTRICT _____

INDEXED

DATE _____

Bud Arnold

IS PERMITTED TO INSTALL _____ ALTER X

ADDRESS _____ PHONE _____

SUBDIVISION _____ ROAD _____ LOT _____

PROPERTY OWNER John R. Hale

ADDRESS 19121 Windsor Forest Rd

mt. air 121991

SPECIFICATIONS

SEPTIC TANK CAPACITY _____ GALLONS

DRAIN FIELD _____ DEPTH _____ FEET, BOTTOM AREA _____ SQ. FT.

DEEP TRENCH _____ DEPTH _____ FEET, BOTTOM AREA _____ SQ. FT.

SEEPAGE PITS _____ ABSORBENT SIDE-WALL AREA _____ SQ. FT.

INLET PIPE _____ FT. BELOW ORIGINAL GRADE. MAXIMUM DEPTH _____ FT. BELOW ORIGINAL GRADE

EFFECTIVE DEPTH AT _____ FT. BELOW ORIGINAL GRADE.

LOCATE DISPOSAL AREA _____ FT. FROM _____ LOT LINE AND _____ FT. FROM _____ LOT LINE AS SEEN WHEN

FACING LOT FROM

Repair - recommendations see original sheet.

A.M. Phone 7/26/78 3 Bedroom house per M. Arnold 1000 gallons

C.B.R.

on phone

trench 90' 6'-7' or more stones under

pipe - pipe no closer than 2' of original soil in trench.

PLANS APPROVED BY _____ DATE _____

COVER NO WORK UNTIL INSPECTED AND APPROVED.

NEITHER THE HOWARD COUNTY COUNCIL NOR THE HEALTH DEPARTMENT IS RESPONSIBLE FOR THE SUCCESSFUL OPERATION OF ANY SYSTEM.

NOTE: IF TRENCH IS USED CALL FOR INSPECTION BEFORE PLACING GRAVEL IN TRENCH.

NOTE: NO DRY WELL SHALL EXCEED 15 FOOT IN DIAMETER.


NOTE: ALL PIPE FROM HOUSE TO DISPOSAL AREA MUST BE CAST IRON.

PERMIT VOID AFTER THREE YEARS.

NOTE: INSTALL STAND PIPE ON SEPTIC TANK AND DRY WELL. STAND PIPES MUST BE 6 INCHES IN DIAMETER. CAST IRON, CONCRETE OR TERRAZO ACCEPTED.

*INSTALLER IS RESPONSIBLE FOR OBTAINING FINAL APPROVAL ON THIS PERMIT.

P 27845

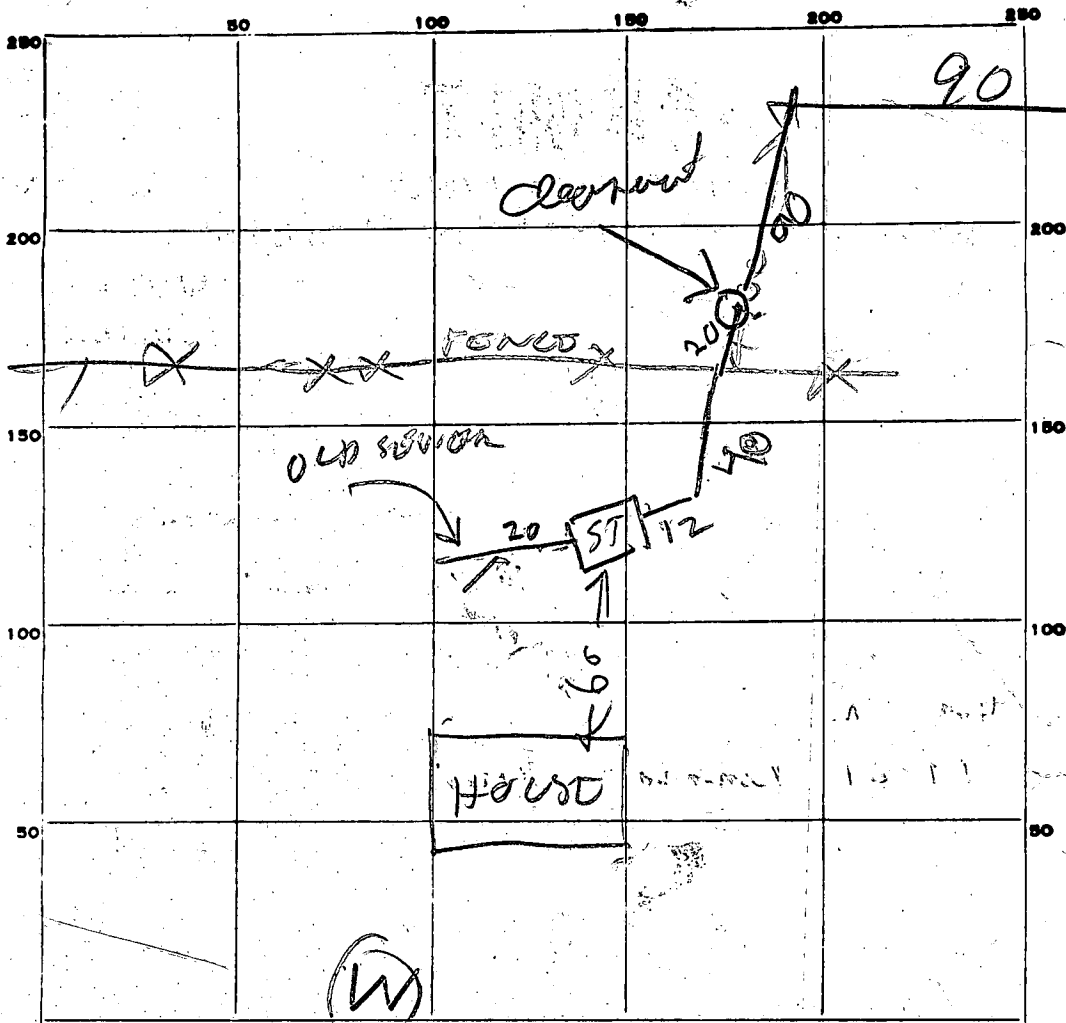

INDICATE NORTH. NAME ADJOINING ROADWAY AS BASE LINE.

PERMIT CARD _____

SEPTIC TANK, LEVEL OK 1000 CLEANOUTS OK

DISTRIBUTION BOX, LEVEL TOP 1 FT W 2 FT BELOW GRADE

TILE FIELD, DEPTH 9 FT. TRENCH WIDTH 2 FT.

GRAVEL DEPTH 7 FT IN. TOTAL LENGTH 90 FT.

NUMBER OF TRENCHES 1 TOTAL BOTTOM AREA 630 ONE SIDE

SEEPAGE PITS; INSIDE DIAMETER _____ FT. DEPTH BELOW INLET _____ FT.

ABSORBENT AREA _____ SQ. FT.

REMARKS
8/2/78 COVER TANK & PIPES TO YARD FENCE
ADD STONE TO DITCH INSTALL
REMAINING SEWERS & CALL RH
8/4/78 - SEWERS INSTALLED & STONE
ADDED TO DITCH

DATE SYSTEM APPROVED 8/4/78 INSPECTOR Raymond Hodge

PERMIT

SEWAGE DISPOSAL SYSTEM

MARYLAND STATE DEPARTMENT OF HEALTH*

HOWARD COUNTY

ELLICOTT CITY

DISTRICT 4th

DATE 4/17/78

P 27845
A Repair

Bud Arnold

IS PERMITTED TO INSTALL _____ ALTER X

ADDRESS _____ PHONE _____

SUBDIVISION _____ ROAD call around 4:00-4:30 LOT _____

PROPERTY OWNER John R. Hale 831-7016 Close to Rt 27 On right side
Windsor Manor on Wagon Wheel

ADDRESS 19121 Windsor Forest Rd. Mt. Airy, Md.

SPECIFICATIONS

SEPTIC TANK CAPACITY _____ GALLONS
DRAIN FIELD _____ DEPTH _____ FEET, BOTTOM AREA _____ SQ. FT.
DEEP TRENCH _____ DEPTH _____ FEET, BOTTOM AREA _____ SQ. FT.
SEEPAGE PITS _____ ABSORBENT SIDE-WALL AREA _____ SQ. FT.
INLET PIPE _____ FT. BELOW ORIGINAL GRADE. MAXIMUM DEPTH _____ FT. BELOW ORIGINAL GRADE
EFFECTIVE DEPTH AT _____ FT. BELOW ORIGINAL GRADE.
LOCATE DISPOSAL AREA _____ FT. FROM _____ LOT LINE AND _____ FT. FROM _____ LOT LINE AS SEEN WHEN

FACING LOT FROM

REPAIR - Call for appointment when ground is opened up and Sanitarian will recommend repair System.

(Options due to rock)
P.M. 5/30/78 D.W.M + C.B.V

- 1/01 (1) Can seal existing tanks - and use
- (2) Can repair with another large unit - sealed 2000 gallon
- (3) Can install tanks & dry well in area where backhoe dug deep

PLANS APPROVED BY Palmer F. Wine DATE 4/17/78

COVER NO WORK UNTIL INSPECTED AND APPROVED.

NEITHER THE HOWARD COUNTY COUNCIL NOR THE HEALTH DEPARTMENT IS RESPONSIBLE FOR THE SUCCESSFUL OPERATION OF ANY SYSTEM.

NOTE: IF TRENCH IS USED CALL FOR INSPECTION BEFORE PLACING GRAVEL IN TRENCH.

NOTE: NO DRY WELL SHALL EXCEED 15 FOOT IN DIAMETER.

NOTE: ALL PIPE FROM HOUSE TO DISPOSAL AREA MUST BE CAST IRON.

PERMIT VOID AFTER THREE YEARS.

NOTE: INSTALL STAND PIPE ON SEPTIC TANK AND DRY WELL. STAND PIPES MUST BE 6 INCHES IN DIAMETER. CAST IRON, CONCRETE OR TERRA COTTA ACCEPTED.

*INSTALLER IS RESPONSIBLE FOR OBTAINING FINAL APPROVAL ON THIS PERMIT.

HOWARD COUNTY HEALTH DEPARTMENT

JOYCE M. BOYD, M.D., M.P.H.
DEPUTY STATE AND
COUNTY HEALTH OFFICER



P.O. BOX 476
ELLCOTT CITY, MARYLAND 21043
TELEPHONE: ~~992-2330~~
992-2330

July 6, 1978

Mr. and Mrs. John R. Hale
19121 Windsor Forest Road
Mt. Airy, Maryland 21771

Dear Mr. and Mrs. Hale:

Please be advised the Bureau of Environmental Health, Howard County Health Department, requires all systems be repaired. After discussing your situation with the chief of water and sewer the following options are available;

1. Repair existing tank for a sealed unit and have inspected by the Health Department.
2. Install another new sealed unit, 2000 gallon minimum, and have inspected.
3. Install a new septic tank and appropriate system in area where backhoe was able to excavate to 10 to 11 feet on June 30, 1978.

Sincerely,

Charles B. Streaker,
Sanitarian

CBS:hs

ENCLOSURE