

PERMIT

1/17/83
R11

APPROVED
P 32302
A 28419

SEWAGE DISPOSAL SYSTEM

MARYLAND STATE DEPARTMENT OF HEALTH

HOWARD COUNTY

03-357131

ELLICOTT CITY

DISTRICT 3rd

DATE Nov. 9, 1982

INDEX

Robert L. Orndorff

IS PERMITTED TO INSTALL ALTER

ADDRESS 7469 Flamewood Dr., Clarksville, Md. 21029

PHONE 776-0444

SUBDIVISION Farside

ROAD 1765 Farside Road

LOT 37

PROPERTY OWNER Reamy, Jr.

~~Richard & Jo Reamy~~ Schulte/Vance

ADDRESS

SPECIFICATIONS 5 Bedrooms

SEPTIC TANK CAPACITY 1000 GALLONS

DRAIN FIELD DEPTH FEET, BOTTOM AREA SQ. FT.

DEEP TRENCH DEPTH FEET, BOTTOM AREA SQ. FT.

SEEPAGE PITS ABSORBENT SIDE-WALL AREA 150 SQ. FT. per bedroom

INLET PIPE 3 FT. BELOW ORIGINAL GRADE, MAXIMUM DEPTH 10 FT. BELOW ORIGINAL GRADE

EFFECTIVE DEPTH AT FT. BELOW ORIGINAL GRADE.

LOCATE DISPOSAL AREA 100 FT. FROM back LOT LINE AND 30 FT. FROM right LOT LINE AS SEEN WHEN

FACING LOT FROM the back lot line. Ok to add a ditch off dry well to make extra absorbent area if needed. Make ditch 10 feet deep filled with 6 feet of stone.

NOTE: For the purpose of these specs. The back lot line is the 420 feet long lot line running North 52° 22' 18" East.

NOTE: Manhole to grade level required on septic tank.

PLANS APPROVED BY Raymond Hodges

DATE 9/21/78

COVER NO WORK UNTIL INSPECTED AND APPROVED.

NEITHER THE HOWARD COUNTY COUNCIL NOR THE HEALTH DEPARTMENT IS RESPONSIBLE FOR THE SUCCESSFUL OPERATION OF ANY SYSTEM.

NOTE: IF TRENCH IS USED CALL FOR INSPECTION BEFORE PLACING GRAVEL IN TRENCH.

NOTE: NO DRY WELL SHALL EXCEED 16 FOOT IN DIAMETER.

NOTE: ALL PIPE FROM HOUSE TO DISPOSAL AREA MUST BE CAST IRON.

PERMIT VOID AFTER THREE YEARS.

NOTE: INSTALL STAND PIPE ON SEPTIC TANK AND DRY WELL. STAND PIPES MUST BE 6 INCHES IN DIAMETER. CAST IRON, CONCRETE OR TERRA COTTA ACCEPTED.

*INSTALLER IS RESPONSIBLE FOR OBTAINING FINAL APPROVAL ON THIS PERMIT.

BLDG. PERMIT SIGNED


AND RETURNED 7-8-99

Serial # B00118954
1-Story addition

EH-2-1079

AD8419

1/17/83
H.M. please
as soon as possible

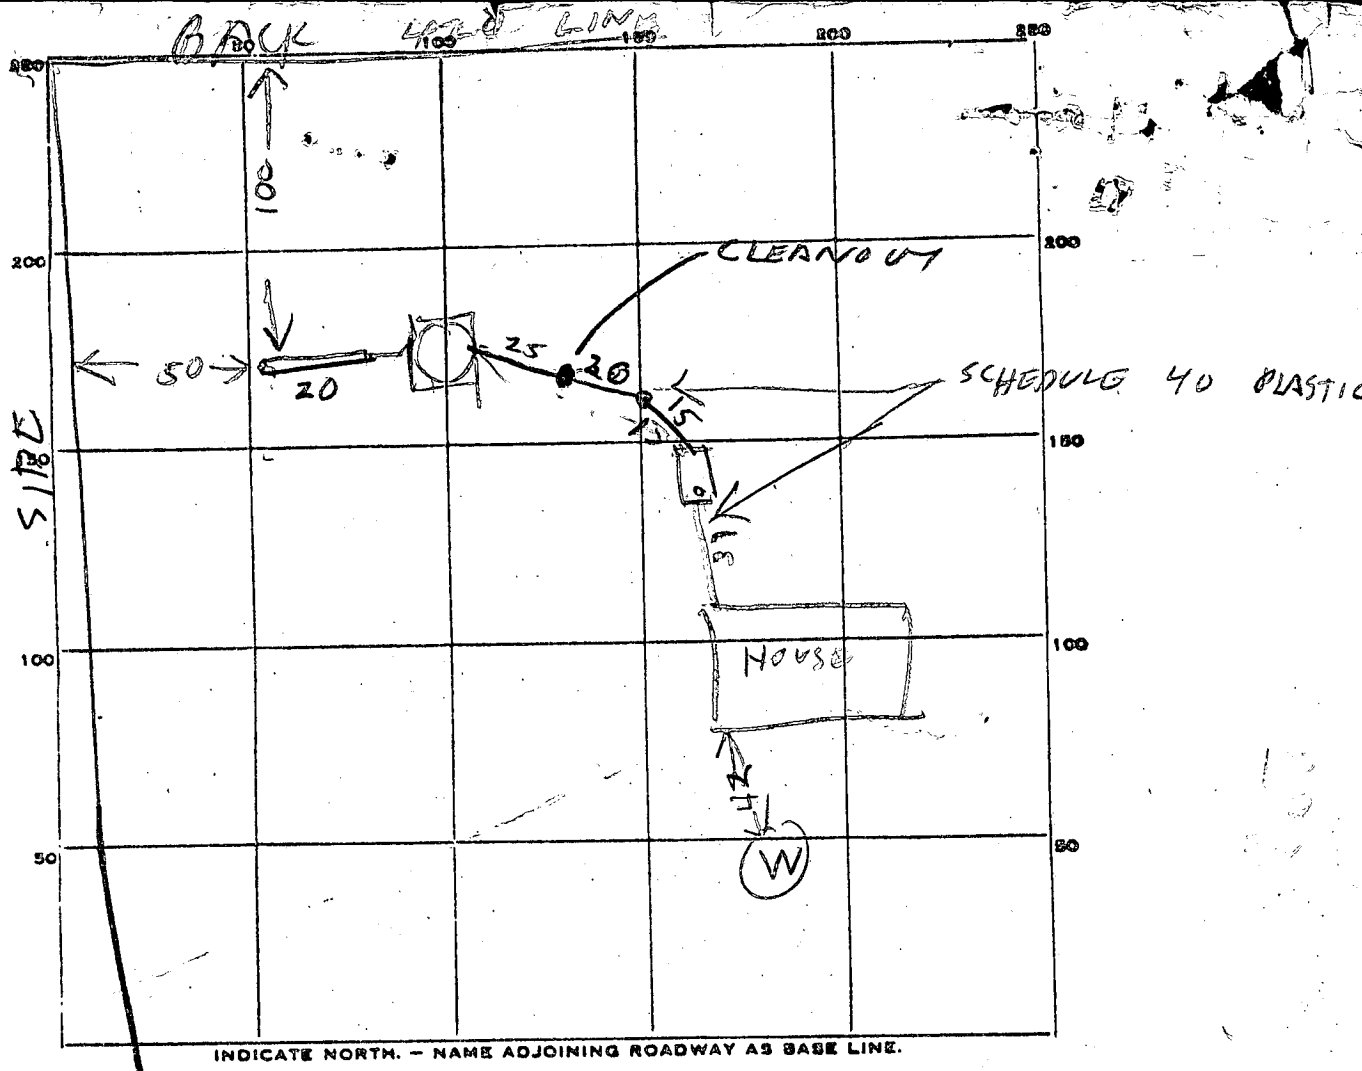

PERMIT CARD _____

SEPTIC TANK LEVEL OK 100K CLEANOUTS ST/DW
TOP ONLY 2-3 FT BOG OK/OK

DISTRIBUTION BOX LEVEL _____

DITCH TILE FIELD, DEPTH 10 FT. TRENCH WIDTH 2 FT.

GRAVEL DEPTH 7 FT IN. TOTAL LENGTH 20 FT.

NUMBER OF TRENCHES 1 TOTAL BOTTOM AREA 140 SQ. FT.

PERIMETER 48 FT. DEPTH BELOW INLET 7 1/2 FT.

ABSORBENT AREA 358 SQ. FT.

REMARKS 1/17/82 LOCATION A LITTLE OFF BUT STILL OK
DW INLET 3 FT BOG MANHOLE NOT NEEDED FOR
TANK. OK TO ADD STONE TO DITCH COVER TANK &
HOUSE SEWER OK TO COVER PART OF DITCH BETWEEN
TANK & DRY WELL 3 X 150 = 450 SQFT NEEDED
358 + 140 = 498 SQFT DW & DITCH
 DATE SYSTEM APPROVED 1/17/82 INSPECTOR Raymond Hodge

APPLICATION

A 28419

P _____

SEWAGE DISPOSAL TESTING

STATE OF MARYLAND - DEPARTMENT OF HEALTH AND MENTAL HYGIENE

HOWARD COUNTY HEALTH DEPARTMENT
ENVIRONMENTAL HEALTH SERVICES
P. O. BOX 476, ELLICOTT CITY, MARYLAND 21043
TELEPHONE: 465-5000, EXT. 356

DISTRICT 3

DATE May 12, 1978

SPECS ON EXTRA SHEET

BLDG. PERMIT SIGNED
AND RETURNED 8/1/82
Serial #57393

TO: THE COUNTY HEALTH OFFICER
ELLICOTT CITY, MARYLAND

I, HEREBY, APPLY FOR THE NECESSARY TEST IN ORDER TO CONSTRUCT (OR RECONSTRUCT) A SEWAGE DISPOSAL SYSTEM.

PROPERTY OWNER Woodmark, Inc. Reamy, Jr.

ADDRESS 9267 Balto. Nat'l. Pike PHONE 461-2889

PROPERTY LOCATION:

SUBDIVISION Farside LOT NO. 38 37

ROAD AND DESCRIPTION Rt. 40 West to left on Rt. 114, left on Folly Quarter, left on
Homewood, 1 mile to property on left 11765 Farside Road

SIZE OF LOT 3 plus acres TYPE BLDG. 11

NUMBER OF BEDROOMS

IF NOT SINGLE RESIDENCE DESCRIBE _____

THE SYSTEM INSTALLED UNDER THIS APPLICATION IS ACCEPTABLE ONLY UNTIL PUBLIC FACILITIES BECOME AVAILABLE.

SIGNATURE OF APPLICANT [Signature]

APPROVED BY _____ FOR _____ DATE 11

(KIND OF SYSTEM)

REJECTED BY _____ FOR _____ DATE _____

(KIND OF SYSTEM)


HOLD PENDING FURTHER TESTS _____ DATE _____

REASONS FOR REJECTION OR HOLDING 7/14/78 MUST SHOW 10,000 SQ. FT.

PER MR. MONAHAN AWAY FROM WATER

7/17/78 P.M. office same as above + must show all holes of P.W.M.
1176 J.A.D. + Phil. J.D. + C.B.S.

THIS IS NOT A PERMIT

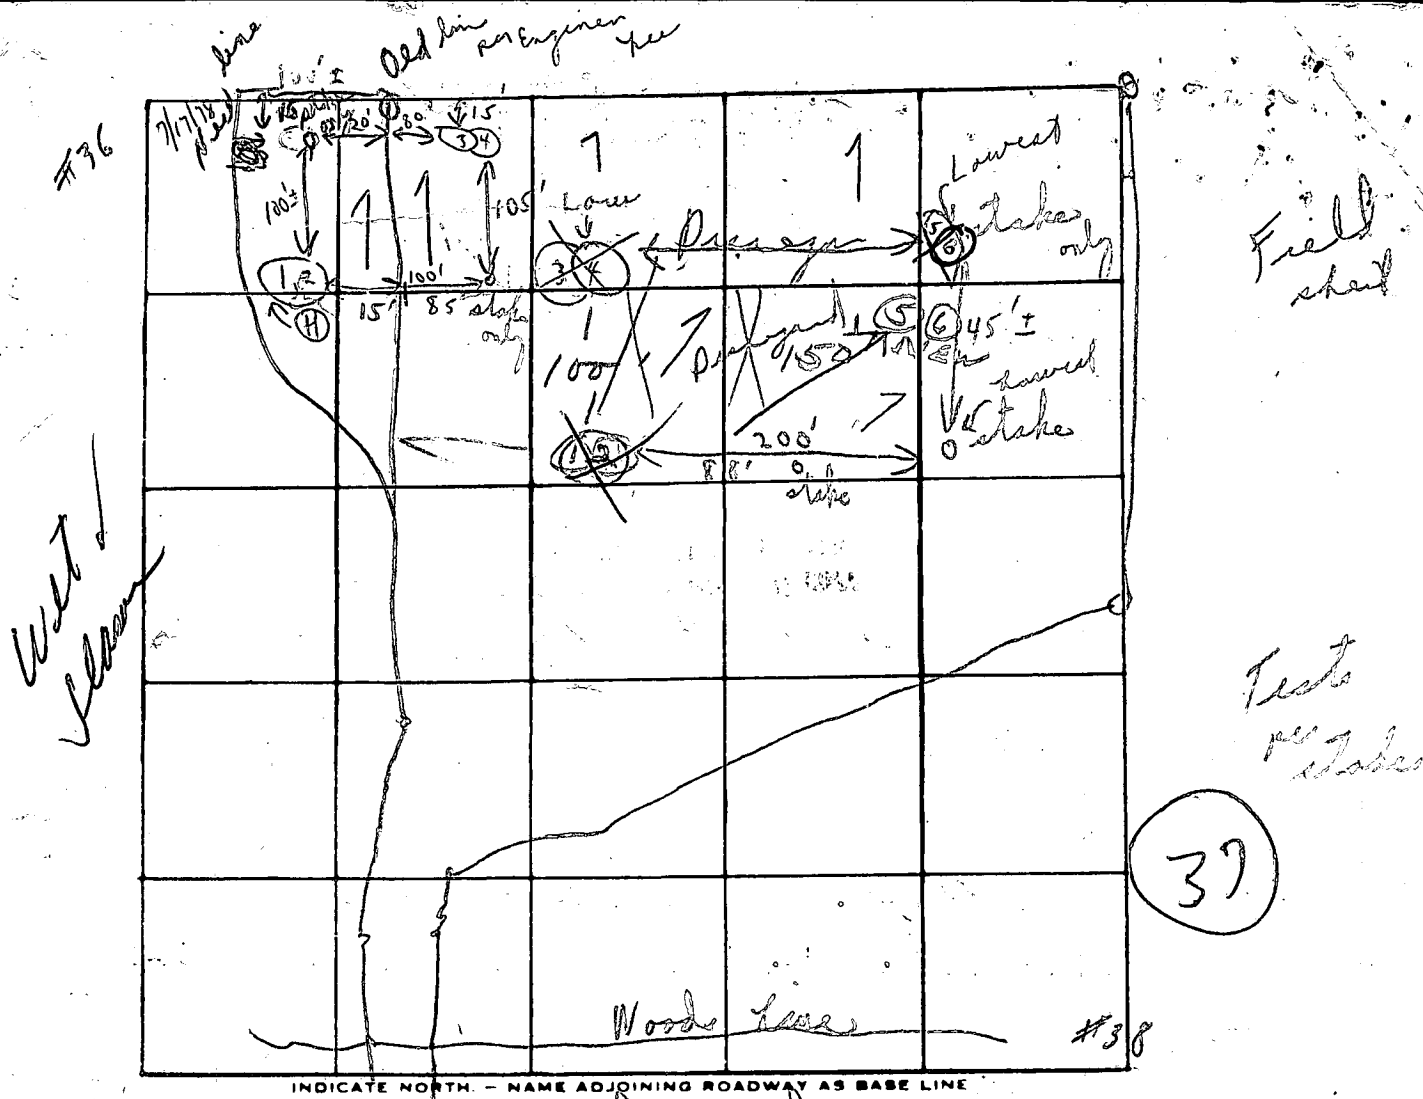

INDICATE NORTH - NAME ADJOINING ROADWAY AS BASE LINE

Soil Profile

DATE	TEST NO.	DEPTH	PRE-WET		TEST - 1" DROP		TIME		
			START	STOP	START	STOP			
7/11/28	1	7'	4 1/2'	2:52	2:53	2:53	2:59	1 in	
	④ 2	11'	11 1/2'	2:53	2:54	2:54	2:59	3 in	
	3	5'	4 1/2'	2:35	2:36	2:36	2:41	5 in	
	④ 4	11'	11'	2:34	2:35	2:35	2:36	1 in	
				2 holes per P.F.W.					
	5	6 1/2'		④ 3	7/12/28 3/2	10:08	10:09	10:12	3 in
				4	12	10:07	10:10	10:17	7 in
	⑥	(7' water)		1	4'	10:26	10:30	10:41	11 in
				2	12'	10:28	10:30	10:36	6 in
7/12	5	7'	3	NEW HOLE - VISUAL		194		239	5 in avg, total 4 1/2
	6	10		NO WATER					Wanted on hole to be dug
				(Hold for redesign)					Crought up to design

REMARKS

TYPE OF SOIL


TESTED BY

Test → deep in woods
 Older Steve stated - to return tomorrow lines not clear
 Steve
 J.A.O.

Field sheet
 Tests per stakes
 37
 Wooded Lane #38
 Good down
 nice slow
 Hold for supervisor
 C.B.D. Deep in woods
 5 in avg, total 4 1/2
 Wanted on hole to be dug

FAR SIDE

Lot 37

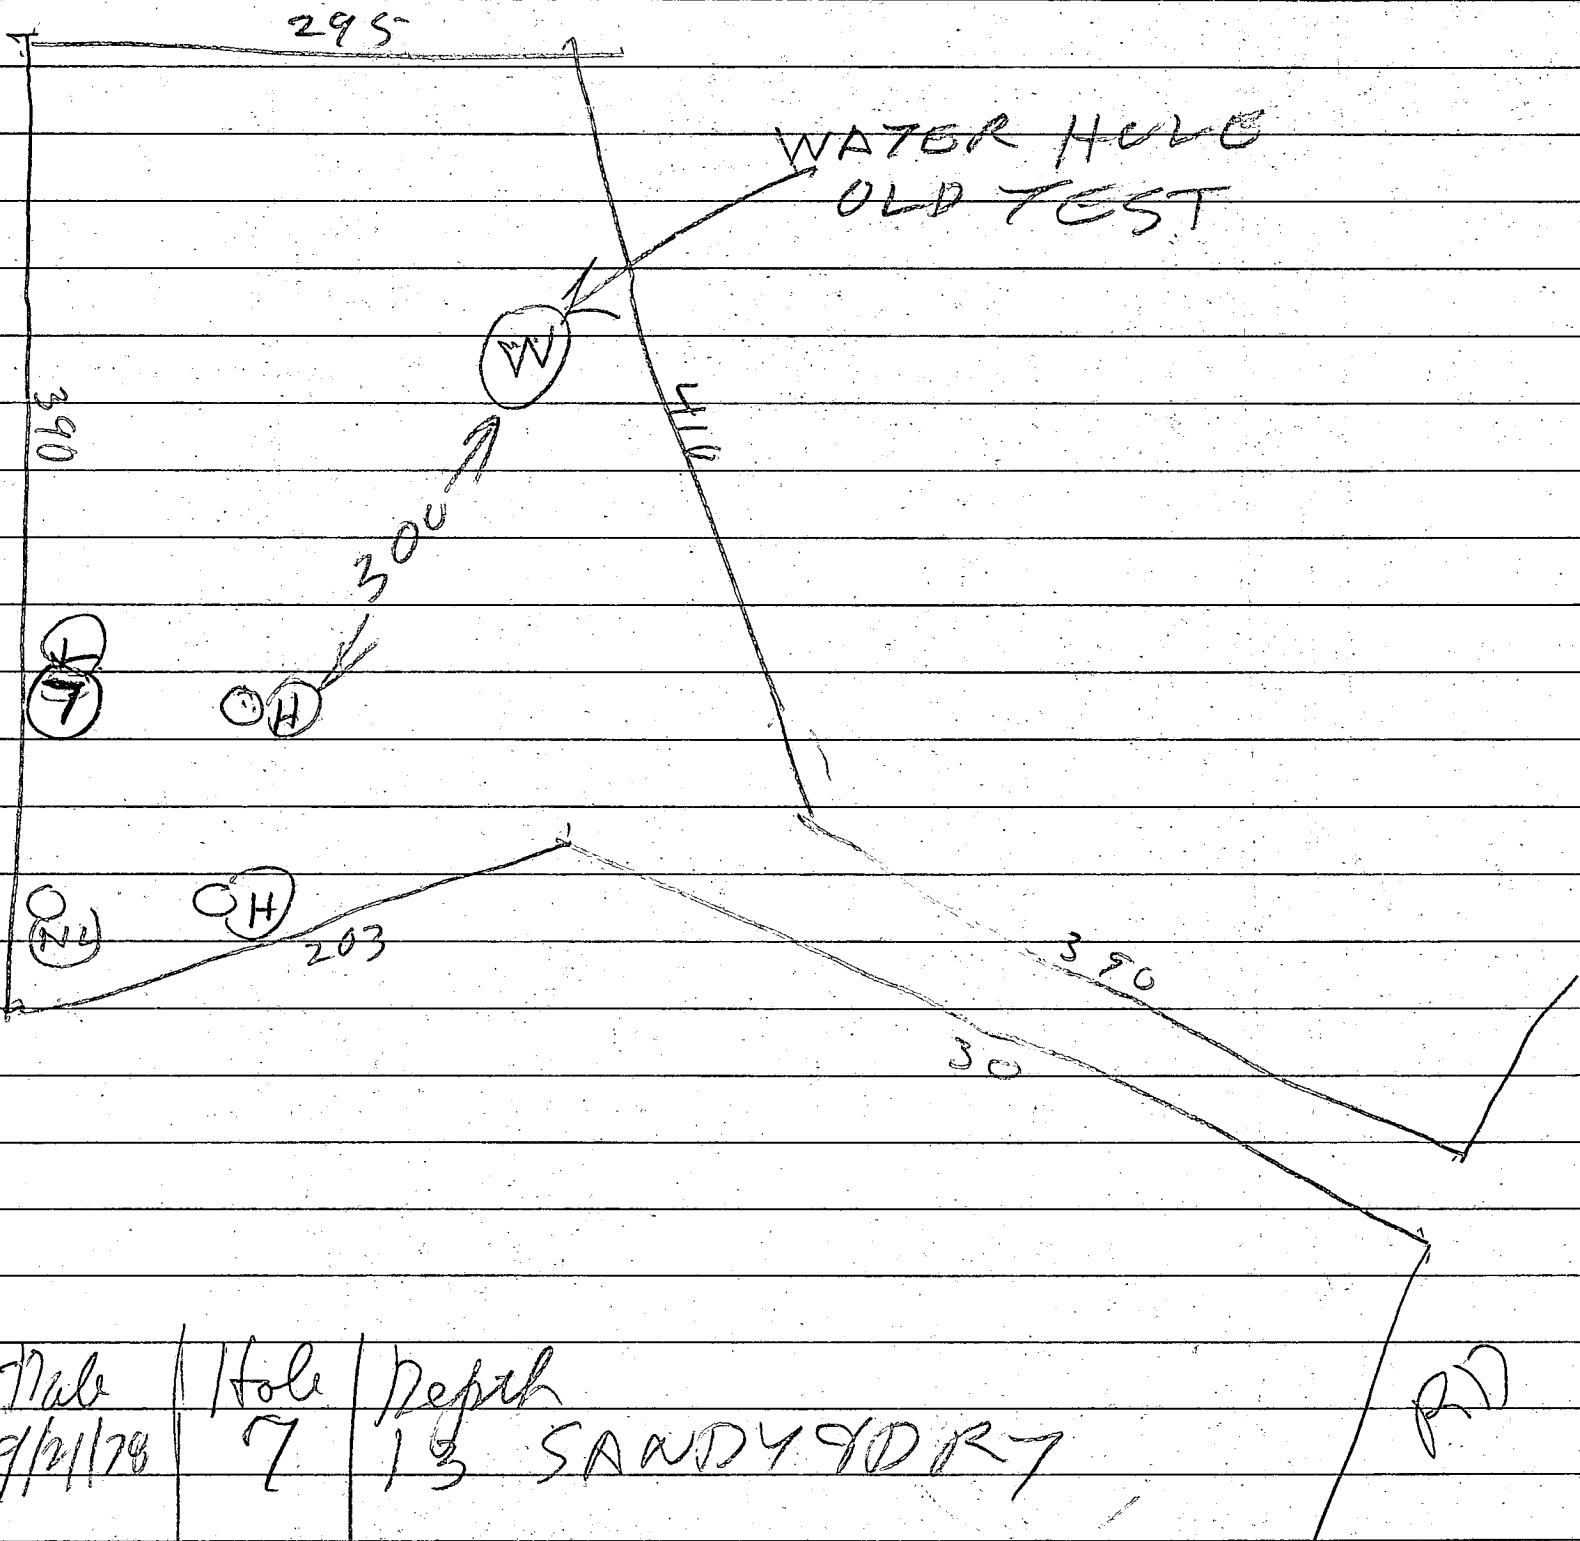

Date	Hole	Depth	Notes
9/21/78	7	13	SANDY GDRY
water hole 300 ft from High Base per test / hole Test By RH			

B 1 7321 SEQUENCE NO. WRA USE ONLY

STATE OF MARYLAND APPLICATION FOR PERMIT TO DRILL WELL

WRA PERMIT NUMBER

HO-73-4/81

(THIS NUMBER IS TO BE PUNCHED IN COLS. 3-6 ON ALL CARDS)

please print or type

fill in this form completely

DATE RECEIVED 5-17-82 6/14/82
 8 (WRA USE ONLY) 13
 OWNER INFORMATION
Woodmark, Inc
 LAST NAME OWNER FIRST NAME
2150 Mt. Albert Court
 15 34
 STREET OR RFD
Ellicott City, Maryland 21043
 36 55
 TOWN STATE ZIP
Ellicott City Md 21043

B 3 LOCATION OF WELL
 COUNTY Howard
 SUBDIVISION "Farside"
 SECTION 44 LOT 37
 NEAREST TOWN Ellicott City
 MILES FROM TOWN (enter 0 if in town) 7 MI

B 1 CONTINUED DRILLER INFORMATION
Ronald J. Kiker 296
 DRILLER'S NAME LICENSE NO. 80
Ronald J. Kiker 5/17/82
 SIGNATURE DATE

B 4 Farside
 DIRECTION OF WELL FROM TOWN (CIRCLE BOX)

 NEAR WHAT ROAD
 ON WHICH SIDE OF ROAD (CIRCLE APPROPRIATE BOX)
 WEST EAST SOUTH NORTH
 32
 520
 DISTANCE FROM ROAD (CIRCLE APPROPRIATE BOX)
 37
 38 39

B 2 WELL INFORMATION
 APPROX. PUMPING RATE (GAL. PER MIN.) 5
 AVERAGE DAILY QUANTITY NEEDED (GAL. PER DAY) 550

USE FOR WATER (CIRCLE APPROPRIATE BOX)
 HOME (SINGLE OR DOUBLE HOUSEHOLD UNIT ONLY)
 FARMING (LIVESTOCK WATERING & AGRICULTURAL IRRIGATION)
 INDUSTRIAL, COMMERCIAL, STATE AND FEDERAL GOV. OTHER (REQUIRES APPROPRIATION PERMIT)
 PUBLIC OR PRIVATE WATER COMPANY (REQUIRES APPROPRIATION PERMIT AND STATE HEALTH DEPARTMENT APPROVAL)
 TEST, OBSERVATION, MONITORING (MAY REQUIRE APPROPRIATION PERMIT)

SHOW LOCATION OF WELL WITH AN "X" IN THIS BOX
 LOCATION OR
51' CASING X WELL
2' ABOVE GROUND
OPEN - 48 ft BAGS CEMENT
 WRITE THE BOX NUMBER FROM THE MAP HERE

E	820	3
N	510	7

JS. + CW
5/19/82

APPROXIMATE DEPTH OF WELL 150' FEET
 APPROXIMATE DIAMETER OF WELL 6" NEAREST INCH

DRAW A SKETCH BELOW SHOWING LOCATION OF WELL IN RELATION TO NEARBY TOWNS AND ROADS AND GIVE DISTANCE FROM WELL TO NEAREST ROAD JUNCTION

Homewood Rd.
Farside Rd.

Method of Drilling (circle one)
 BORED (OR AUGERED) JETTED JETTED & DRIVEN
 AIR ROTARY AIR PERCUSSION ROTARY (HYDRAULIC)
 CABLE REVERSE ROTARY DRIVE POINT ROTARY
 other _____

REPLACEMENT OR DEEPEMED WELLS (Circle Appropriate Box)
 THIS WELL WILL NOT REPLACE AN EXISTING WELL
 THIS WELL WILL REPLACE A WELL THAT WILL BE ABANDONED AND SEALED
 THIS WELL WILL REPLACE A WELL THAT WILL BE USED AS A STANDBY
 THIS WELL WILL DEEPEM AN EXISTING WELL
 PERMIT NUMBER OF WELL TO BE REPLACED OR DEEPEMED (IF AVAILABLE) _____

B 4 NOT TO BE FILLED IN BY DRILLER HEALTH DEPARTMENT APPROVAL
 COUNTY NAME Howard COUNTY NO. B28419
 EHA SIGNATURE Frank Skinner STATE HEALTH CIRCLE BOX S
 MO DAY YR 05/17/82 DATE
 CO SIGNATURE Frank Skinner, Sanitarian
 NORTH 517 EAST 0823 ELEV. (FT.) _____
 GRID 50 55 GRID 57 63 65 68

Not to be filled in by driller (WRA USE ONLY)
 APPROP. PERMIT NUMBER GAP
 FORCE INITIALS IN BOX ES CONDITIONS HO-73-4181

B 5 SPECIAL CONDITIONS (WRA USE ONLY)

C1 3173

SEQUENCE NO. (OEP USE ONLY)

STATE OF MARYLAND WELL COMPLETION REPORT

THIS REPORT MUST BE SUBMITTED WITHIN 45 DAYS AFTER WELL IS COMPLETED.

(THIS NUMBER IS TO BE PUNCHED IN COLS. 2-6 ON ALL CARDS)

Date Received (OEP use only)

DATE WELL COMPLETED

Depth of Well

PERMIT NO.

FROM "PERMIT TO DRILL WELL"

061482

278

HO-73-4/87

(TO NEAREST FOOT)

OWNER Woodmark Inc.

STREET OR RFD Farside Rd.

TOWN Ellicott City

SUBDIVISION Farside

SECTION

LOT 37

WELL LOG

GROUTING RECORD

Not required for driven wells STATE THE KIND OF FORMATIONS PENETRATED, THEIR COLOR, DEPTH, THICKNESS AND IF WATER BEARING

WELL HAS BEEN GROUTED YES Y NO N

TYPE OF GROUTING MATERIAL CEMENT CM BENTONITE CLAY BC

NO. OF BAGS 22 NO. OF POUNDS 2068

GALLONS OF WATER 132

DEPTH OF GROUT SEAL (to nearest foot) from 0 ft. to 12 ft.

DEPTH OF GROUT SEAL (to nearest foot) from 0 ft. to 12 ft.

CASING RECORD

ST CO PL OT STEEL CONCRETE PLASTIC OTHER

MAIN CASING TYPE S T Nominal diameter top (main) casing (nearest inch) 6 Total depth of main casing (nearest foot) 50' 9"

OTHER CASING (if used) diameter inch depth (feet) from to

SCREEN RECORD

ST BR HO STEEL BRASS BRONZE OPEN HOLE PL OT PLASTIC OTHER

DEPTH (nearest ft.) 50' 9" 278

SLOT SIZE

DIAMETER OF SCREEN (NEAREST INCH)

GRAVEL PACK

IF WELL DRILLED WAS FLOWING WELL CIRCLE BOX F

OEP USE ONLY (NOT TO BE FILLED IN BY DRILLER)

TELESCOPE CASING LOG INDICATOR OTHER DATA

C 3

PUMPING TEST HOURS PUMPED (nearest hour) 3

PUMPING RATE (gal. per min. to nearest gal.) 11.9

METHOD USED TO MEASURE PUMPING RATE Submersible

WATER LEVEL (distance from land surface) BEFORE PUMPING 34' 8"

WHEN PUMPING 99' 5"

TYPE OF PUMP USED (for test) S submersible

PUMP INSTALLED YES Y NO N

DRILLER WILL INSTALL PUMP (CIRCLE APPROPRIATE BOX)

IF DRILLER INSTALLS PUMP, THIS SECTION MUST BE COMPLETED FOR ALL WELLS EXCEPT HOME USE

TYPE OF PUMP (WRITE APPROPRIATE LETTER IN BOX - SEE ABOVE: (A, C, J, P, R, S, T, O))

CAPACITY: GALLONS PER MINUTE (to nearest gallon)

PUMP HORSE POWER

PUMP COLUMN LENGTH (nearest ft.)

CASING HEIGHT (circle appropriate box and enter casing height) + above LAND SURFACE - below 2 (nearest foot)

LOCATION OF WELL ON LOT. SHOW PERMANENT STRUCTURE SUCH AS BUILDING, SEPTIC TANKS, AND/OR LANDMARKS AND INDICATE NOT LESS THAN TWO DISTANCES (MEASUREMENTS TO WELL)

Table with 3 columns: DESCRIPTION, FEET (FROM TO), Check if water bearing. Rows include Dirt & Boulders, Soft Brn. Red Clay & Sand, Hard Blue Sandstone, Soft Brn. Sandstone, Hard Blk. Sandstone, Hard Blue, Brn. Wht. Sandstone, Hard Blue, White Sandstone, Blue, Black Wissachickon Schist, Hard Brn. Sandstone, Blue, Black Wissachickon Schist, Fracture, Blue & White Sandstone, Blue, White, Green, Blk. Sandstone.

- A A WELL WAS ABANDONED AND SEALED WHEN THIS WELL WAS COMPLETED
E ELECTRIC LOG OBTAINED
P TEST WELL CONVERTED TO PRODUCTION WELL

I HEREBY CERTIFY THAT THIS WELL HAS BEEN CONSTRUCTED IN ACCORDANCE WITH COMAR 10.17.13 "WELL CONSTRUCTION" AND IN CONFORMANCE WITH ALL CONDITIONS STATED IN THE ABOVE CAPTIONED PERMIT, AND THAT THE INFORMATION PRESENTED HEREIN IS ACCURATE AND COMPLETE TO THE BEST OF MY KNOWLEDGE.

DRILLERS IDENT. NO. 296
Ronald L. Kyker
DRILLERS SIGNATURE
SITE SUPERVISOR (sign of driller or journeyman responsible for sitework if different from permittee)

DRILLER WILL INSTALL PUMP (CIRCLE APPROPRIATE BOX)

TYPE OF PUMP (WRITE APPROPRIATE LETTER IN BOX - SEE ABOVE: (A, C, J, P, R, S, T, O))


CAPACITY: GALLONS PER MINUTE (to nearest gallon)

PUMP HORSE POWER

PUMP COLUMN LENGTH (nearest ft.)

CASING HEIGHT (circle appropriate box and enter casing height) + above LAND SURFACE - below 2 (nearest foot)

LOCATION OF WELL ON LOT. SHOW PERMANENT STRUCTURE SUCH AS BUILDING, SEPTIC TANKS, AND/OR LANDMARKS AND INDICATE NOT LESS THAN TWO DISTANCES (MEASUREMENTS TO WELL)

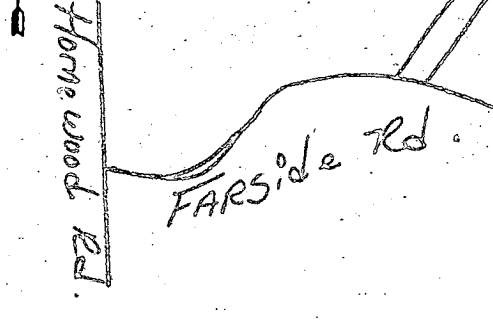

317.79'

420.00'



7/8/99

Proposed addition
as shown -
OK TO PROCEED
BLS

SITE PLAN

SCALE: ± 1" = 75'

LOT 37 - FARSIDE
PLAT # 4412 - 3RD ELEC. DIST
11765 FARSIDE ROAD
ELLICOTT CITY, HOWARD CO.
MD 21042

NEW ONE STORY STUDIO
FRAME ADDITION

EXIST. ONE STORY W/
BSMT. FRAME DWELLING

301.21'

LOT 35

LOT 36

514.24'

389.71'

50.01'

FARSIDE ROAD

ICE VENT

EXIST. HOUSE

RIDGE VENT

