

Approved 4/5/83  
Streyer 32551

4/5/83  
Ground work

# PERMIT

SEWAGE DISPOSAL SYSTEM

MARYLAND STATE DEPARTMENT OF HEALTH\*

A 29873

HOWARD COUNTY  
BUREAU OF ENVIRONMENTAL HEALTH  
992-2330

04-311597

INDEX

ELLCOTT CITY  
DISTRICT 4th

DATE 3/10/83

Paul Schissler IS PERMITTED TO INSTALL  ALTER

ADDRESS 7311 Brangles Rd., Marriottsville, Md. 21104 PHONE 795-2642

SUBDIVISION Countryside ROAD 3620 Point Hitch Rd. LOT 20

PROPERTY OWNER Jim Dein

ADDRESS (?)

IF GARBAGE GRINDER IS USED INCREASE SEPTIC TANK CAPACITY BY 50% AND ABSORPTION AREA BY 22%.

GARBAGE GRINDER? YES  NO

SEPTIC TANK CAPACITY 1000 GALLONS NUMBER OF BEDROOMS 3

Trenches to be 2' wide. Inlet to be 3' below original grade and effective absorbant

area from 3' - 7' only. Maximum depth of trenches to be 7' below original grade. A min. of 158' sq. ft. effective absorbant sidewall area per bedroom needed. Trenches can not exceed 100' in length. Distribution box to be used if more than 1 trench used.

Two inspections of trenches required - before and after stone installed. If more than 1 trench used - need to have 15' distance between trenches, center to center. Run trenches on contour and/or on level ground as much as possible.

LOCATION: Start trenches at a point 200' from front of the lot and in 15' from left property line when facing lot from Point Hitch Rd. as front of lot.

3/30/83 Maintain 100' between trenches and water well on lot 19 J.S.

PLANS APPROVED BY Charles B. Streaker DATE January 9, 1981

COVER NO WORK UNTIL INSPECTED AND APPROVED.

NEITHER THE HOWARD COUNTY COUNCIL NOR THE HEALTH DEPARTMENT IS RESPONSIBLE FOR THE SUCCESSFUL OPERATION OF ANY SYSTEM.

NOTE: IF TRENCH IS USED CALL FOR INSPECTION BEFORE AND AFTER PLACING GRAVEL IN TRENCH.

NOTE: NO DRY WELL SHALL EXCEED 15 FOOT IN DIAMETER. NO ABSORPTION TRENCH TO EXCEED 100 FEET IN LENGTH.

NOTE: ALL PIPE FROM HOUSE TO SEPTIC TANK MUST BE CAST IRON OR SCHEDULE 40 PVC OR ABS.

PERMIT VOID AFTER THREE YEARS.

NOTE: INSTALL STAND PIPE ON SEPTIC TANK AND DRY WELL. STAND PIPES MUST BE 6 INCHES IN DIAMETER. CAST IRON, CONCRETE OR TERRA COTTA, OR PVC OR ABS ACCEPTED. IF TOP OF SEPTIC TANK IS DEEPER THAN 3 FEET MANHOLE TO GRADE REQUIRED.


**\*INSTALLER IS RESPONSIBLE FOR OBTAINING FINAL APPROVAL ON THIS PERMIT**

\*CALL 992-2330 FOR INSPECTION OF SEPTIC SYSTEMS.

EH - 2-1082

A 28873

$$\begin{array}{r} 108 \\ \underline{\phantom{0}3} \\ 474 \\ \\ 120 \\ \underline{\phantom{0}4} \\ 480 \end{array}$$

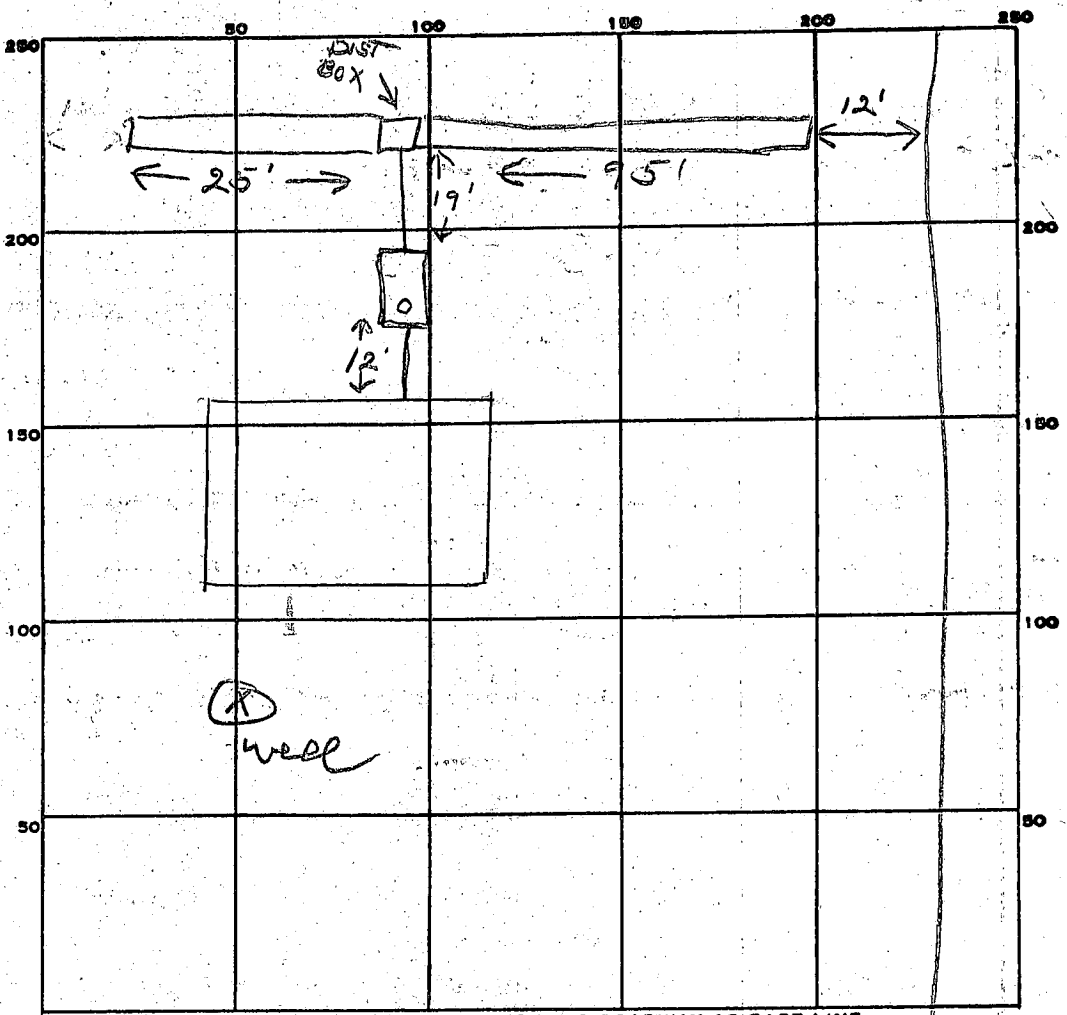

INDICATE NORTH. - NAME ADJOINING ROADWAY AS BASE LINE.

*Point Hiter Rd*

PERMIT CARD \_\_\_\_\_  
 SEPTIC TANK, LEVEL *✓* 1000 gal., CLEANOUTS 5T  
 DISTRIBUTION BOX, LEVEL *✓* \_\_\_\_\_  
 TILE FIELD, DEPTH 7 FT. TRENCH WIDTH 2 FT.  
 GRAVEL DEPTH 4 IN. TOTAL LENGTH 120 FT.  
 NUMBER OF TRENCHES 2 TOTAL BOTTOM AREA 480  
 SEEPAGE PITS, INSIDE DIAMETER \_\_\_\_\_ FT. DEPTH BELOW INLET \_\_\_\_\_ FT.  
 ABSORBENT AREA \_\_\_\_\_ SQ. FT.

REMARKS 4/5/83 OK to cover work to trench. OK to  
add stone in trenches. ✓  
4/5/83 OK to cover all work. ✓

DATE SYSTEM APPROVED 4/5/83 INSPECTOR Stayer



*Per*

# APPLICATION

SEWAGE DISPOSAL TESTING

STATE OF MARYLAND - DEPARTMENT OF HEALTH AND MENTAL HYGIENE

A 28873

P \_\_\_\_\_

HOWARD COUNTY HEALTH DEPARTMENT  
ENVIRONMENTAL HEALTH SERVICES  
P.O. BOX 476 ELLICOTT, MARYLAND 21043  
TELEPHONE: 992-2330

DISTRICT 4th

DATE 9/15/78

BLDG. PERMIT SIGNED  
AND RETURNED 4/21/83  
Serial # 52144

TO: THE COUNTY HEALTH OFFICER  
ELLICOTT CITY, MARYLAND

I, HEREBY, APPLY FOR THE NECESSARY TEST IN ORDER TO CONSTRUCT (OR RECONSTRUCT) A SEWAGE DISPOSAL SYSTEM.

PROPERTY OWNER Estate of Sylvan Manger Jim Deim

ADDRESS \_\_\_\_\_ PHONE \_\_\_\_\_

PROPERTY LOCATION:

SUBDIVISION Countryside S/D LOT NO. 20

ROAD AND DESCRIPTION Route 97 3620 Point Hitch

SIZE OF LOT 3 acres m/1 TYPE BLDG. 3 or 4 bedrooms

THE SYSTEM INSTALLED UNDER THIS APPLICATION IS ACCEPTABLE ONLY UNTIL PUBLIC FACILITIES BECOME AVAILABLE.

I FULLY UNDERSTAND THE FEE CONNECTED WITH THE FILING OF THIS PERC TEST APPLICATION IS NON-REFUNDABLE UNDER ANY CIRCUMSTANCES.

SIGNATURE OF APPLICANT /s/ Bernard Rome

APPROVED BY C.B. Streaker/agp FOR Inencher DATE 1/9/81


REJECTED BY \_\_\_\_\_ FOR \_\_\_\_\_ DATE \_\_\_\_\_

HOLD PENDING FURTHER TESTS \_\_\_\_\_ DATE \_\_\_\_\_

REASONS FOR REJECTION OR HOLDING \_\_\_\_\_

# THIS IS NOT A PERMIT

20

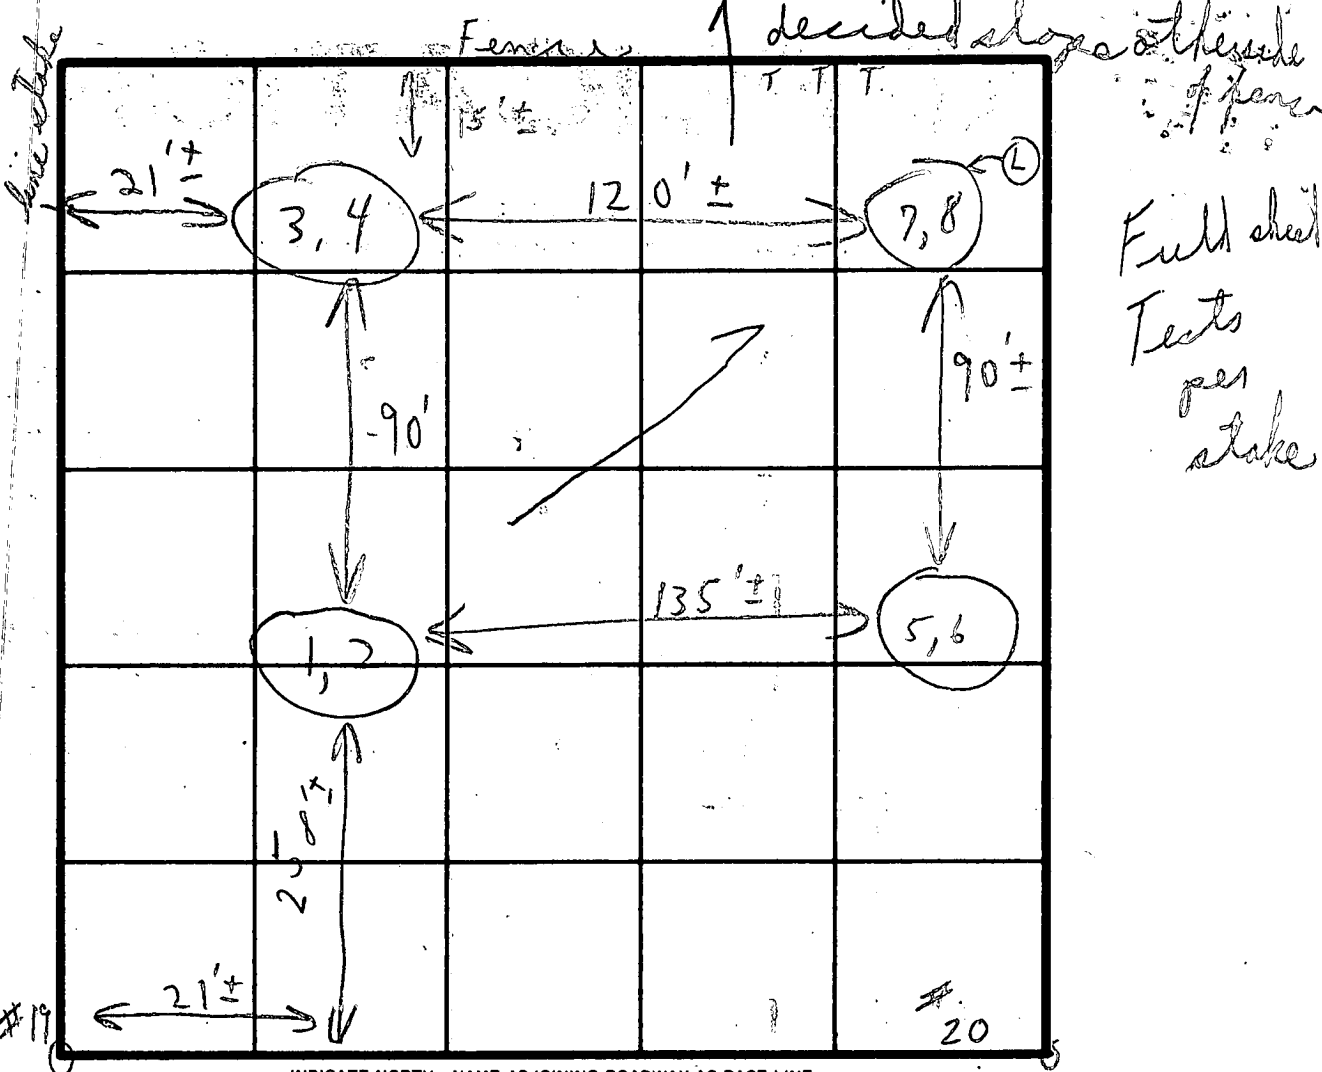

INDICATE NORTH - NAME ADJOINING ROADWAY AS BASE LINE.

Unnamed Road

DATE	TEST NO.	DEPTH	PRE-WET		TEST - 1' DROP		TIME
			START	STOP	START	STOP	
11/2/78	1	3'	3:02	3:03	3:03	3:07	4 min
	2	7'	3:02	3:03	3:03	3:07	4 min
	3	3'	3:05	3:06	3:06	3:08	2 min
	4	6 1/2'	3:05	3:06	3:06	3:08	2 min
	5	3'	3:14	3:16	3:16	3:19	3 min
	6	7'	3:14	3:15	3:15	3:17	2 min
	7	3'	3:13	3:16	3:16	3:20	3 min - 4 min
	8	7'	3:12	3:16	3:16	3:20	3 min - 4 min

REMARKS Tests in open field

TYPE OF SOIL


TESTED BY C. B. A.

ALSO PRESENT Mr. Rome

Mr. Queasberry


12/15/82

*Handwritten signature*

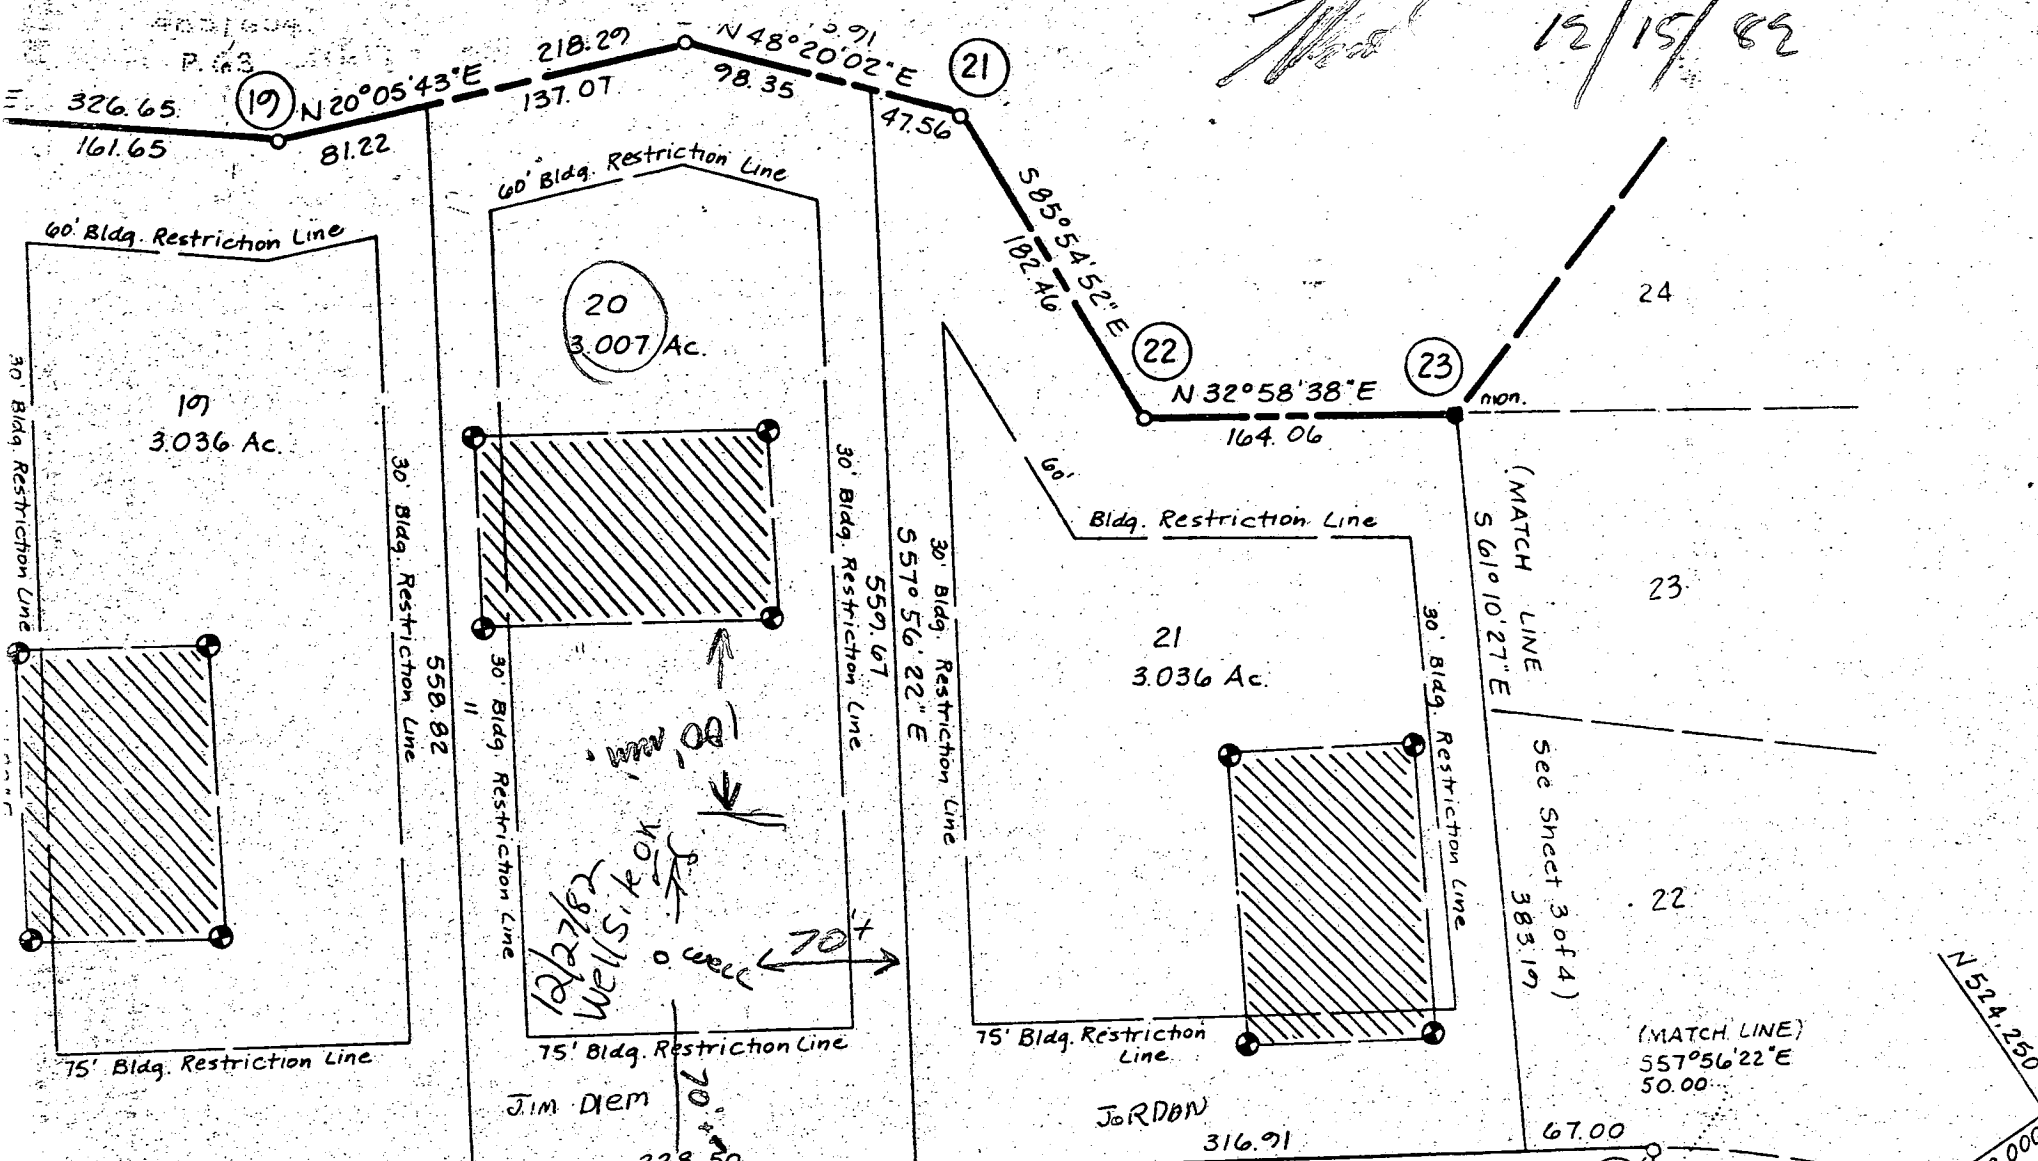

HITCH ROAD

POINT N 32°03'38"E 240.00 S 32°03'38"W 228.50 947.24 316.91 67.00 792,000 R=377.00

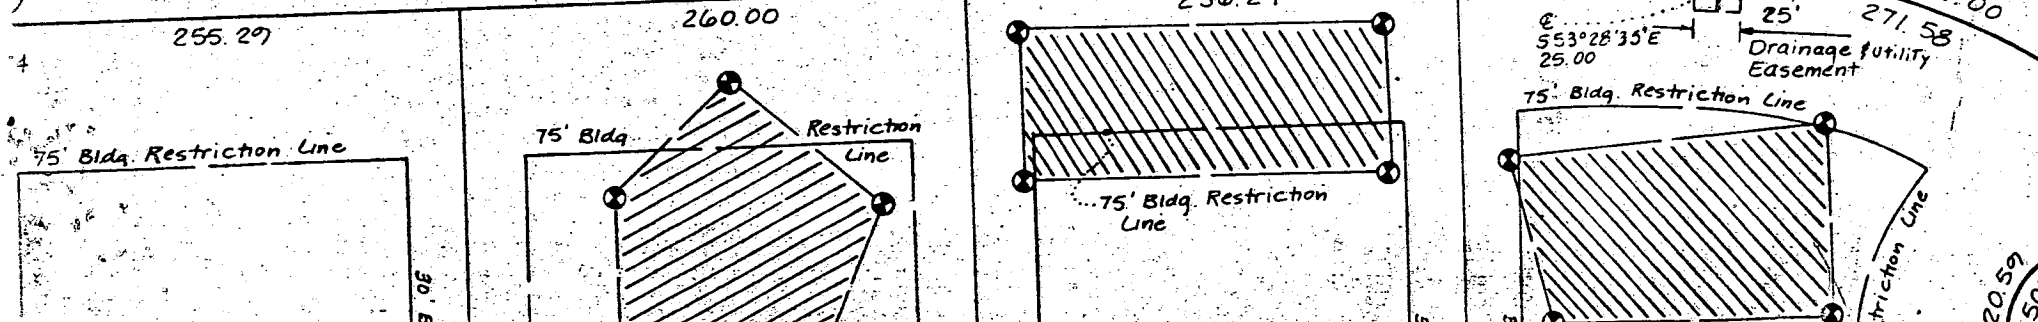

EMERGENCY/TEMP. NO. IF ANY: 8:00 A.M.


B 1 **0514** SEQUENCE NO. (OEP USE ONLY) **3hr pump test after well grant 1/4/83** STATE OF MARYLAND PERMIT TO DRILL WELL

OEP PERMIT NUMBER **HO-73-4357**  
fill in this form completely

Date Received **1/4/83** (OEP Use Only)  
OWNER INFORMATION  
Last Name **Blinkley** First Name **Hold**  
Street or RFD **101 Block 1325**  
Town **Relist Hill** State **MD** Zip **21113**

LOCATION OF WELL  
COUNTY **Howard**  
SUBDIVISION **Countryside Est**  
SECTION **23** LOT **20**  
NEAREST TOWN **Glenwood**  
MILES FROM TOWN (enter 0 if in town) **1**

B 1 Continued DRILLER INFORMATION  
Driller's Name **George Easterday** License No. **41D**  
Firm Name **Franklin Easterday Inc**  
Address **9015 Brown Church Rd Mt Airy MD**  
Signature **George F Easterday** Date **12-15-82**

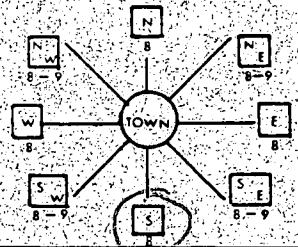B 4 LOCATION OF WELL  
DIRECTION OF WELL FROM TOWN (CIRCLE BOX)  
  
NEAR WHAT ROAD **Countryside Dr.**  
ON WHICH SIDE OF ROAD (CIRCLE APPROPRIATE BOX)  
 WEST  EAST  NORTH  SOUTH  
DISTANCE FROM ROAD **800** FEET

B 2 WELL INFORMATION  
APPROX. PUMPING RATE (GAL. PER MIN.) **5**  
AVERAGE DAILY QUANTITY NEEDED (GAL. PER DAY) **600**

USE FOR WATER (CIRCLE APPROPRIATE BOX)  
 HOME (SINGLE OR DOUBLE HOUSEHOLD UNIT ONLY)  
 FARMING (LIVESTOCK WATERING & AGRICULTURAL IRRIGATION)  
 INDUSTRIAL, COMMERCIAL, STATE AND FEDERAL GOV. OTHER (REQUIRES APPROPRIATION PERMIT)  
 PUBLIC OR PRIVATE WATER COMPANY (REQUIRES APPROPRIATION PERMIT AND STATE HEALTH DEPARTMENT APPROVAL)  
 TEST, OBSERVATION, MONITORING (MAY REQUIRE APPROPRIATION PERMIT)

SHOW MAJOR FEATURES OF BOX & LOCATE WELL WITH AN X  
SOURCES OF DRILLING WATER  
1. **LOCATION OK**  
2. **21' CASING**  
3. **2' ABOVE GROUND**  
4. **18' OPEN**  
WRITE THE BOX NUMBER FROM THE MAP HERE  

E	790
N	520


  
12-30-82 C. Williams

APPROXIMATE DEPTH OF WELL **150** FEET

APPROXIMATE DIAMETER OF WELL **6"** NEAREST INCH

METHOD OF DRILLING (circle one)  
BORED (OR AUGERED)  JETTED  JETTED & DRIVEN   
AIR ROTARY  AIR PERCUSSION  ROTARY (HYDRAULIC ROTARY)   
CABLE  REVERSE ROTARY  DRIVE POINT   
other

REPLACEMENT OR DEEPEINED WELLS (CIRCLE APPROPRIATE BOX)  
 THIS WELL WILL NOT REPLACE AN EXISTING WELL  
 THIS WELL WILL REPLACE A WELL THAT WILL BE ABANDONED AND SEALED  
 THIS WELL WILL REPLACE A WELL THAT WILL BE USED AS A STANDBY  
 THIS WELL WILL DEEPEIN AN EXISTING WELL  
PERMIT NUMBER OF WELL TO BE REPLACED OR DEEPEINED (IF AVAILABLE)

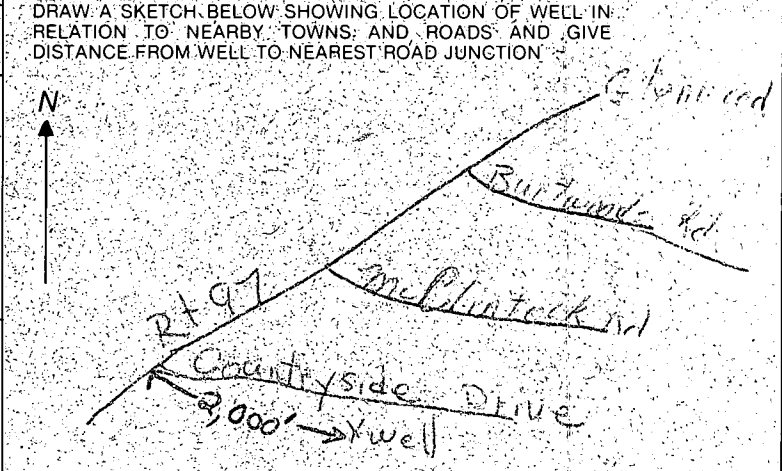

Not to be filled in by driller (OEP USE ONLY)  
APPROX. PERMIT NUMBER **GAP**  
FORCE **F5** WRITE INITIALS IN BOX **PERMIT NO. HO-73-4357**

B 4 NOT TO BE FILLED IN BY DRILLER HEALTH DEPARTMENT APPROVAL  
COUNTY NAME **HOWARD** COUNTY NO. **A 28873**  
OEP SIGNATURE **Frank Shinn** STATE HEALTH CIRCLE BOX   
DATE ISSUED **122782** CO SIGNATURE  
NORTH GRID **523** EAST GRID **0791** EXPIRES **062783**

B 5 SPECIAL CONDITIONS 8-63

To Be Abandoned

# HOWARD COUNTY HEALTH DEPARTMENT



BUREAU OF ENVIRONMENTAL HEALTH  
TIBER PLACE  
8306B FORREST STREET  
ELLCOTT CITY, MARYLAND 21043  
TELEPHONE: 992-2330

December 28, 1982

## WELL PERMIT

Owner's Name: Todd Binkley  
P. O. Box 525  
Reisterstown, Md. 21136

Site: Countryside Estates  
Lot 20  
Countryside Drive

Driller: George F. Easterday

Issue Date: December 27, 1982

Permit Number: HO-73-4357

### Conditions:

1. The water is to be used for a domestic supply.
2. This permit is valid for 6 months.
3. Notify Howard County Health Department 24 hours before grouting appointment for well.
4. A mandatory well yield test as described in COMAR 10.17.13, Well Construction, (effective August 31, 1981) is required.
5. Notify Howard County Health Department 24 hours before start of well yield test.
6. A well completion report and the enclosed well yield test data sheet must be submitted to the administration within 45 days after completion of the well.

CANCELLED and Abandoned

SEE HO-73-4365

RECEIVED

DEC. 29, 1982

W.F. EASTERDAY, INC.

Palmer F. Wine, Director  
Bureau of Environmental Health

PFW: jr

(280ft 20 casing  
1/2 G. pipe. abandon)

RECEIVED  
HOWARD COUNTY  
HEALTH DEPARTMENT  
ELLCOTT CITY  
JAN 10 9 46 AM '83  
JOYCE M. BOYD, M.D., M.P.H.  
COUNTY HEALTH OFFICER

B J 0514

SEQUENCE NO. (OEP USE ONLY)

STATE OF MARYLAND PERMIT TO DRILL WELL

OEP PERMIT NUMBER HO-73-4357

(THIS NUMBER IS TO BE PUNCHED IN COLS. 3-6 ON ALL CARDS)

please print or type

fill in this form completely

Date Received, OWNER INFORMATION, Last Name, Owner, Street or RFD, Town, State, Zip

LOCATION OF WELL, COUNTY, SUBDIVISION, SECTION, LOT, NEAREST TOWN, MILES FROM TOWN

DRILLER INFORMATION, Driller's Name, Firm Name, Address, Signature, Date

DIRECTION OF WELL FROM TOWN, NEAR WHAT ROAD, ON WHICH SIDE OF ROAD, DISTANCE FROM ROAD

WELL INFORMATION, APPROX. PUMPING RATE, AVERAGE DAILY QUANTITY NEEDED

USE FOR WATER, HOME, FARMING, INDUSTRIAL, PUBLIC OR PRIVATE WATER COMPANY, TEST/OBSERVATION


SHOW MAJOR FEATURES OF BOX & LOCATE WELL WITH AN X, SOURCES OF DRILLING WATER, WRITE THE BOX NUMBER FROM THE MAP HERE

APPROXIMATE DEPTH OF WELL

APPROXIMATE DIAMETER OF WELL, NEAREST INCH

METHOD OF DRILLING, BORED (OR AUGERED), JETTED, JETTED & DRIVEN, AIR ROTARY, AIR PERCUSSION, ROTARY (HYDRAULIC ROTARY), CABLE, REVERSE ROTARY, DRIVE POINT

REPLACEMENT OR DEEPEMED WELLS, THIS WELL WILL NOT REPLACE AN EXISTING WELL, THIS WELL WILL REPLACE A WELL THAT WILL BE ABANDONED AND SEALED, THIS WELL WILL REPLACE A WELL THAT WILL BE USED AS A STANDBY, THIS WELL WILL DEEPEM AN EXISTING WELL

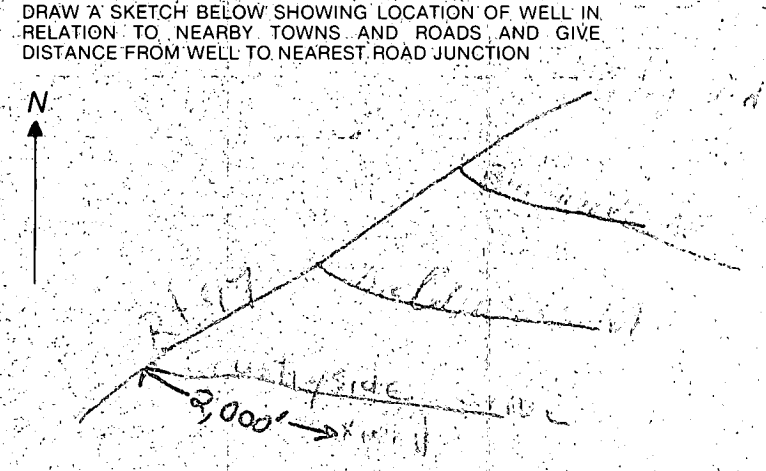

Not to be filled in by driller (OEP USE ONLY), APPROX. PERMIT NUMBER, FORCE, INITIALS, PERMIT No.

NOT TO BE FILLED IN BY DRILLER HEALTH DEPARTMENT APPROVAL, COUNTY NAME, COUNTY NO., OEP SIGNATURE, DATE ISSUED, STATE HEALTH SIGNATURE, NORTH GRID, EAST GRID, EXPIRES

SPECIAL CONDITIONS

Office of Environmental Programs

WELL ABANDONMENT REPORT

Date 4/7/82

Permit Number of abandoned well (if any) 

H	0	-	7	3	-	4	3	5	7
---	---	---	---	---	---	---	---	---	---

Driller's Name George George  
Last First

Owner's Name Binkley Todd  
Last First

Well Location:  
County HOWARD  
Subdivision Countryside  
Section \_\_\_\_\_ Lot 20  
Nearest Town Glenwood  
Maryland Grid Location \_\_\_\_\_

Box Number E 791  
N 523

0/5	5/5
X	
0/0	5/0

Show well location by (x) within box

Type of Well

- Drilled
- Jetted
- Bored or Augered
- Other, specify \_\_\_\_\_

Depth of Well 280 Feet

Type of Casing

- Steel
- Plastic
- Concrete
- Other, specify \_\_\_\_\_

Size of Casing 6 Inches

Was any case removed  Yes  No  
if yes amount removed 8 (feet)

Was casing ripped or perforated  Yes  No

Log of Sealing Material

Material	Feet	
	From	To
<u>dulling casing</u>	<u>280</u>	<u>25</u>
<u>grout</u>	<u>25</u>	<u>4</u>
<u>dirt backfill</u>	<u>4</u>	<u>0</u>

Driller George F. Binkley  
Signature

License # 40

B 4 **0562** SEQUENCE NO. (OEP USE ONLY)

STATE OF MARYLAND PERMIT TO DRILL WELL

OEP PERMIT NUMBER

**HO-73-4365**

(THIS NUMBER IS TO BE PUNCHED IN COLS. 3-6 ON ALL CARDS)

please print or type

fill in this form completely

Date Received **010483**

B 3 LOCATION OF WELL


OWNER INFORMATION  
Last Name 15 **Ripley** Owner **Todd** 34 Name  
Street or RFD **PO BOX 1525** 55  
Town 57 **Adicktown** State **MD** 76 Zip

COUNTY **Howard** 21  
SUBDIVISION **Courty Side** 42  
SECTION **23** 44 46 48 50  
NEAREST TOWN **Brownwood** 52  
MILES FROM TOWN (enter 0 if in town) **1** 73 M I 76 77 78

B 7 Continued DRILLER INFORMATION

Driller's Name **George Portada** 77 License No. **40**  
Firm Name **L.F. Factory, Inc.**  
Address **9265 Brown Church Rd. at Hwy**  
Signature **George Portada** Date

B 4 DIRECTION OF WELL FROM TOWN (CIRCLE BOX)

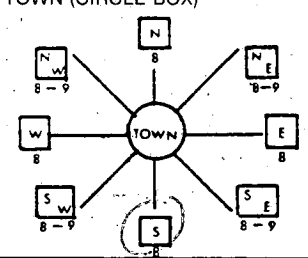

**Courty Side Dr.** 11 NEAR WHAT ROAD 30

ON WHICH SIDE OF ROAD (CIRCLE APPROPRIATE BOX)  
WEST EAST SOUTH NORTH  
**800** 34 DISTANCE FROM ROAD 37 (FT) MI 38 39


B 2 WELL INFORMATION

APPROX. PUMPING RATE (GAL. PER MIN.) **5** 8 12  
AVERAGE DAILY QUANTITY NEEDED (GAL. PER DAY) **100** 14 20

USE FOR WATER (CIRCLE APPROPRIATE BOX)  
 HOME (SINGLE OR DOUBLE HOUSEHOLD UNIT ONLY)  
 FARMING (LIVESTOCK WATERING & AGRICULTURAL IRRIGATION)  
 INDUSTRIAL, COMMERCIAL, STATE AND FEDERAL GOV. OTHER (REQUIRES APPROPRIATION PERMIT)  
 PUBLIC OR PRIVATE WATER COMPANY (REQUIRES APPROPRIATION PERMIT AND STATE HEALTH DEPARTMENT APPROVAL)  
 TEST, OBSERVATION, MONITORING (MAY REQUIRE APPROPRIATION PERMIT)

SHOW MAJOR FEATURES OF BOX & LOCATE WELL WITH AN X

SOURCES OF DRILLING WATER  
1.  
2.  
3.  
WRITE THE BOX NUMBER FROM THE MAP HERE  
E **790 1**  
N **520 3**

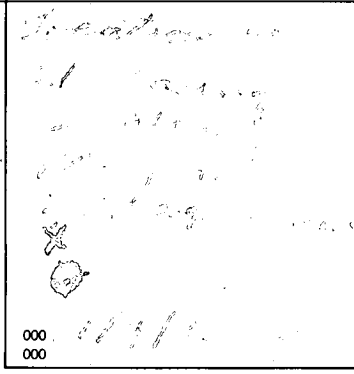

APPROXIMATE DEPTH OF WELL **150** FEET 24 28

APPROXIMATE DIAMETER OF WELL **6** NEAREST INCH

METHOD OF DRILLING (circle one)  
BORED (OR AUGERED) JETTED JETTED & DRIVEN  
30- **AIR ROTARY** AIR PERCUSSION ROTARY (HYDRAULIC ROTARY)  
37 CABLE REVERSE ROTARY DRIVE POINT  
other

REPLACEMENT OR DEEPEINED WELLS (CIRCLE APPROPRIATE BOX)  
 THIS WELL WILL NOT REPLACE AN EXISTING WELL  
 THIS WELL WILL REPLACE A WELL THAT WILL BE ABANDONED AND SEALED  
39  THIS WELL WILL REPLACE A WELL THAT WILL BE USED AS A STANDBY  
 THIS WELL WILL DEEPEIN AN EXISTING WELL PERMIT NUMBER OF WELL TO BE (REPLACED) OR DEEPEINED (IF AVAILABLE) 41 **HO-73-4365** 52

DRAW A SKETCH BELOW SHOWING LOCATION OF WELL IN RELATION TO NEARBY TOWNS AND ROADS AND GIVE DISTANCE FROM WELL TO NEAREST ROAD JUNCTION

Not to be filled in by driller (OEP USE ONLY)  
APPROP. PERMIT NUMBER **GAP** 54 63

B 4 NOT TO BE FILLED IN BY DRILLER HEALTH DEPARTMENT APPROVAL

COUNTY NAME **HOWARD** COUNTY NO. **A28873Z**

OEP SIGNATURE **Frank Shiner** STATE HEALTH CIRCLE BOX **S** 41  
DATE ISSUED **010483**

FORCE **FS** WRITE INITIALS IN BOX PERMIT NO. **HO-73-4365** 70 71 72 73 74 75 76 77 78 79

CO SIGNATURE **Frank Shiner**  
NORTH GRID **523** EAST GRID **0791** EXPIRES **070483**

B 5 SPECIAL CONDITIONS 8-63

C1 6208

SEQUENCE NO. (OEP USE ONLY)

STATE OF MARYLAND WELL COMPLETION REPORT

THIS REPORT MUST BE SUBMITTED WITHIN 45 DAYS AFTER WELL IS COMPLETED.

(THIS NUMBER IS TO BE PUNCHED IN BOLS. 3-6 ON ALL CARDS)

COUNTY NUMBER A 28873 Z

Date Received (OEP use only)

DATE WELL COMPLETED.

Depth of Well

PERMIT NO.

FROM "PERMIT TO DRILL WELL"

010483

220 (TO NEAREST FOOT)

H0-73-4365

OWNER Birkley Todd last name first name STREET OR RFD 3620 Point Hitch Road TOWN Glenwood SUBDIVISION Countryside SECTION LOT 20

WELL LOG Not required for driven wells STATE THE KIND OF FORMATIONS PENETRATED, THEIR COLOR, DEPTH, THICKNESS AND IF WATER BEARING

WELL HAS BEEN GROUTED YES NO TYPE OF GROUTING MATERIAL CEMENT BENTONITE CLAY NO. OF BAGS NO. OF POUNDS GALLONS OF WATER DEPTH OF GROUT SEAL

PUMPING TEST HOURS PUMPED PUMPING RATE METHOD USED TO MEASURE PUMPING RATE WATER LEVEL BEFORE PUMPING WHEN PUMPING TYPE OF PUMP USED

Table with columns: DESCRIPTION, FEET FROM, FEET TO, Check if water bearing. Rows include Top Soil, Red Clay, Gray Mica, Blue Mica, Brown Mica, GRAY Mica, BROWN Mica, GRAY Mica, BLUE Mica, GRAY Mica.

CASING RECORD casing types insert appropriate code below MAIN CASING TYPE Nominal diameter top(main)casing Total depth of main casing

PUMP INSTALLED DRILLER WILL INSTALL PUMP IF DRILLER INSTALLS PUMP, THIS SECTION MUST BE COMPLETED FOR ALL WELLS EXCEPT HOME USE

OTHER CASING (if used) diameter inch depth (feet) from

SCREEN RECORD screen type or open hole insert appropriate code below STEEL BRASS BRONZE OPEN HOLE PLASTIC OTHER

PUMP HORSE POWER PUMP COLUMN LENGTH CASING HEIGHT LAND SURFACE


CIRCLE APPROPRIATE BOX A WELL WAS ABANDONED AND SEALED WHEN THIS WELL WAS COMPLETED ELECTRIC LOG OBTAINED TEST WELL CONVERTED TO PRODUCTION WELL

DEPTH (nearest ft.) SLOT SIZE DIAMETER OF SCREEN (NEAREST INCH)

LOCATION OF WELL ON LOT SHOW PERMANENT STRUCTURE SUCH AS BUILDING, SEPTIC TANKS, AND/OR LANDMARKS AND INDICATE NOT LESS THAN TWO DISTANCES (MEASUREMENTS TO WELL)

I HEREBY CERTIFY THAT THIS WELL HAS BEEN CONSTRUCTED IN ACCORDANCE WITH COMAR 10.17.13 "WELL CONSTRUCTION" AND IN CONFORMANCE WITH ALL CONDITIONS STATED IN THE ABOVE CAPTIONED PERMIT...

GRAVEL PACK IF WELL DRILLED WAS FLOWING WELL CIRCLE BOX OEP USE ONLY (NOT TO BE FILLED IN BY DRILLER) TELESCOPE CASING LOG INDICATOR OTHER DATA

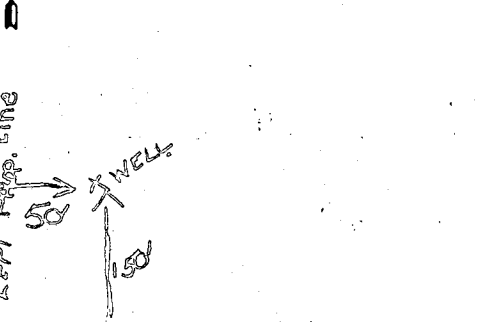




3 A MANGER

485/654

P. 63

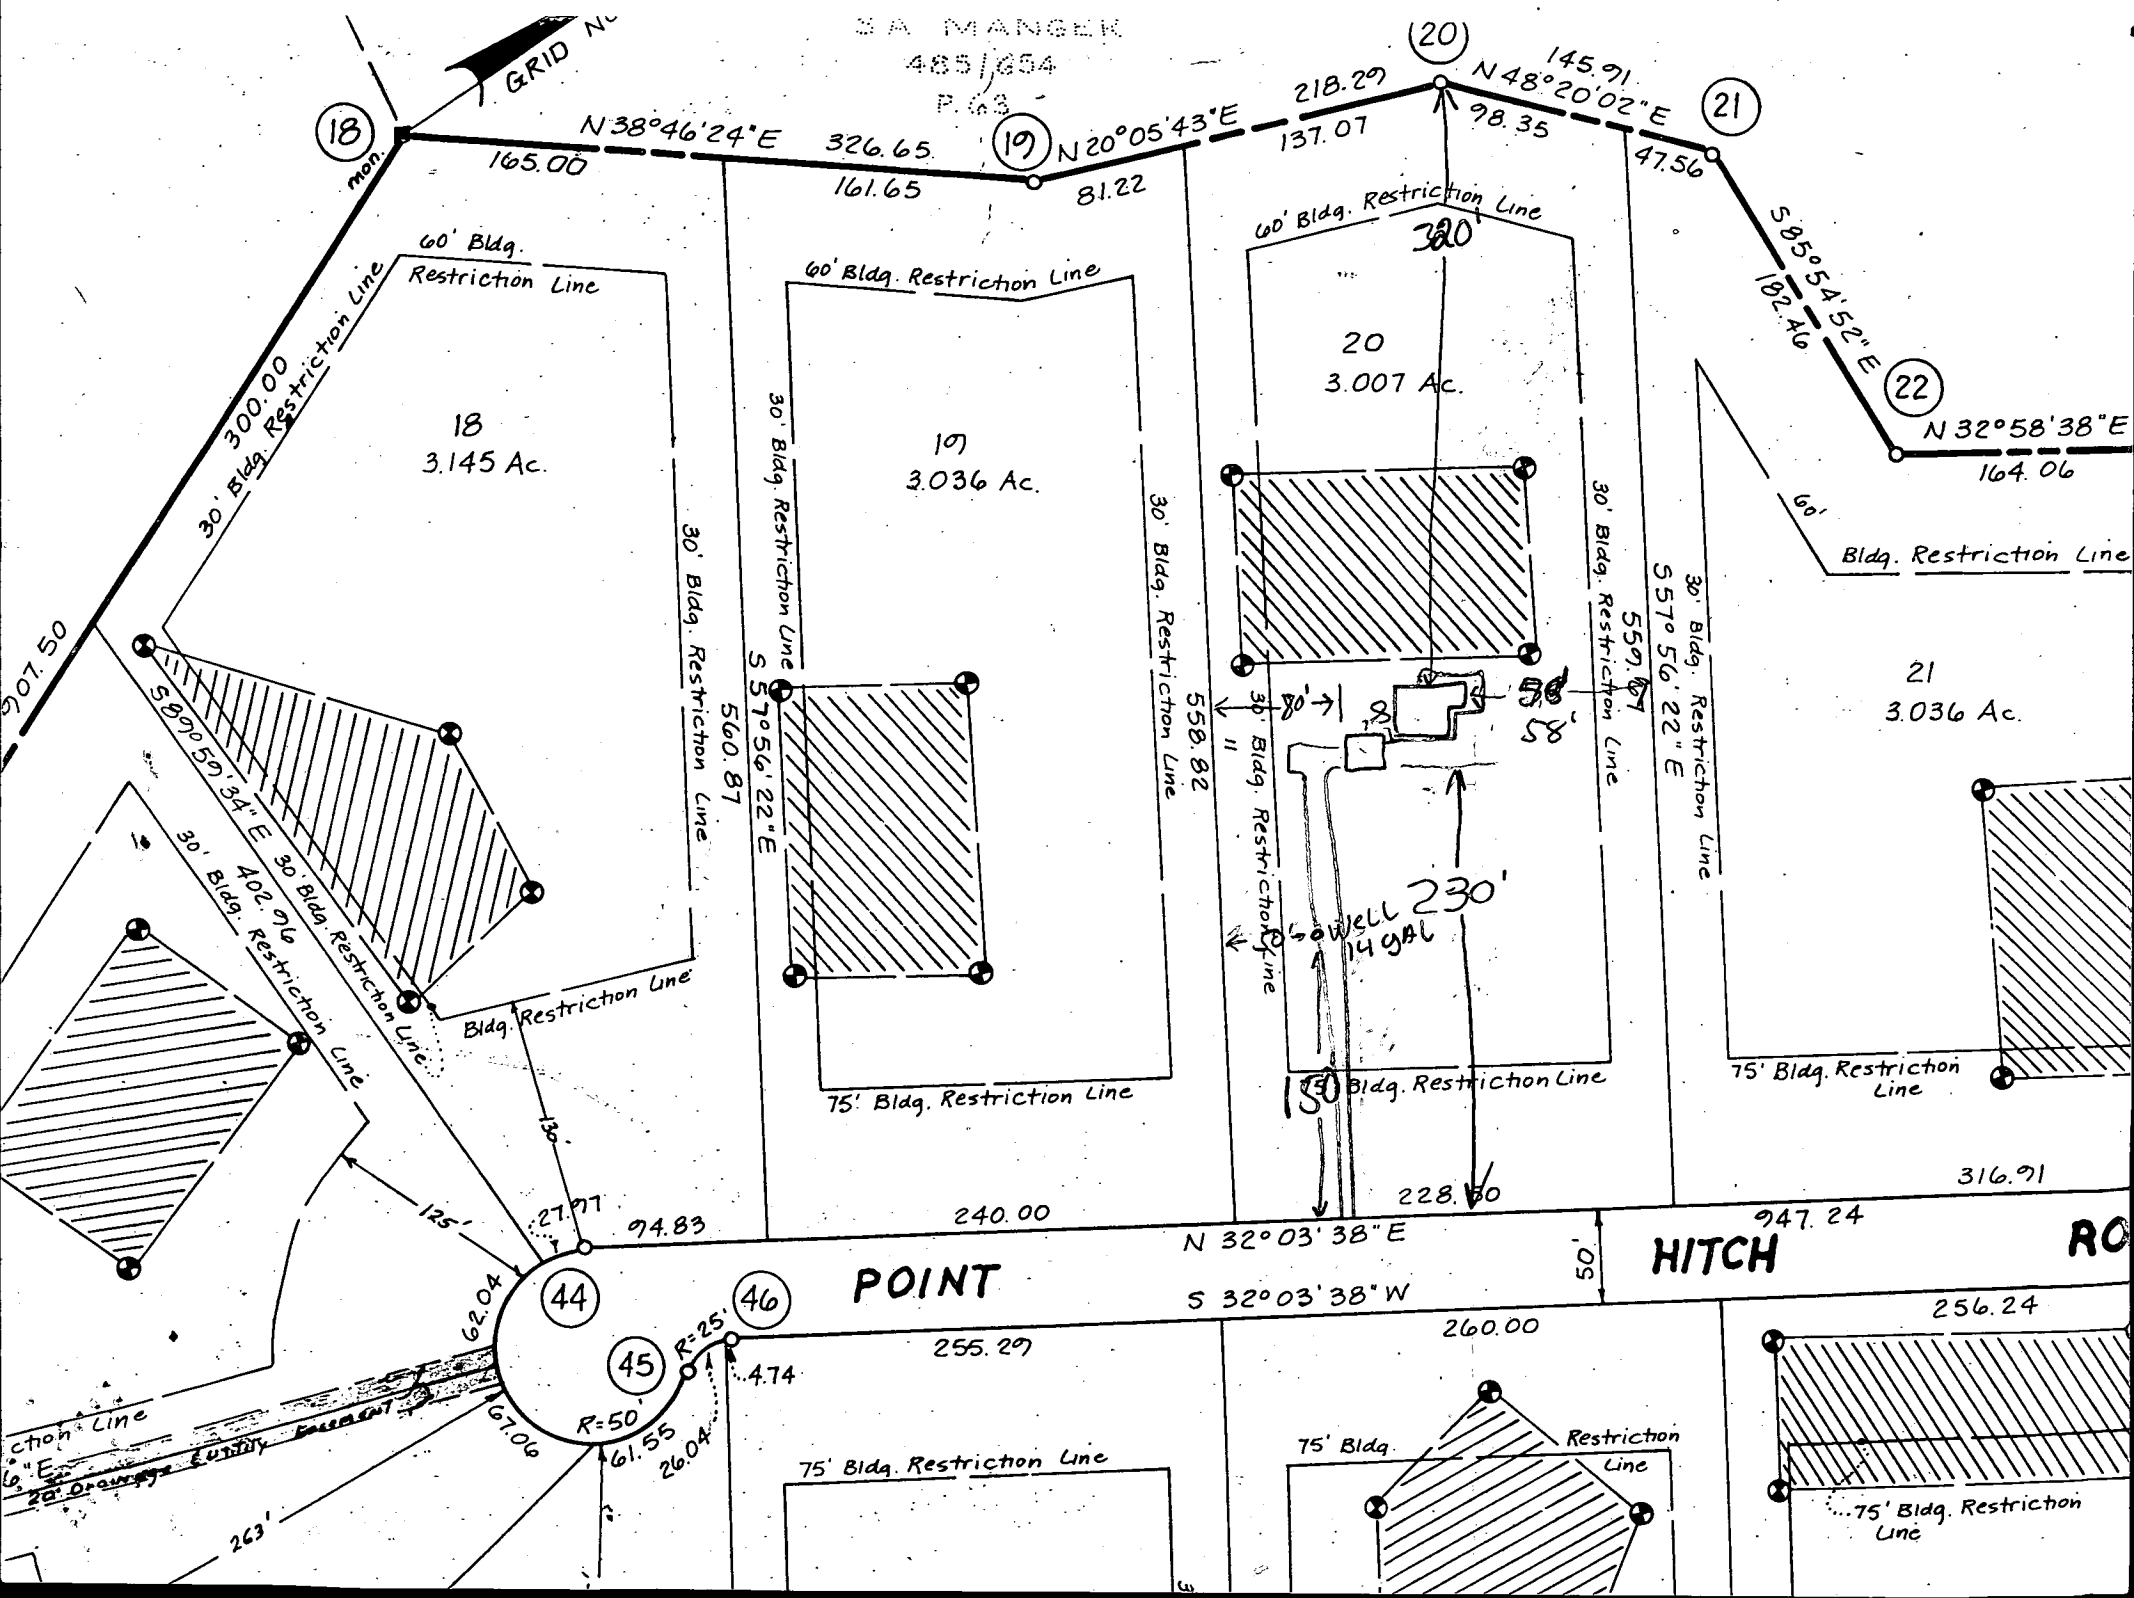

18

19

20

21

22

18

19

20

21

44

46

45

POINT

HITCH

ROAD

75' Bldg. Restriction Line

75' Bldg. Restriction Line

75' Bldg. Restriction Line

Well 230' 14 gal

60' Bldg. Restriction Line

60' Bldg. Restriction Line

60' Bldg. Restriction Line

Bldg. Restriction Line

75' Bldg. Restriction Line

Bldg. Restriction Line

75' Bldg. Restriction Line

Bldg. Restriction Line

263'

20' Drawings Easement

Restriction Line

907.50

300.00  
30' Bldg. Restriction Line

30' Bldg. Restriction Line  
570.56' 22" E  
560.87

30' Bldg. Restriction Line  
558.82

30' Bldg. Restriction Line  
559.67

30' Bldg. Restriction Line  
557.56' 22" E

182.46  
S 85° 54' 52" E

316.91

947.24

240.00

N 32° 03' 38" E

S 32° 03' 38" W

27.77

R=50

4.74

125'

R=25

61.55

26.04

67.06

62.04

61.55

26.04

61.55

26.04

61.55


26.04

61.55

26.04

61.55

WELL ELEV. 5' 3"  
 BASEMENT ELEV. -1' 0"  
 1ST FLOOR ELEV. 8' 0"  
 OUT OF HOUSE ELEV. 2' 9"  
 INTO TANK ELEV. 2' 6"  
 OUT OF TANK ELEV. 2' 3"  
 INTO DIST. BOX ELEV. 2' 1"  
 PERC. ELEV. 5' 1"

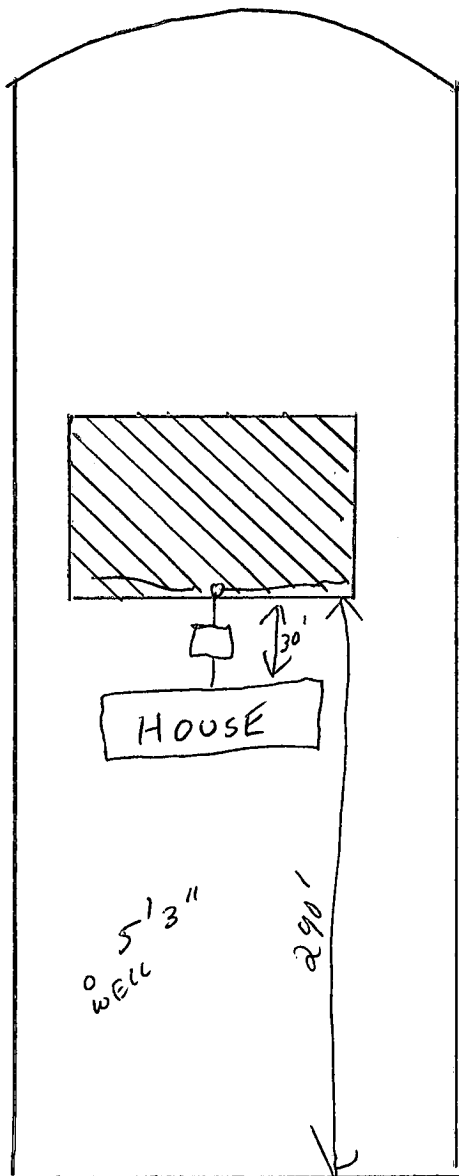


1/20/83  
 Sketch OK  
 J.S.

POINT HITCH ROAD

LOT 20

TODD A. CONTRACTORS

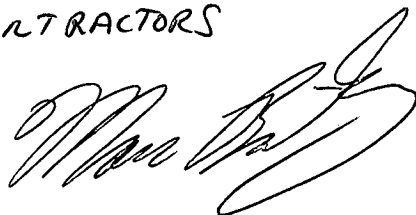
 1/19/83