

copy 6-13-79. JF. 12/14/78

P.C.O

SYSTEM TO BE INSTALLED FIRST
BEFORE BUILDING PERMIT IS
SIGNED.

PERMIT

P 29276
A 28908

SEWAGE DISPOSAL SYSTEM

MARYLAND STATE DEPARTMENT OF HEALTH

HOWARD COUNTY

02-225972

ELLICOTT CITY

DISTRICT 2nd

DATE 11/27/78

12/14/78
12/21/78

INDEXED

Commercial Excavating

IS PERMITTED TO INSTALL ALTER

ADDRESS _____ PHONE _____

SUBDIVISION _____ ROAD 3174 Boones Lane LOT _____

PROPERTY OWNER James A. Hagan - John & Sharon Hagens

ADDRESS 1926 Pine Knob Road, Sykesville, Md.

SPECIFICATIONS 3 bedrooms

SEPTIC TANK CAPACITY 1000 GALLONS

DRAIN FIELD _____ DEPTH _____ FEET, BOTTOM AREA _____ SQ. FT.

DEEP TRENCH _____ DEPTH _____ FEET, BOTTOM AREA _____ SQ. FT.

SEEPAGE PITS _____ ABSORBENT SIDE-WALL AREA 360 SQ. FT. total area in dry well.

INLET PIPE 2 FT. BELOW ORIGINAL GRADE. MAXIMUM DEPTH 8 FT. BELOW ORIGINAL GRADE

EFFECTIVE DEPTH AT _____ FT. BELOW ORIGINAL GRADE.

LOCATE DISPOSAL AREA 69 FT. FROM rear LOT LINE AND 36 FT. FROM right LOT LINE AS SEEN WHEN
FACING LOT FROM Boones Lane.

PLANS APPROVED BY James Wright DATE 10/8/69

COVER NO WORK UNTIL INSPECTED AND APPROVED.

NEITHER THE HOWARD COUNTY COUNCIL NOR THE HEALTH DEPARTMENT IS RESPONSIBLE FOR THE SUCCESSFUL OPERATION OF ANY SYSTEM.

NOTE: IF TRENCH IS USED CALL FOR INSPECTION BEFORE PLACING GRAVEL IN TRENCH.

NOTE: NO DRY WELL SHALL EXCEED 15 FOOT IN DIAMETER.

NOTE: ALL PIPE FROM HOUSE TO DISPOSAL AREA MUST BE CAST IRON.

PERMIT VOID AFTER THREE YEARS.

NOTE: INSTALL STAND PIPE ON SEPTIC TANK AND DRY WELL. STAND PIPES MUST BE 6 INCHES IN DIAMETER. CAST IRON, CONCRETE OR TERRA
COTTA ACCEPTED.

BLDG. PERMIT SIGNED
AND RETURNED 12/22/78
Serial No. 37850


A 28908

*INSTALLER IS RESPONSIBLE FOR OBTAINING FINAL APPROVAL ON THIS PERMIT.

HD - 23.

2/8/86
CANCELLED BY
PERMITS DEPT.

BLDG. PERMIT SIGNED
AND RETURNED 4/15/85
Serial # 60246 -
2-Story addition

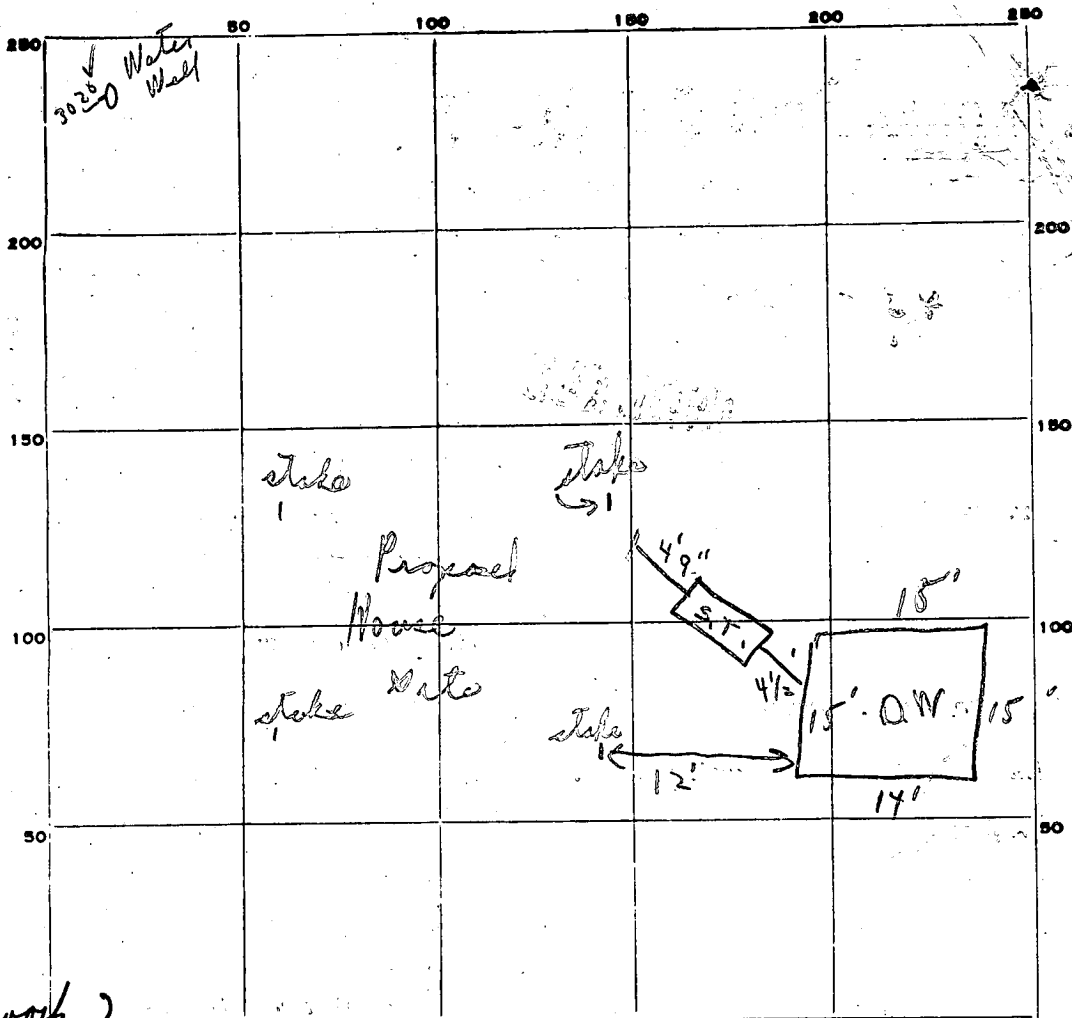

4/3/79
 ↑ Checked
 house up
 no plumbing
 from house
 to tank.
 Mr. Jerry Noyes C. P.D.
 on site to call when
 house connection
 made. c.B.D.

Stop work
 6/6/79 New card
 in front window

INDICATE NORTH. - NAME ADJOINING ROADWAY AS BASE LINE.

PERMIT CARD C.B.D.

- (2) Yes at entrance Boones Lane
- (1) Yes at entrance
- (3) Yes at entrance

S.T.	D.W.
ok	ok
C.I.	C.I.

SEPTIC TANK, LEVEL

CLEANOUTS

DISTRIBUTION BOX, LEVEL

TILE FIELD, DEPTH _____ FT. TRENCH WIDTH _____ FT.

GRAVEL DEPTH _____ IN. TOTAL LENGTH _____ FT.

NUMBER OF TRENCHES _____ TOTAL BOTTOM AREA _____
outside perimeter 59 6' counted (1) 354⁺

SEEPAGE PITS, INSIDE DIAMETER 59 FT. DEPTH BELOW INLET 6.5 FT.

ABSORBENT AREA 354⁺ SQ. FT.

↑ cleanout solid unable to get depth

REMARKS 12/14/78 (1) Checked - found no house; water well coordinated, future house staked; partial need house connection; dig well in area called for; stop work - check with supervisor about dig well only 12' from house stake; also req'd cleanout open to check depth of dig well.
 12/21/78 (2) Hold for statement - that tank shall be 10' from house and dig well 20'; also need to check house connection and dig well cleanout needs plug - partial c.B.D. @ 1/3/79 No charge c.B.D.
 6/6/79 Area near house graded & seeded. c.B.D. stop work

DATE SYSTEM APPROVED 6-13-79

INSPECTOR

6/6/79 Area near house graded & seeded. c.B.D. stop work

*Retest
2 hole perc*

APPLICATION

A 28908

SEWAGE DISPOSAL TESTING

STATE OF MARYLAND - DEPARTMENT OF HEALTH AND MENTAL HYGIENE

P _____

HOWARD COUNTY HEALTH DEPARTMENT
ENVIRONMENTAL HEALTH SERVICES
P.O. BOX 476, ELLICOTT, MARYLAND 21043
TELEPHONE: 992-2330

DISTRICT 2nd

DATE 9/22/78

*Go with old
spec. system
first.*

TO: THE COUNTY HEALTH OFFICER
ELLICOTT CITY, MARYLAND

I HEREBY APPLY FOR THE NECESSARY TEST IN ORDER TO CONSTRUCT (OR RECONSTRUCT) A SEWAGE DISPOSAL SYSTEM.

PROPERTY OWNER John Lindey (Contract Purchaser - James A. Hagen)

ADDRESS 1926 Pine Knob Road, Sykesville, Md, 21784 PHONE 795-5808

PROPERTY LOCATION:

SUBDIVISION _____ LOT NO. _____

ROAD AND DESCRIPTION next door to 3178 Boone's Lane

SIZE OF LOT 20,000 sq. ft. m/1 TYPE BLDG. 3 or 4 bedrooms

THE SYSTEM INSTALLED UNDER THIS APPLICATION IS ACCEPTABLE ONLY UNTIL PUBLIC FACILITIES BECOME AVAILABLE.

I FULLY UNDERSTAND THE FEE CONNECTED WITH THE FILING OF THIS PERC TEST APPLICATION IS NON-REFUNDABLE UNDER ANY CIRCUMSTANCES.

SIGNATURE OF APPLICANT James A. Hagen

APPROVED BY _____ FOR _____ DATE _____

REJECTED BY JJ FOR _____ DATE 9/25/78

HOLD PENDING FURTHER TESTS _____ DATE _____

REASONS FOR REJECTION OR HOLDING WATER - AT 11 FT. TWO BOTTOM HOLES
HOLD FOR WET SEASON - DM - 9/25/78
to go with orig perc - system first

THIS IS NOT A PERMIT

SOIL PROFILE

0'

INDICATE NORTH - NAME ADJOINING ROADWAY AS BASE LINE.

DATE	TEST NO.	DEPTH	PRE-WET		TEST - 1" DROP		TIME
			START	STOP	START	STOP	

REMARKS _____

TYPE OF SOIL _____

TESTED BY _____ ALSO PRESENT _____

APPLICATION

A 14794

SEWAGE DISPOSAL TESTING

P _____

MARYLAND STATE DEPARTMENT OF HEALTH

HOWARD COUNTY *Septic tank to be 1000 gallons* ELLICOTT CITY

Dry well to be 360 sq ft of absorbent DISTRICT 2

sidewall area below the inlet pipe. Inlet DATE 9/9/69

pipe to be 2 ft below original grade. Maximum depth of dry

well to be ~~8~~ ⁸ ft below original grade. Located dry well

69 ft from rear lot line and 36 ft from right side line. As lot

is seen from standing on Boone's Lane facing lot

System to be installed before house is built.

TO: THE COUNTY HEALTH OFFICER
ELLICOTT CITY, MARYLAND

I, HEREBY, APPLY FOR THE NECESSARY TESTS IN ORDER TO CONSTRUCT (OR RECONSTRUCT) A SEWAGE DISPOSAL SYSTEM.

PROPERTY OWNER Lester W. & Dorothy V. Pruitt

ADDRESS 3178 Boone's Lane, Ellicott City, Md. PHONE HO 5-6055

PROPERTY LOCATION:

SUBDIVISION _____ LOT NO. _____

ROAD AND DESCRIPTION Boone's Lane - off Rt. 40 - next door to 3178 Boone's Lane

OCCUPANT _____ PHONE _____

PERSON TO CONSTRUCT SYSTEM _____

ADDRESS _____ PHONE Com. EXLAW

SIZE OF LOT 20,000 sq. ft. TYPE BLDG. 3 bed.

NUMBER OF BEDROOMS
(Single Family Dwllg.)

IF NOT SINGLE RESIDENCE DESCRIBE _____

SIGNATURE OF APPLICANT Dorothy V. Pruitt

APPROVED BY James S. Wright FOR Dry well DATE 10/8/69

(KIND OF SYSTEM)

REJECTED BY _____ FOR _____ DATE _____


(KIND OF SYSTEM)

HOLD PENDING FURTHER TESTS _____ DATE _____

REASONS FOR REJECTION OR HOLDING _____

THIS IS NOT A PERMIT

*10/8/69
9:30*

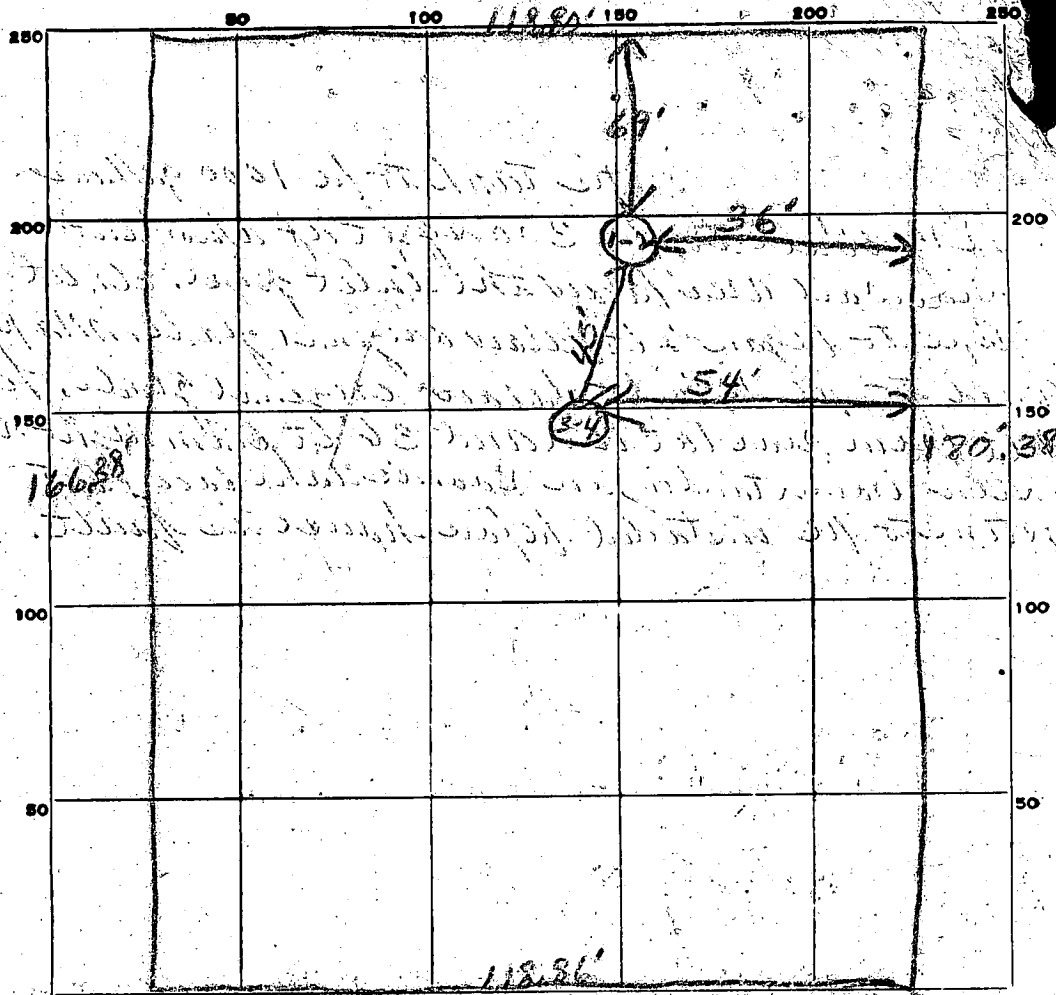

INDICATE NORTH. - NAME ADJOINING ROADWAY AS BASE LINE.

Boones Lane

DATE	TEST NO.	DEPTH	PRE-WET		TEST - 1" DROP		TIME
			START	STOP	START	STOP	
10/18/69	1	12'	9 ³²	9 ⁴⁰	9 ⁴⁰	9 ⁴⁴	4 in
	2	3'	9 ⁴²	9 ⁴³	9 ⁴³	9 ⁴⁴	1 in
	3	10'	9 ⁵³	10 ⁰¹	10 ⁰¹	10 ⁰⁴	3 in
	4	3'	9 ⁵⁹	10 ⁰⁰	10 ⁰⁰	10 ⁰¹	1 in

SOIL AUGER FINDING _____

TESTED BY *[Signature]*

REMARKS *System to be installed before house is built*

APPLICATION

A 14794

P

SEWAGE DISPOSAL TESTING

MARYLAND STATE DEPARTMENT OF HEALTH

HOWARD COUNTY *Septic tank to be 1000 gallons* ELLICOTT CITY

DISTRICT 2

DATE 9/9/69

*Dry well to be 360 sq ft of absorbent
sidewall area below the inlet pipe. Inlet
pipe to be 2 ft below original grade. Maximum depth of dry
well to be 8 ft below original grade. Located dry well
64 ft from rear lot line and 36 ft from right side line. As lot
is seen from standing on Boone's Lane facing lot
system to be installed before house is built.*

TO: THE COUNTY HEALTH OFFICER
ELLICOTT CITY, MARYLAND

I, HEREBY, APPLY FOR THE NECESSARY TESTS IN ORDER TO CONSTRUCT (OR RECONSTRUCT) A SEWAGE DISPOSAL SYSTEM.

PROPERTY OWNER Lester W. & Dorothy V. Pruitt

ADDRESS 3178 Boone's Lane, Ellicott City, Md. PHONE HO 5-6055

PROPERTY LOCATION:

SUBDIVISION _____ LOT NO. _____

ROAD AND DESCRIPTION Boone's Lane off Rt. 40 next door to 3178 Boone's Lane

OCCUPANT _____ PHONE _____

PERSON TO CONSTRUCT SYSTEM _____ PHONE _____

ADDRESS _____ PHONE _____

SIZE OF LOT 20,000 sq. ft. TYPE BLDG. 2

NUMBER OF BEDROOMS
(Single Family Dwllg.)

IF NOT SINGLE RESIDENCE DESCRIBE _____

SIGNATURE OF APPLICANT Dorothy V. Pruitt


APPROVED BY James T. Wright FOR Dry well DATE 10/8/69
(KIND OF SYSTEM)

REJECTED BY _____ FOR _____ DATE _____
(KIND OF SYSTEM)

HOLD PENDING FURTHER TESTS _____ DATE _____

REASONS FOR REJECTION OR HOLDING _____

THIS IS NOT A PERMIT

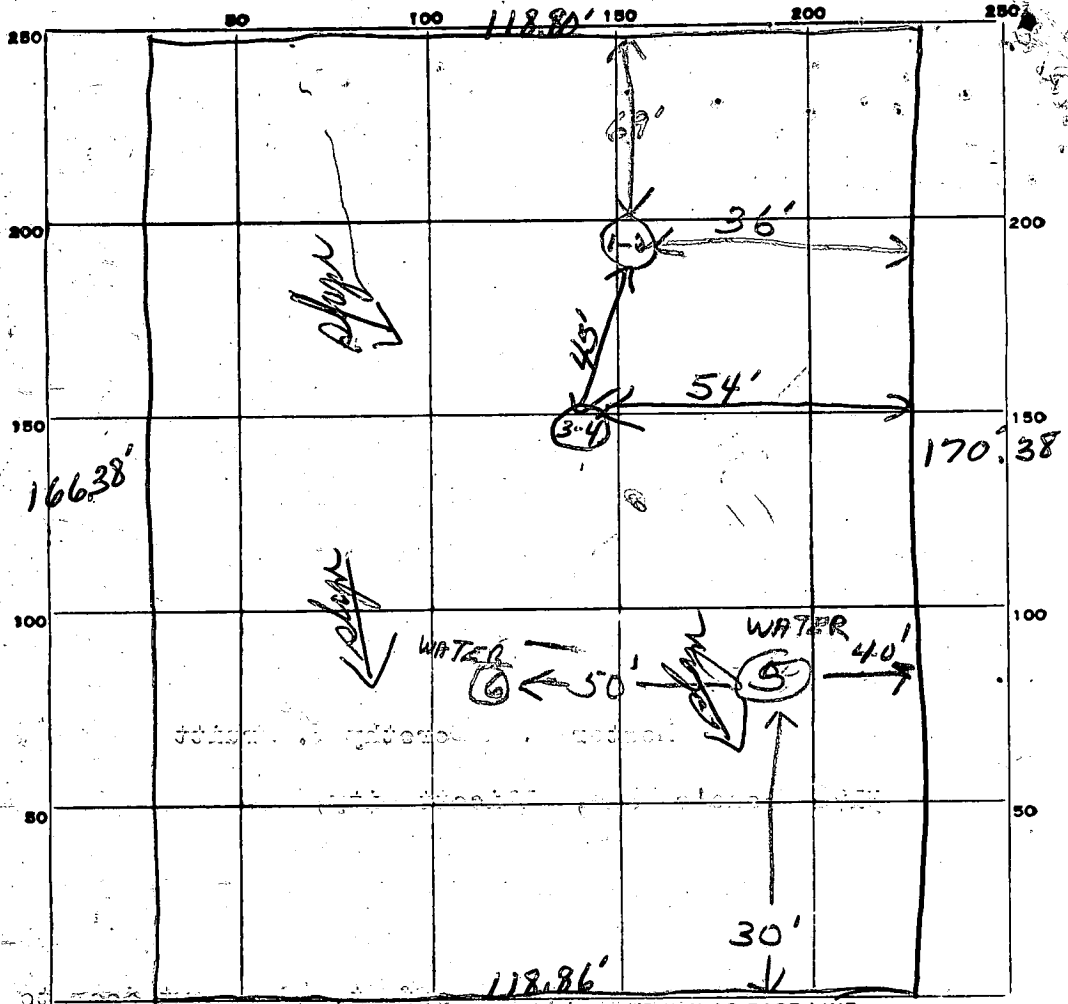

INDICATE NORTH. - NAME ADJOINING ROADWAY AS BASE LINE.

Boones Lane

DATE	TEST NO.	DEPTH	PRE-WET		TEST - 1" DROP		TIME
			START	STOP	START	STOP	
10/8/69	1	12'	939	940	940	944	4in
	2	3'	942	943	943	944	1in
	3	10'	958	1001	1001	1004	3in
	4	3'	959	1000	1000	1001	1in
9/25/72	5	12	WATER AT 11 FT				
	6	12				11 FT	

SOIL AUGER FINDING

TESTED BY *[Signature]*

REMARKS *System to be installed before house is built*

5040
 1 2 3 (SEQ. NO.) 6
 THIS NUMBER IS TO BE PUNCHED
 IN COLS. 3-6 ON ALL CARDS

STATE OF MARYLAND
 WATER RESOURCES ADMINISTRATION
 TAWES STATE OFFICE BLDG., ANNAPOLIS, MARYLAND 21401
 APPLICATION FOR PERMIT TO DRILL WELL

WRA PERMIT NUMBER
 FILL IN THIS FORM COMPLETELY

DATE RECEIVED
 (WRA USE ONLY)
 11/1/78
 9:30 a.m.

OWNER: HAGAN JERRY
 COL 18 LAST NAME COL 34 FIRST NAME
 STREET OR RFD: 1936 PINE KNOB RD
 COL 36 COL 58
 POST OFFICE: SYKESVILLE MD 21784
 COL 57 COL 76

B 1 CONTINUED DRILLER INFORMATION
 1 2 3 (SEQ. NO.) 6
 DATE: 10/5/78
 LICENSE NUMBER: 209
 77 80
 HOWARD DILLON
 FIRST NAME DRILLER LAST NAME
 SIGNATURE: *Howard Dillon*

B 3 LOCATION OF WELL
 1 2 3 (SEQ. NO.) 6
 COUNTY: HOWARD
 (DO NOT ABBREVIATE COUNTY NAME)
 SUBDIVISION: 29
 SECTION: NEXT TO 3178 LOT
 44 46 48 50
 NEAREST TOWN: ELLICOTT CITY
 52 54
 MILES FROM TOWN (ENTER 0 IF IN TOWN): 4
 73 76 77 78

B 2 WELL INFORMATION
 1 2 3 (SEQ. NO.) 6
 MAXIMUM PUMPING RATE (GALLONS PER MINUTE): 5
 8 12
 AVERAGE DAILY QUANTITY NEEDED (GALLONS PER DAY): 300
 14 20

B 4 DIRECTION FROM TOWN
 (CIRCLE APPROPRIATE BOX)
 1 2 3 (SEQ. NO.) 6
 N NORTH E EAST NE NORTHEAST SE SOUTHEAST
 S SOUTH W WEST NW NORTHWEST SW SOUTHWEST
 8 8 9 9
 NEAR WHAT ROAD: 3178 BOONS LAKE
 11 NORTH SOUTH EAST WEST 31
 ON WHICH SIDE OF ROAD (CIRCLE APPROPRIATE BOX) N S E W
 32 32 32 32
 DISTANCE FROM ROAD (ENTER DISTANCE AND CIRCLE APPROPRIATE BOX): 100
 34 37 39


USE FOR WATER (CIRCLE APPROPRIATE BOX)
 HOME (SINGLE OR DOUBLE HOUSEHOLD UNIT ONLY)
 F FARMING, AGRICULTURE, IRRIGATION
 I INDUSTRIAL, COMMERCIAL, STATE AND FEDERAL GOVERNMENT.
 M MUNICIPAL WATER SUPPLY
 P PRIVATE WATER COMPANY } MUST HAVE STATE HEALTH DEPT. APPROVAL
 T TEST

DRAW A SKETCH BELOW SHOWING LOCATION OF WELL IN RELATION TO NEARBY TOWN ROADS AND STREAMS WITH NORTH IN THE DIRECTION OF THE ARROW, AND GIVE DISTANCE FROM WELL TO NEAREST ROAD JUNCTION OR STREAM CROSSING SHOWN ON SKETCH. ALSO SHOW, BY MEANS OF AN "X", THE WELL LOCATION IN THE BOX BELOW AND THE BOX NUMBER FROM THE WELL LOCATION MAP.

APPROXIMATE DEPTH OF WELL: 200 FEET
 24 26

APPROXIMATE DIAMETER OF WELL: 6 (NEAREST INCH)

METHOD OF DRILLING USED (CIRCLE APPROPRIATE METHOD)
 BORED (OR AUGERED) JETTED DRIVEN
 30-37 AIR-ROTARY AIR-PERCUSSION ROTARY (HYDRAULIC ROTARY)
 CABLE REVERSE-ROTARY DRIVE-POINT
 OTHER (DESCRIBE):

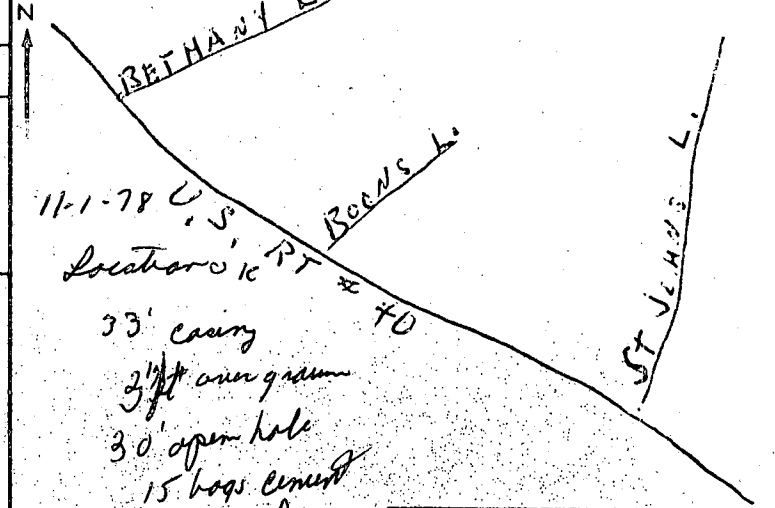

REPLACEMENT OR DEEPEMED WELLS (CIRCLE APPROPRIATE BOX)
 THIS WELL WILL NOT REPLACE AN EXISTING WELL
 THIS WELL WILL REPLACE A WELL THAT WILL BE ABANDONED AND SEALED
 THIS WELL WILL REPLACE A WELL THAT WILL BE USED AS A STANDBY
 THIS WELL WILL DEEPEM AN EXISTING WELL PERMIT NUMBER OF WELL TO BE REPLACED OR DEEPEMED (IF AVAILABLE):
 41 52

NOT TO BE FILLED IN BY DRILLER (WRA USE ONLY)
 APPROPRIATION PERMIT NUMBER: 54
 ENGINEER REVIEW DISTRICT NO.: 65
 FORCE: WRITE INITIALS IN BOX: 67 68
 CONDITIONS: A E N S G W Q C L U J
 70 71 72 73 74 75 76 77 78 79

BOX NUMBER: E 840, N 520
 NORTH COORDINATE: 50 51 52 53 54 55
 EAST COORDINATE: 57 58 59 60 61 62 63
 ELEVATION AT WELL HEAD (FEET): 65 66 67 68
 0/0 5/0

B 4 CONTINUED HEALTH DEPARTMENT APPROVAL
 1 2 3 (SEQ. NO.) 6
 STATE HEALTH (CIRCLE BOX): 5
 COUNTY NAME: Howard COUNTY NO.: W28998
 DATE: 10 11 78
 APPROVED BY: *Donald W. Monaghan*
 Donald W. Monaghan, Sanitarian

B 5 SPECIAL CONDITIONS 8-63 (WRA USE ONLY)
 1 2 3 (SEQ. NO.) 6

B 1 5040
 SEQUENCE NO. (WRA USE ONLY)
 1 2 3 (SEQ. NO.) 6
 (THIS NUMBER IS TO BE PUNCHED IN COLS. 3-6 ON ALL CARDS)

STATE OF MARYLAND
WATER RESOURCES ADMINISTRATION
 TAWES STATE OFFICE BLDG., ANNAPOLIS, MARYLAND 21401
APPLICATION FOR PERMIT TO DRILL WELL

WRA PERMIT NUMBER
 HC 70 400
 FILL IN THIS FORM COMPLETELY

DATE RECEIVED (WRA USE ONLY)

OWNER HAGAN JERRY
 COL 15 LAST NAME FIRST NAME COL. 34
 STREET OR RFD 1926 PINE KNOB RD
 COL 36 COL. 55
 POST OFFICE SYKESVILLE MD 21784
 COL 57 COL. 76

B 1 CONTINUED **DRILLER INFORMATION**
 1 2 3 (SEQ. NO.) 6
 DATE 10/5/78 LICENSE NUMBER 209
 77 80
 FIRST NAME HOWARD DRILLER D. How LAST NAME
 SIGNATURE Howard E. How

B 3 **LOCATION OF WELL**
 1 2 3 (SEQ. NO.) 6
 COUNTY HOWARD
 (DO NOT ABBREVIATE COUNTY NAME) 21
 SUBDIVISION 254 42
 SECTION NEXT TO 3178 LOT 48 50
 NEAREST TOWN ELLICOTT CITY 52
 MILES FROM TOWN (ENTER 0 IF IN TOWN) 4 71
 73 76 77 78

B 2 **WELL INFORMATION**
 1 2 3 (SEQ. NO.) 6
 MAXIMUM PUMPING RATE (GALLONS PER MINUTE) 5 8 12
 AVERAGE DAILY QUANTITY NEEDED (GALLONS PER DAY) 300 14 20
 USE FOR WATER (CIRCLE APPROPRIATE BOX)
 HOME (SINGLE OR DOUBLE HOUSEHOLD UNIT ONLY)
 FARMING, AGRICULTURE, IRRIGATION
 INDUSTRIAL, COMMERCIAL, STATE AND FEDERAL GOVERNMENT.
 MUNICIPAL WATER SUPPLY } MUST HAVE STATE HEALTH DEPT. APPROVAL
 PRIVATE WATER COMPANY }
 TEST

B 4 **DIRECTION FROM TOWN**
 (CIRCLE APPROPRIATE BOX)
 1 2 3 (SEQ. NO.) 6
 N NORTH E EAST NE NORTHEAST SE SOUTHEAST
 S SOUTH W WEST NW NORTHWEST SW SOUTHWEST
 NEAR WHAT ROAD 3178 BOONS LANE
 ON WHICH SIDE OF ROAD (CIRCLE APPROPRIATE BOX)
 N NORTH S SOUTH E EAST W WEST
 DISTANCE FROM ROAD (ENTER DISTANCE AND CIRCLE APPROPRIATE BOX) 100 37
 38 39

APPROXIMATE DEPTH OF WELL 300 FEET
 24 28

APPROXIMATE DIAMETER OF WELL 6 (NEAREST INCH)

METHOD OF DRILLING USED (CIRCLE APPROPRIATE METHOD)
 BORED (OR AUGERED) JETTED DRIVEN
 30-37 AIR-ROTARY AIR-PERCUSSION ROTARY (HYDRAULIC ROTARY)
 CABLE REVERSE-ROTARY DRIVE-POINT
 OTHER (DESCRIBE)

REPLACEMENT OR DEEPEINED WELLS (CIRCLE APPROPRIATE BOX)
 THIS WELL WILL NOT REPLACE AN EXISTING WELL
 THIS WELL WILL REPLACE A WELL THAT WILL BE ABANDONED AND SEALED
 THIS WELL WILL REPLACE A WELL THAT WILL BE USED AS A STANDBY
 THIS WELL WILL DEEPEIN AN EXISTING WELL
 PERMIT NUMBER OF WELL TO BE REPLACED OR DEEPEINED (IF AVAILABLE)

NOT TO BE FILLED IN BY DRILLER (WRA USE ONLY)
 APPROPRIATION PERMIT NUMBER 54 ENGINEER REVIEW DISTRICT NO. 63
 FORCE AW WRITE INITIALS IN BOX CONDITIONS AW
 67 68 70 71 72 73 74 75 76 77 78 79

B 4 CONTINUED **HEALTH DEPARTMENT APPROVAL**
 1 2 3 (SEQ. NO.) 6
 41 STATE HEALTH (CIRCLE BOX) COUNTY NAME Howard COUNTY NO. W28998
 DATE 10/01/78 APPROVED BY Donald W. Monaghan, Sanitarian
 43 48

DRAW A SKETCH BELOW SHOWING LOCATION OF WELL IN RELATION TO NEARBY TOWNS, ROADS AND STREAMS WITH NORTH IN THE DIRECTION OF THE ARROW, AND GIVE DISTANCE FROM WELL TO NEAREST ROAD JUNCTION OR STREAM CROSSING SHOWN ON THE SKETCH. ALSO SHOW, BY MEANS OF AN "X", THE WELL LOCATION IN THE BOX BELOW AND THE BOX NUMBER FROM THE WELL LOCATION MAP.

BOX NUMBER
 E 840
 N 520
 0/5 5/5
 NORTH COORDINATE 097000
 50 51 52 53 54 55
 EAST COORDINATE 084500
 57 58 59 60 61 62 63
 ELEVATION AT WELL HEAD (FEET) 65 66 67 68
 0/0 5/0



B 5 SPECIAL CONDITIONS 8-63 (WRA USE ONLY)
 1 2 3 (SEQ. NO.) 6

114794

William E. Doyle

LAND SURVEYOR 8440

5312 EMERALD DRIVE SYKESVILLE MARYLAND 21784 PHONE (301) 795-2210

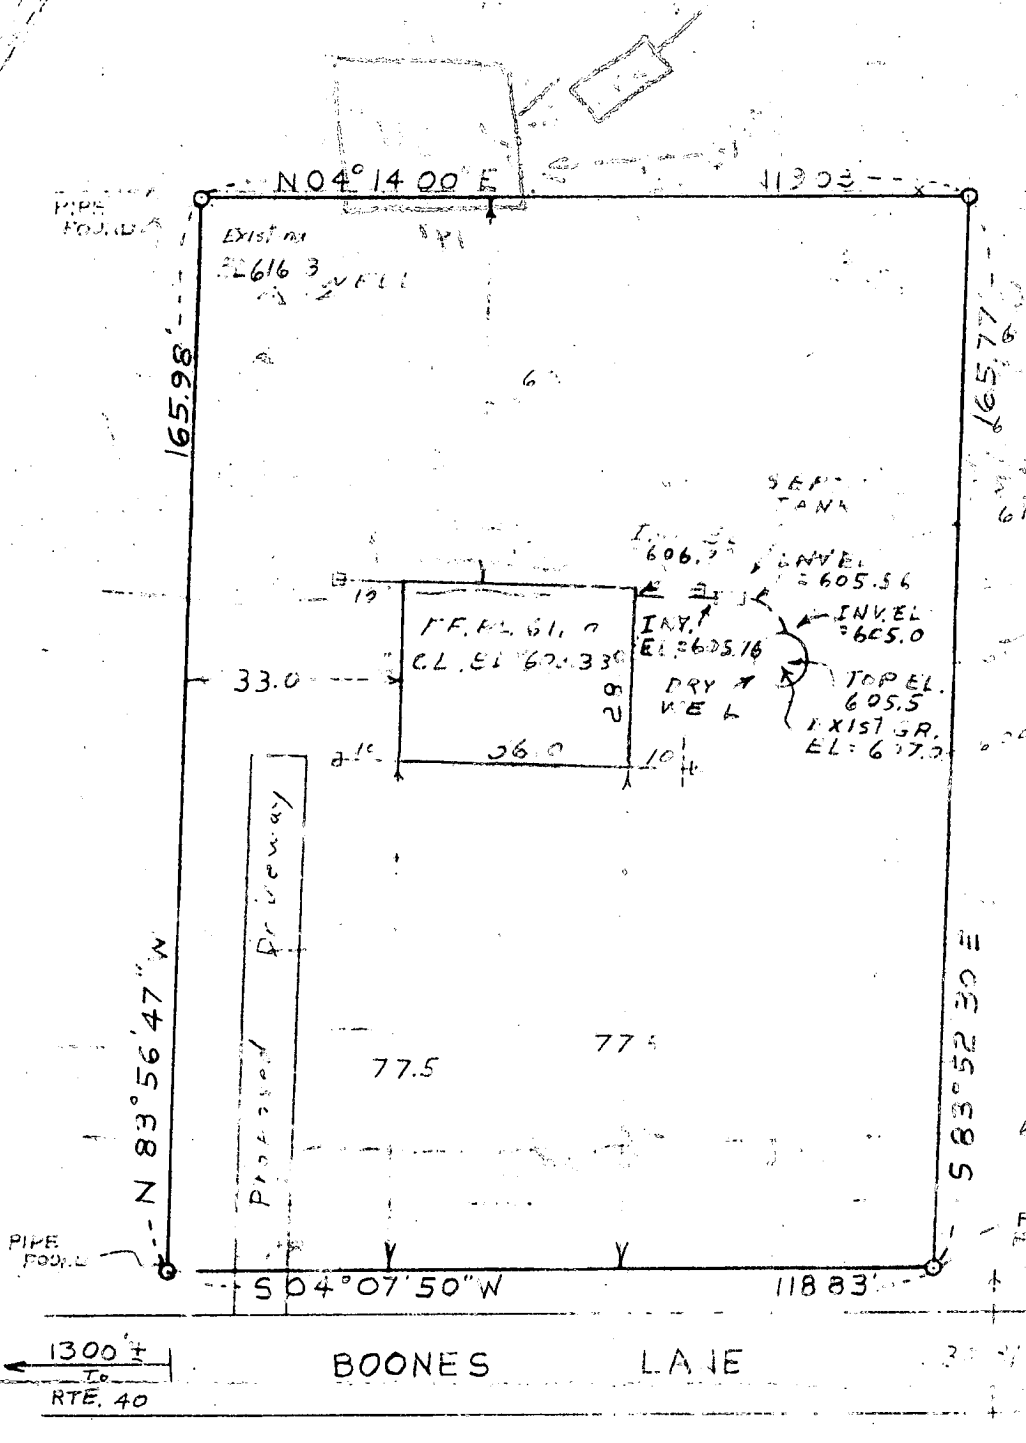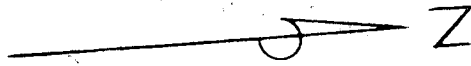

HOUSE STAKEOUT

3174 BOONES LANE
Liber: 587
Folio: 121
HOWARD CO., MD

SCALE: 1"=50'
DRAWN: NOV 25, 1978

□ - Denotes 10' Hub Sta.

WED
11/27/78
D

I certify, the above
measurements and
elevations are actual
& correct for this
property

William E. Doyle

LOCATION SURVEY


3174 BOONES LANE
 LIBER 587, FOLIO 121
 HOWARD COUNTY MD.

TAX MAP 17
 BLOCK 19
 PARCEL 124
 ZONING R-20

NORTH



N 04° 14' 00" E 119.03

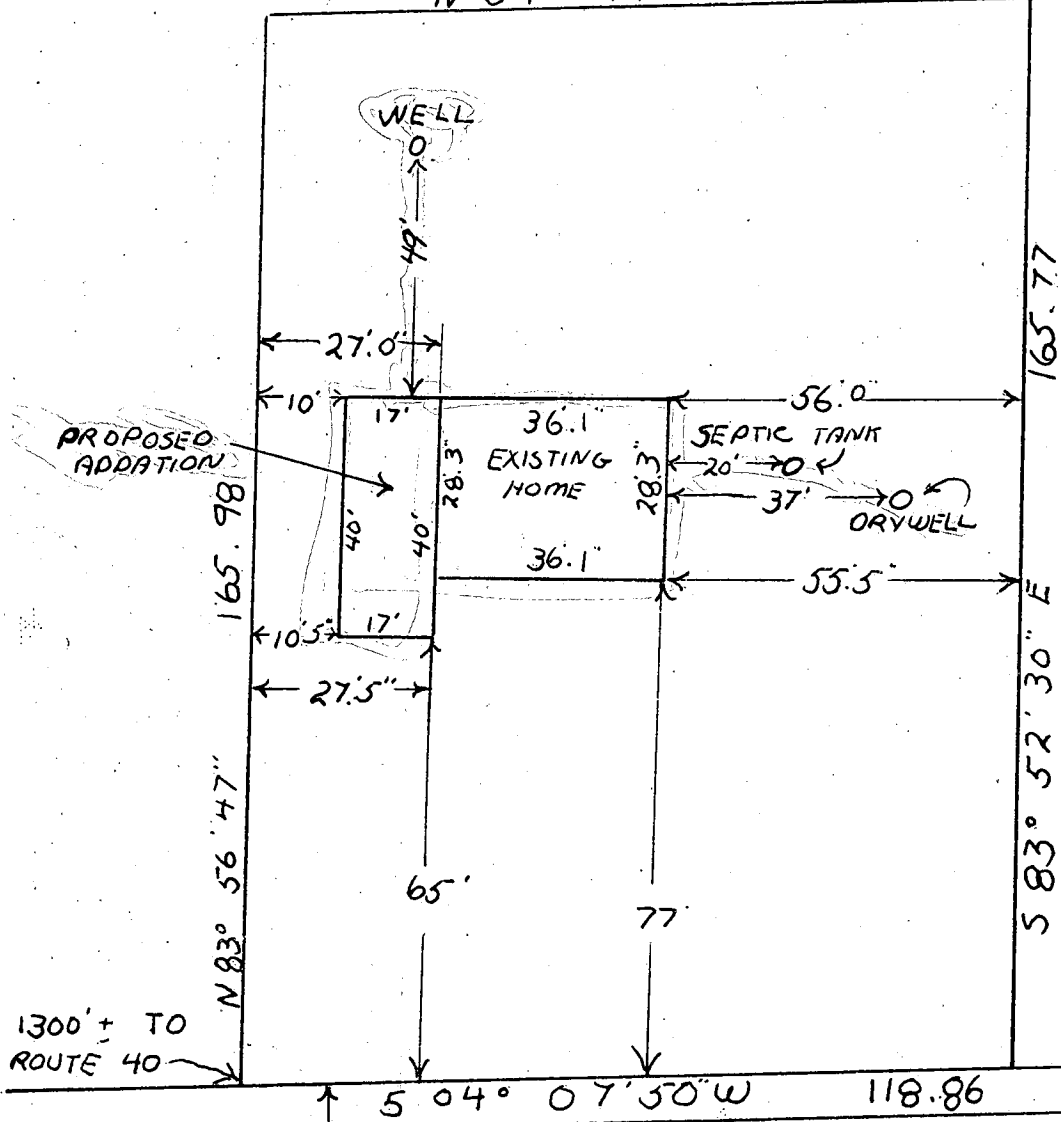

B.P. 60246
 6/15/85
 ok C.B.D.

1300' ± TO
 ROUTE 40

BOONES LANE

30'
 R/W

- ① ok as shown, C.B.D.
- ① ok per C.D. 6/13/79
 C.B.D.

SCALE 30 FT = 1 INCH

DRAWING 5 JUNE 1974
 BY JOHN HARMS

John E & Sharon E Harms
 3174 Boones Ln
 Ellicott City MD 21042-2136