

7/26/78
around 10:00 A.M.
please
7/27/78

7-27-78
P 28538

PERMIT

SEWAGE DISPOSAL SYSTEM

MARYLAND STATE DEPARTMENT OF HEALTH*

HOWARD COUNTY

02-213265
INDEXED

A _____

ELLICOTT CITY

DISTRICT 2nd

DATE 7/24/78

Roland Barth

IS PERMITTED TO INSTALL _____ ALTER

ADDRESS Clarksville Pike, Ellicott City, Md. 21043 PHONE 730-8495

SUBDIVISION _____ ROAD 9583 Old Annapolis Rd. LOT _____

PROPERTY OWNER Joe Gregory

ADDRESS 9583 Old Annapolis Road, Ellicott City, Md. 21043

SPECIFICATIONS

SEPTIC TANK CAPACITY _____ GALLONS

DRAIN FIELD _____ DEPTH _____ FEET, BOTTOM AREA _____ SQ. FT.

DEEP TRENCH _____ DEPTH _____ FEET, BOTTOM AREA _____ SQ. FT.

SEEPAGE PITS _____ ABSORBENT SIDE-WALL AREA _____ SQ. FT.

INLET PIPE _____ FT. BELOW ORIGINAL GRADE. MAXIMUM DEPTH _____ FT. BELOW ORIGINAL GRADE

EFFECTIVE DEPTH AT _____ FT. BELOW ORIGINAL GRADE.

LOCATE DISPOSAL AREA _____ FT. FROM _____ LOT LINE AND _____ FT. FROM _____ LOT LINE AS SEEN WHEN FACING LOT FROM

REPAIR - Call for an appointment when ground is opened up and Sanitarian will recommend repair system.

DITCH OFF OLD DW

45 FT LONG 2 FT WIDE 1 FT DEEP

FILLED WITH 8 FT STONE

PLANS APPROVED BY Palmer F. Wine DATE 7/24/78

COVER NO WORK UNTIL INSPECTED AND APPROVED.

NEITHER THE HOWARD COUNTY COUNCIL NOR THE HEALTH DEPARTMENT IS RESPONSIBLE FOR THE SUCCESSFUL OPERATION OF ANY SYSTEM.

NOTE: IF TRENCH IS USED CALL FOR INSPECTION BEFORE PLACING GRAVEL IN TRENCH.

NOTE: NO DRY WELL SHALL EXCEED 15 FOOT IN DIAMETER.


NOTE: ALL PIPE FROM HOUSE TO DISPOSAL AREA MUST BE CAST IRON.

PERMIT VOID AFTER THREE YEARS.

NOTE: INSTALL STAND PIPE ON SEPTIC TANK AND DRY WELL. STAND PIPES MUST BE 6 INCHES IN DIAMETER. CAST IRON, CONCRETE OR TERRA COTTA ACCEPTED.

***INSTALLER IS RESPONSIBLE FOR OBTAINING FINAL APPROVAL ON THIS PERMIT.**

P 28538

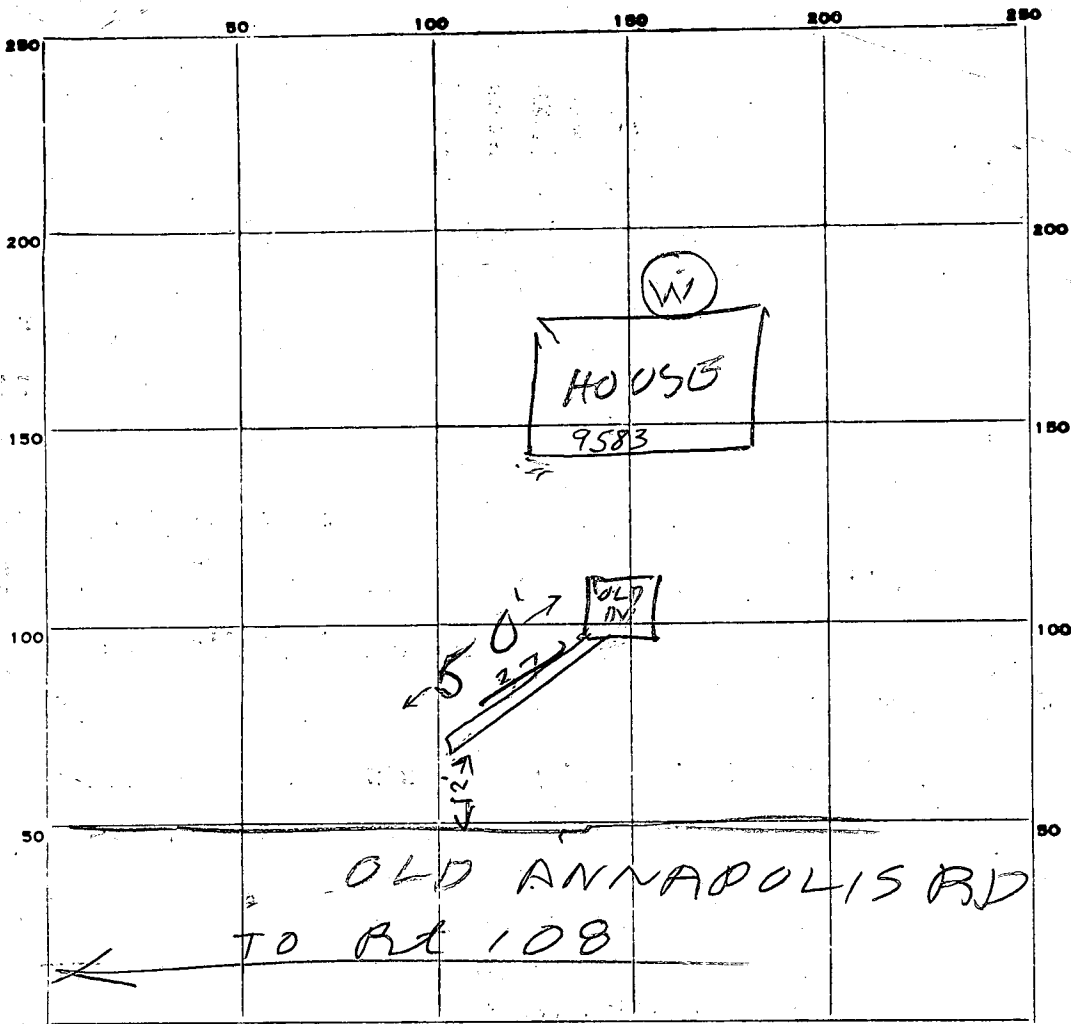

INDICATE NORTH. - NAME ADJOINING ROADWAY AS BASE LINE.

21
296
312
2
37
2
96

PERMIT CARD 02

SEPTIC TANK, LEVEL _____ CLEANOUTS _____

DISTRIBUTION BOX, LEVEL _____ 13

TILE FIELD, DEPTH 10 1/2 - 11 FT. TRENCH WIDTH 2 1/2 FT. 6.0

GRAVEL DEPTH _____ IN. TOTAL LENGTH 45 FT.

NUMBER OF TRENCHES _____ TOTAL BOTTOM AREA _____

SEEPAGE PITS, INSIDE DIAMETER _____ FT. DEPTH BELOW INLET _____ FT. 7/26-8

ABSORBENT AREA _____ SQ. FT.

REMARKS 7/26/78 AM - DITCH 18 FT deep 37 ft long
Top 3 FT Clay Bot 8 FT SAND. INLET TO
DITCH TO BE 3 FT BELOW GRADE LENGTH DITCH 8 FT
ADD STONE & CALL FOR REINSPECTION RH
7/26/78 PM - Need more stone RH

DATE SYSTEM APPROVED 7/27/78 INSPECTOR W. Menaghan